


LEGEND FOR STERN TRACT
 Workings by Stern Coal Co. plotted as of
 December 1, 1930. — PLAIN BLACK
 Workings by South Union Coal Co.
 up to Oct. 1, 1931 (overlain)

by Acres released by South Union
 sold to Samuel Stern & Leo Stern
 Joint survey of Nov. 1918 by L.C. Macbling
 for Stern Coal Co. and H.S. Harrop for
 Thaw Coke Trust shown by red figures.

Encroachment #28, 7ches
 Encroachment #21 - a widening
 into the Stern Coal Co. lease
 Nov. 1923, 28 1/2 feet of coal
 sold to South Union
 Coal Co. Jan. 20, 1926.

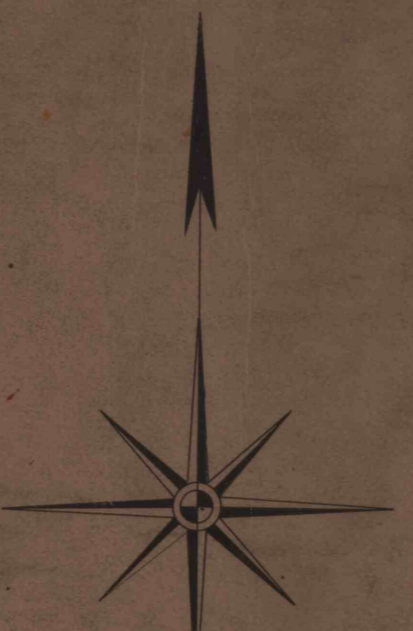

MINE MAP OF SOUTH UNION TRACT ESTATE OF WILLIAM THAW DEC'D "COKE TRUST" SITUATE IN SOUTH UNION TOWNSHIP FAYETTE COUNTY PA.

SCALE 1"=400'

HARROP, HOPKINS & TAYLOR
 CIVIL AND MINING ENGINEERS
 604 1/2 PENN. BANK
 PITTSBURGH
 PA.

NOV. 1918

THAW COKE TRUST BOUNDARY LINE
 RESERVATIONS
 W. J. RAINEY EST. LEASE
 SOUTH UNION COAL CO. (Wm. Harrison) LEASE

WORKINGS UP TO JAN. 1ST 1913	WORKINGS UP TO JAN. 1ST 1940
JAN - 1914	WORKINGS UP TO JAN. 1ST 1941
JAN - 1915	WORKINGS UP TO JAN. 1ST 1942
JAN - 1916	WORKINGS UP TO JAN. 1ST 1943
JAN - 1917	STRIPPINGS " " " "
JAN - 1918	STRIPPINGS " " " "
JAN - 1919	STRIPPINGS " " " "
JAN - 1920	STRIPPINGS " " " "
JAN - 1921	STRIPPINGS " " " "
JAN - 1922	STRIPPINGS " " " "
JAN - 1923	STRIPPINGS " " " "
JAN - 1924	STRIPPINGS " " " "
JAN - 1925	STRIPPINGS " " " "
JAN - 1926	STRIPPINGS " " " "
JAN - 1927	STRIPPINGS " " " "
JAN - 1928	STRIPPINGS " " " "
JAN - 1929	STRIPPINGS " " " "
JAN - 1930	STRIPPINGS " " " "
JAN - 1931	STRIPPINGS " " " "
JAN - 1932	STRIPPINGS " " " "
JAN - 1933	STRIPPINGS " " " "
JAN - 1934	STRIPPINGS " " " "
JAN - 1935	STRIPPINGS " " " "
JAN - 1936	STRIPPINGS " " " "
JAN - 1937	STRIPPINGS " " " "
JAN - 1938	STRIPPINGS " " " "
JAN - 1939	STRIPPINGS " " " "

