



- ACTIVE OIL WELL
- ABANDONED OIL WELL
- * ACTIVE GAS WELL
- * ABANDONED GAS WELL
- * ACTIVE OIL & GAS WELL
- * ABANDONED OIL & GAS WELL
- ◇ DRY HOLE
- NO RECORD


- COUNTY LINES
- TOWNSHIP LINES
- BOROUGH LINES
- COAL CONTOURS
- CROP LINES - SEAM BEING MINED
- CROP LINES - SEAMS NOT BEING MINED

Amity 3.

Amity 5.

NOTE - WAYNESBURG COAL CONTOURS ARE DERIVED BY ADDING 325 FEET TO PITTSBURGH COAL CONTOURS.

- Y DRIFT OPENING
- Z SLOPE OPENING
- SHAFTS
- ▨ BARRIER PILLAR

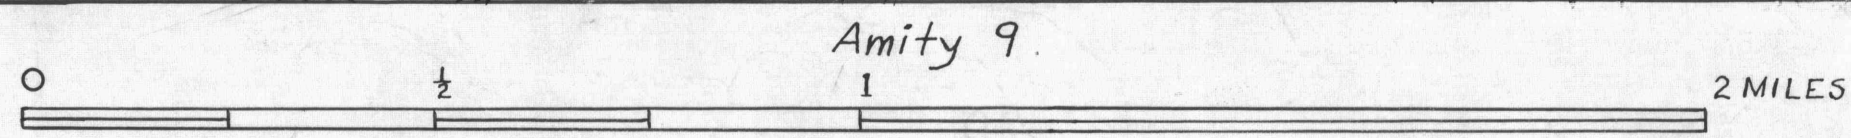

W.P.A. PROJECT NO. 19666

AMITY SHEET NO. 6
WAYNESBURG SEAM

AMITY 6 Wb Seam