


Barnesboro 4 78°55' 40°35'

- ACTIVE OIL WELL
- * ACTIVE OIL & GAS WELL
- ◐ ABANDONED OIL WELL
- * ABANDONED OIL & GAS WELL
- * ACTIVE GAS WELL
- ◐ DRY HOLE
- * ABANDONED GAS WELL
- NO RECORD

Barnesboro 5

- COUNTY LINES
- COAL CONTOURS
- - - TOWNSHIP LINES
- - - CROP LINES - SEAM BEING MINED
- - - BOROUGH LINES
- - - CROP LINES - SEAMS NOT BEING MINED

78°50' 40°35' Barnesboro 6

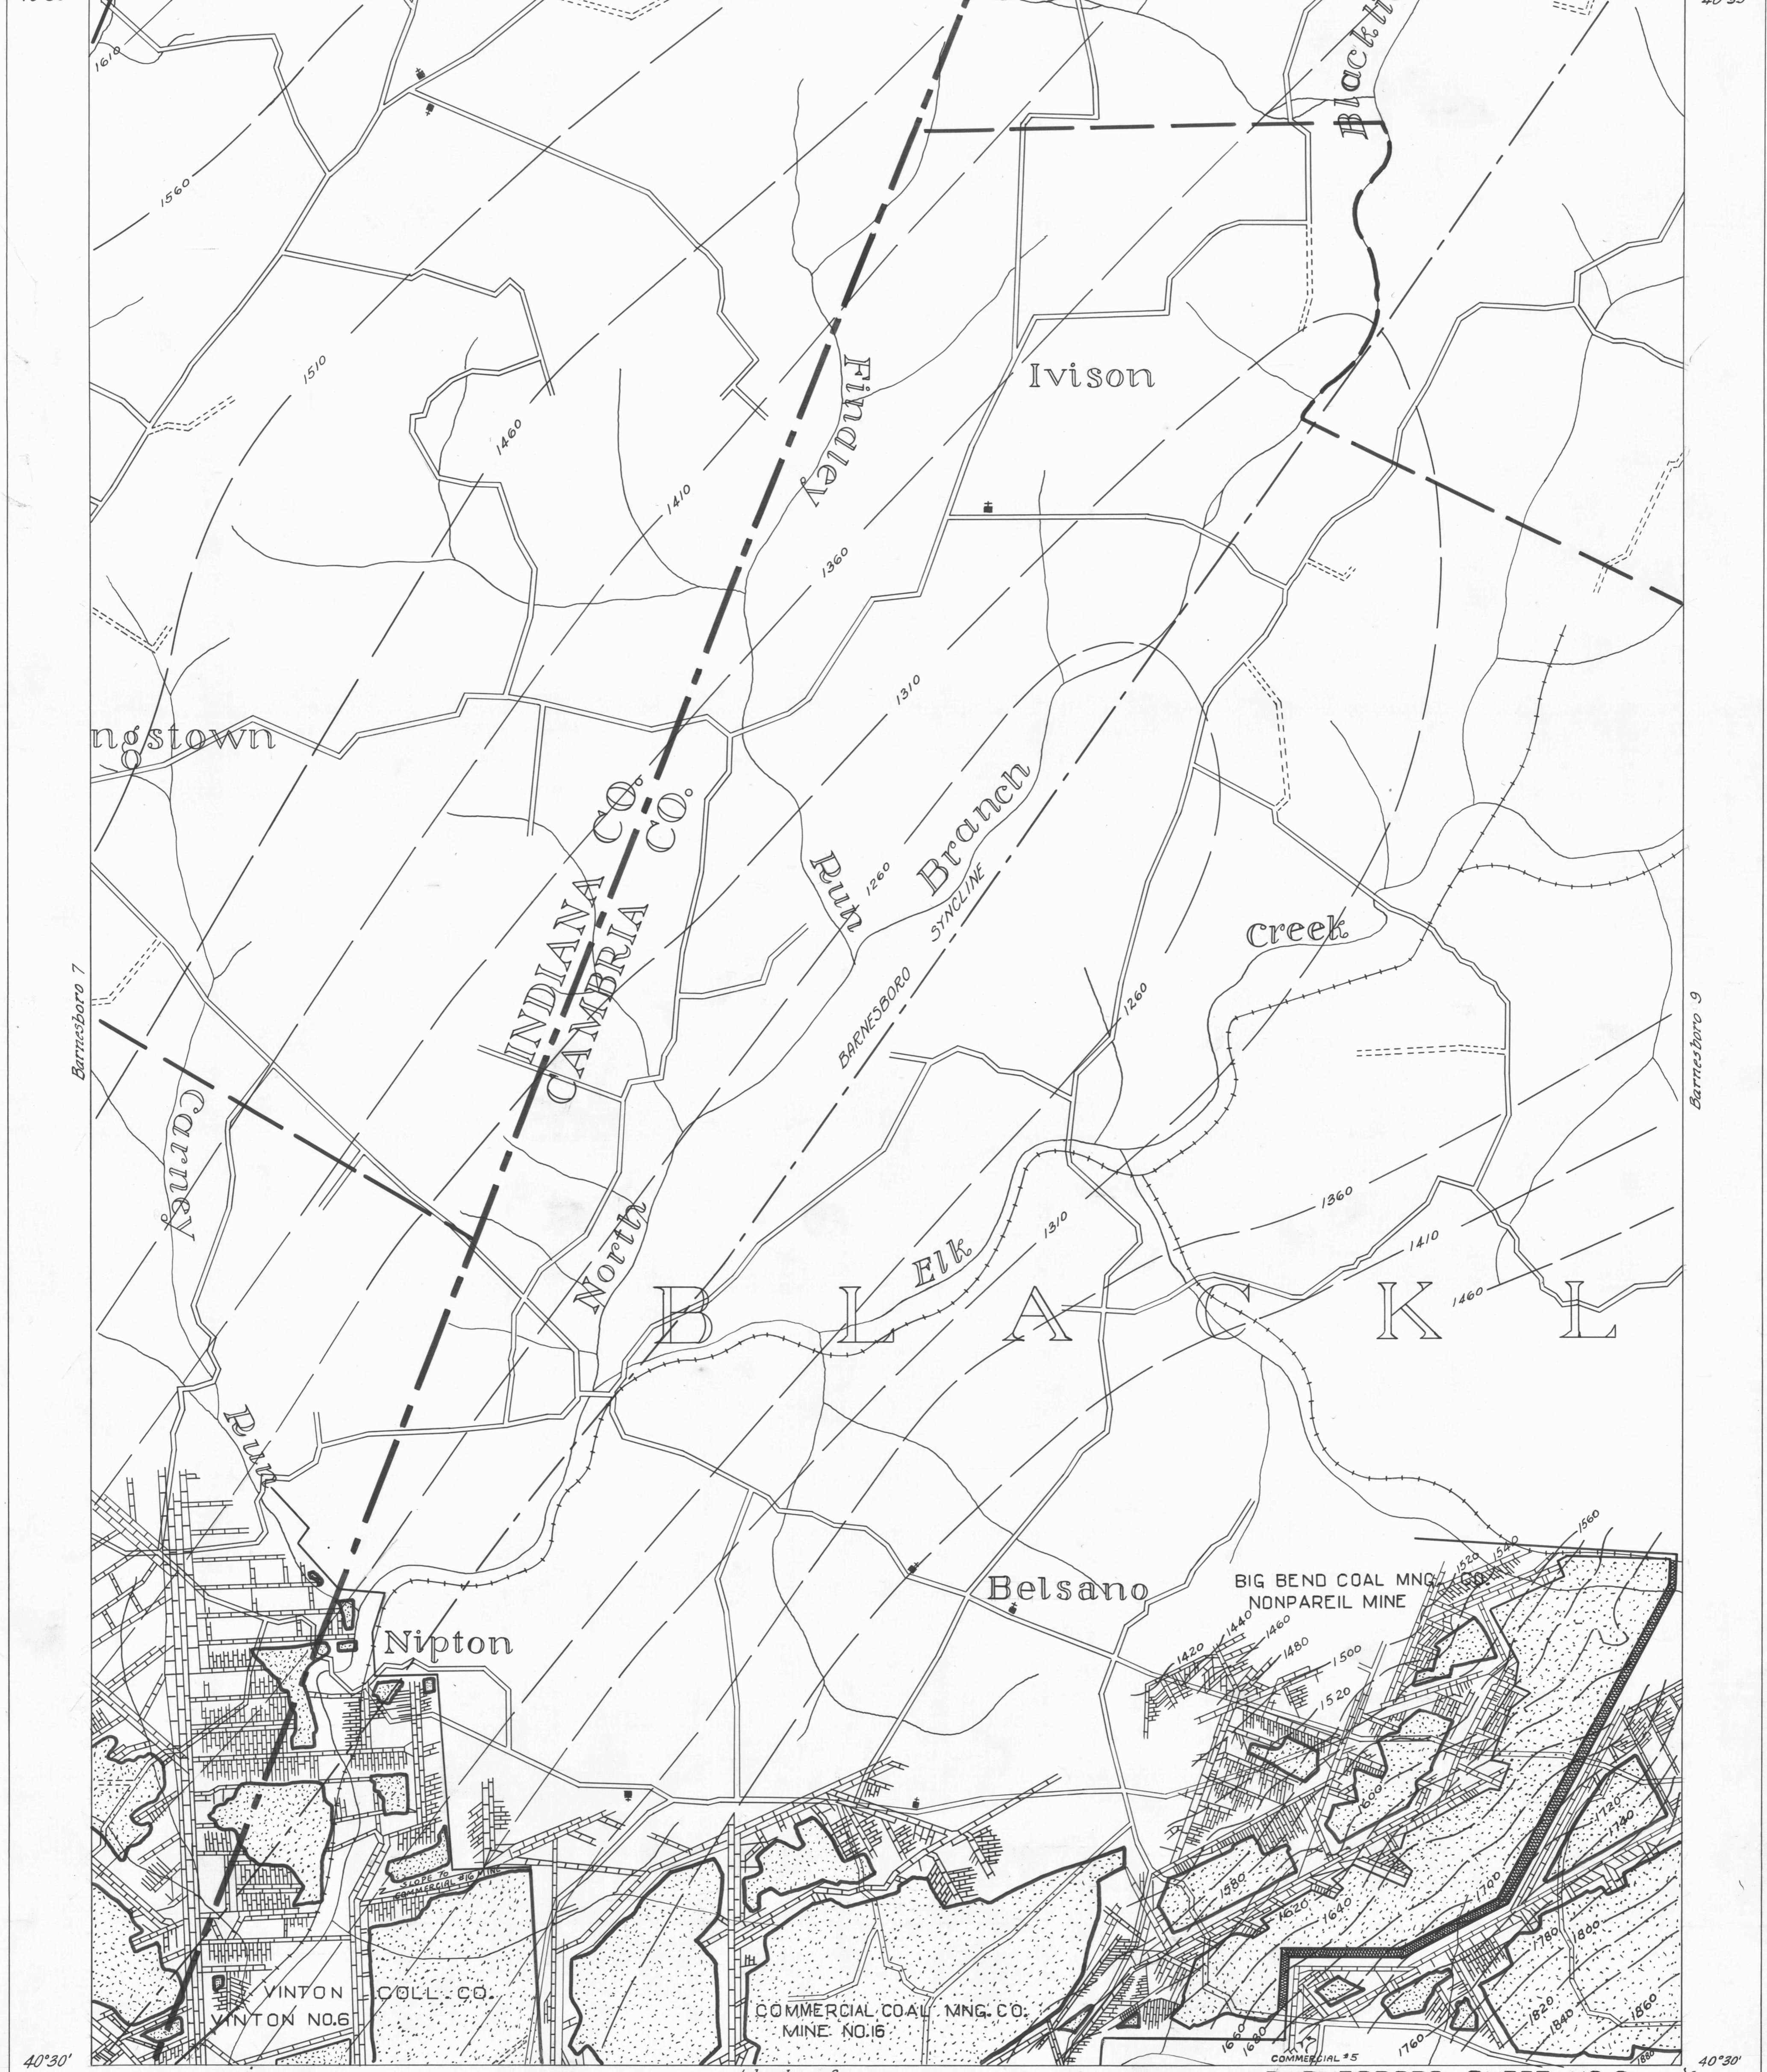

Johnstown 1 78°55' 40°30'

- Y DRIFT OPENING
- Z SLOPE OPENING
- SHAFTS
- BARRIER PILLAR

Johnstown 2

0 1 2 MILES

W.P.A. PROJECT NO.19666

BARNESBORO SHEET NO.8
LOWER KITTANNING SEAM - IK
78°50' 40°30' Johnstown 3

notes