


Meyersdale 3 39° 55' Berlin 1

COUNTY LINES  
TOWNSHIP LINES  
BOROUGH LINES  
COAL CONTOURS  
CROP LINES—SEAM BEING MINED  
CROP LINES—SEAMS NOT BEING MINED

Berlin 2 39° 55'

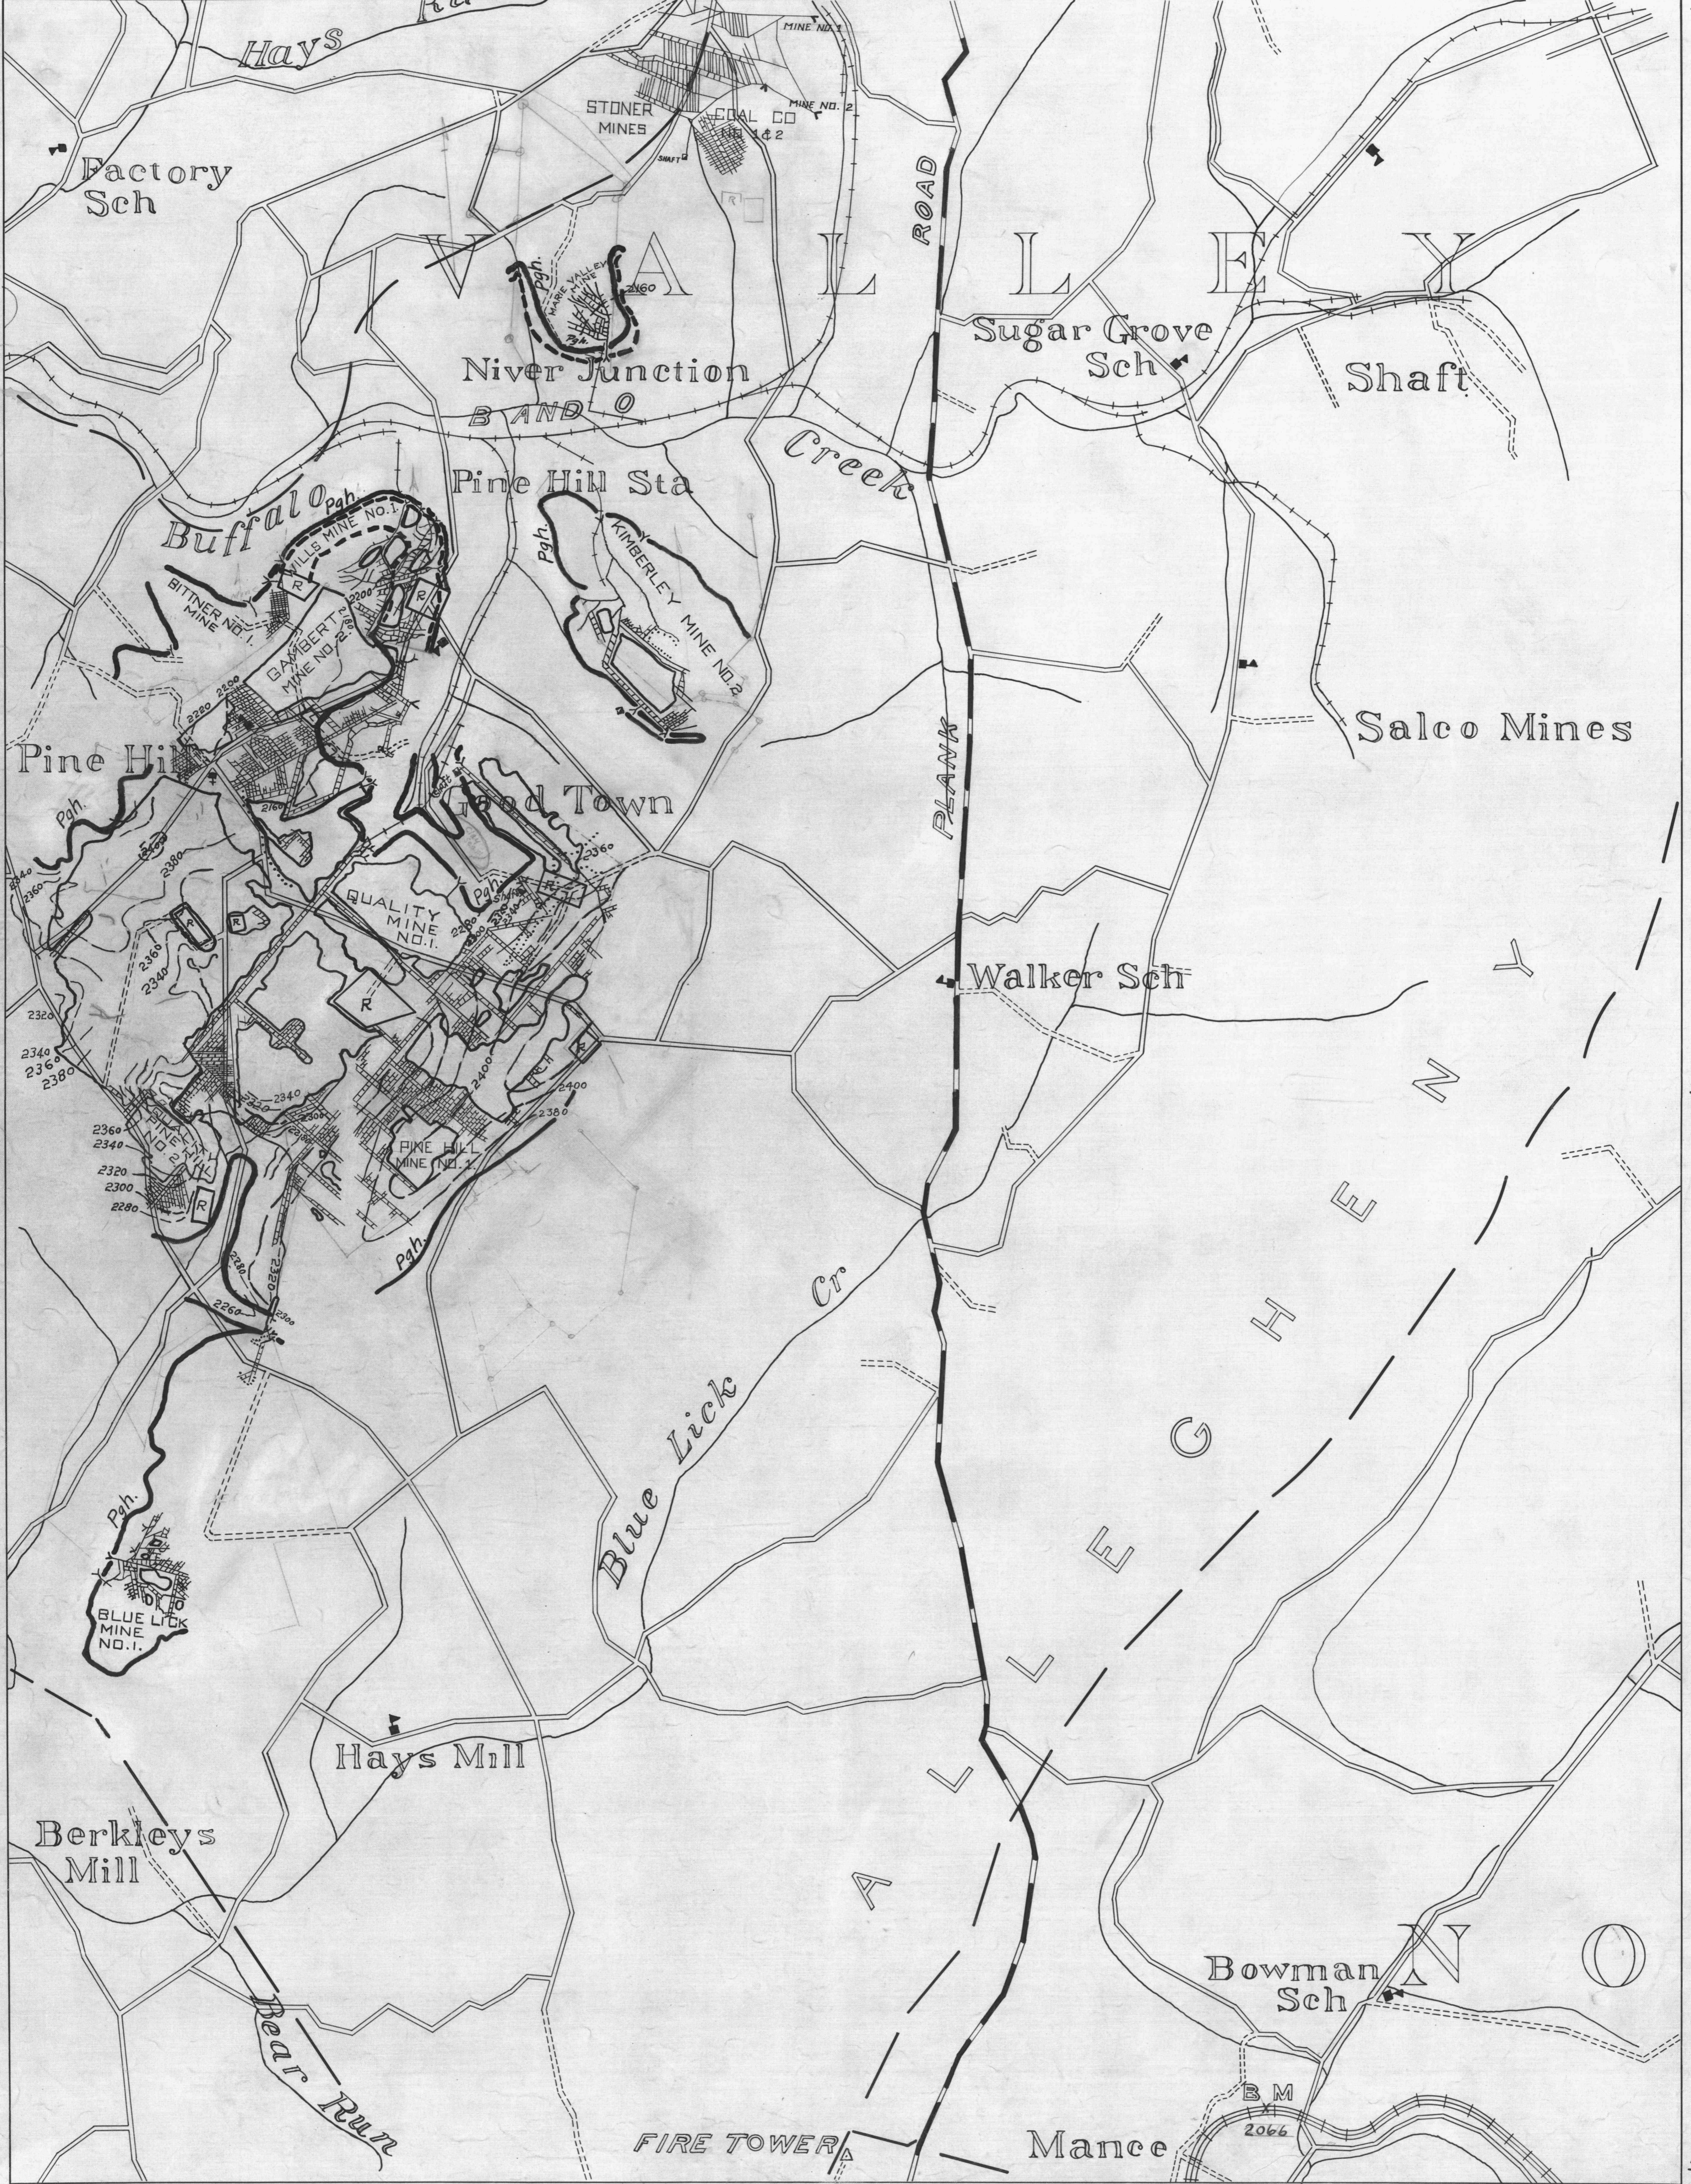

Meyersdale 6

Berlin 5

Meyersdale 9 39° 50'

Berlin 8 39° 50'

MINE MAP DEPARTMENT 1936

0 1/2 1 2 MILES.  
W.P.A. PROJECT NO 65-23-5001 & NO 465-23-3-192.

BERLIN SHEET No 4  
PITTSBURGH SEAM-pgh.