


MYERSDALE 3
39° 55'

Berlin 1

78-55'
Berlin 2
39° 55'

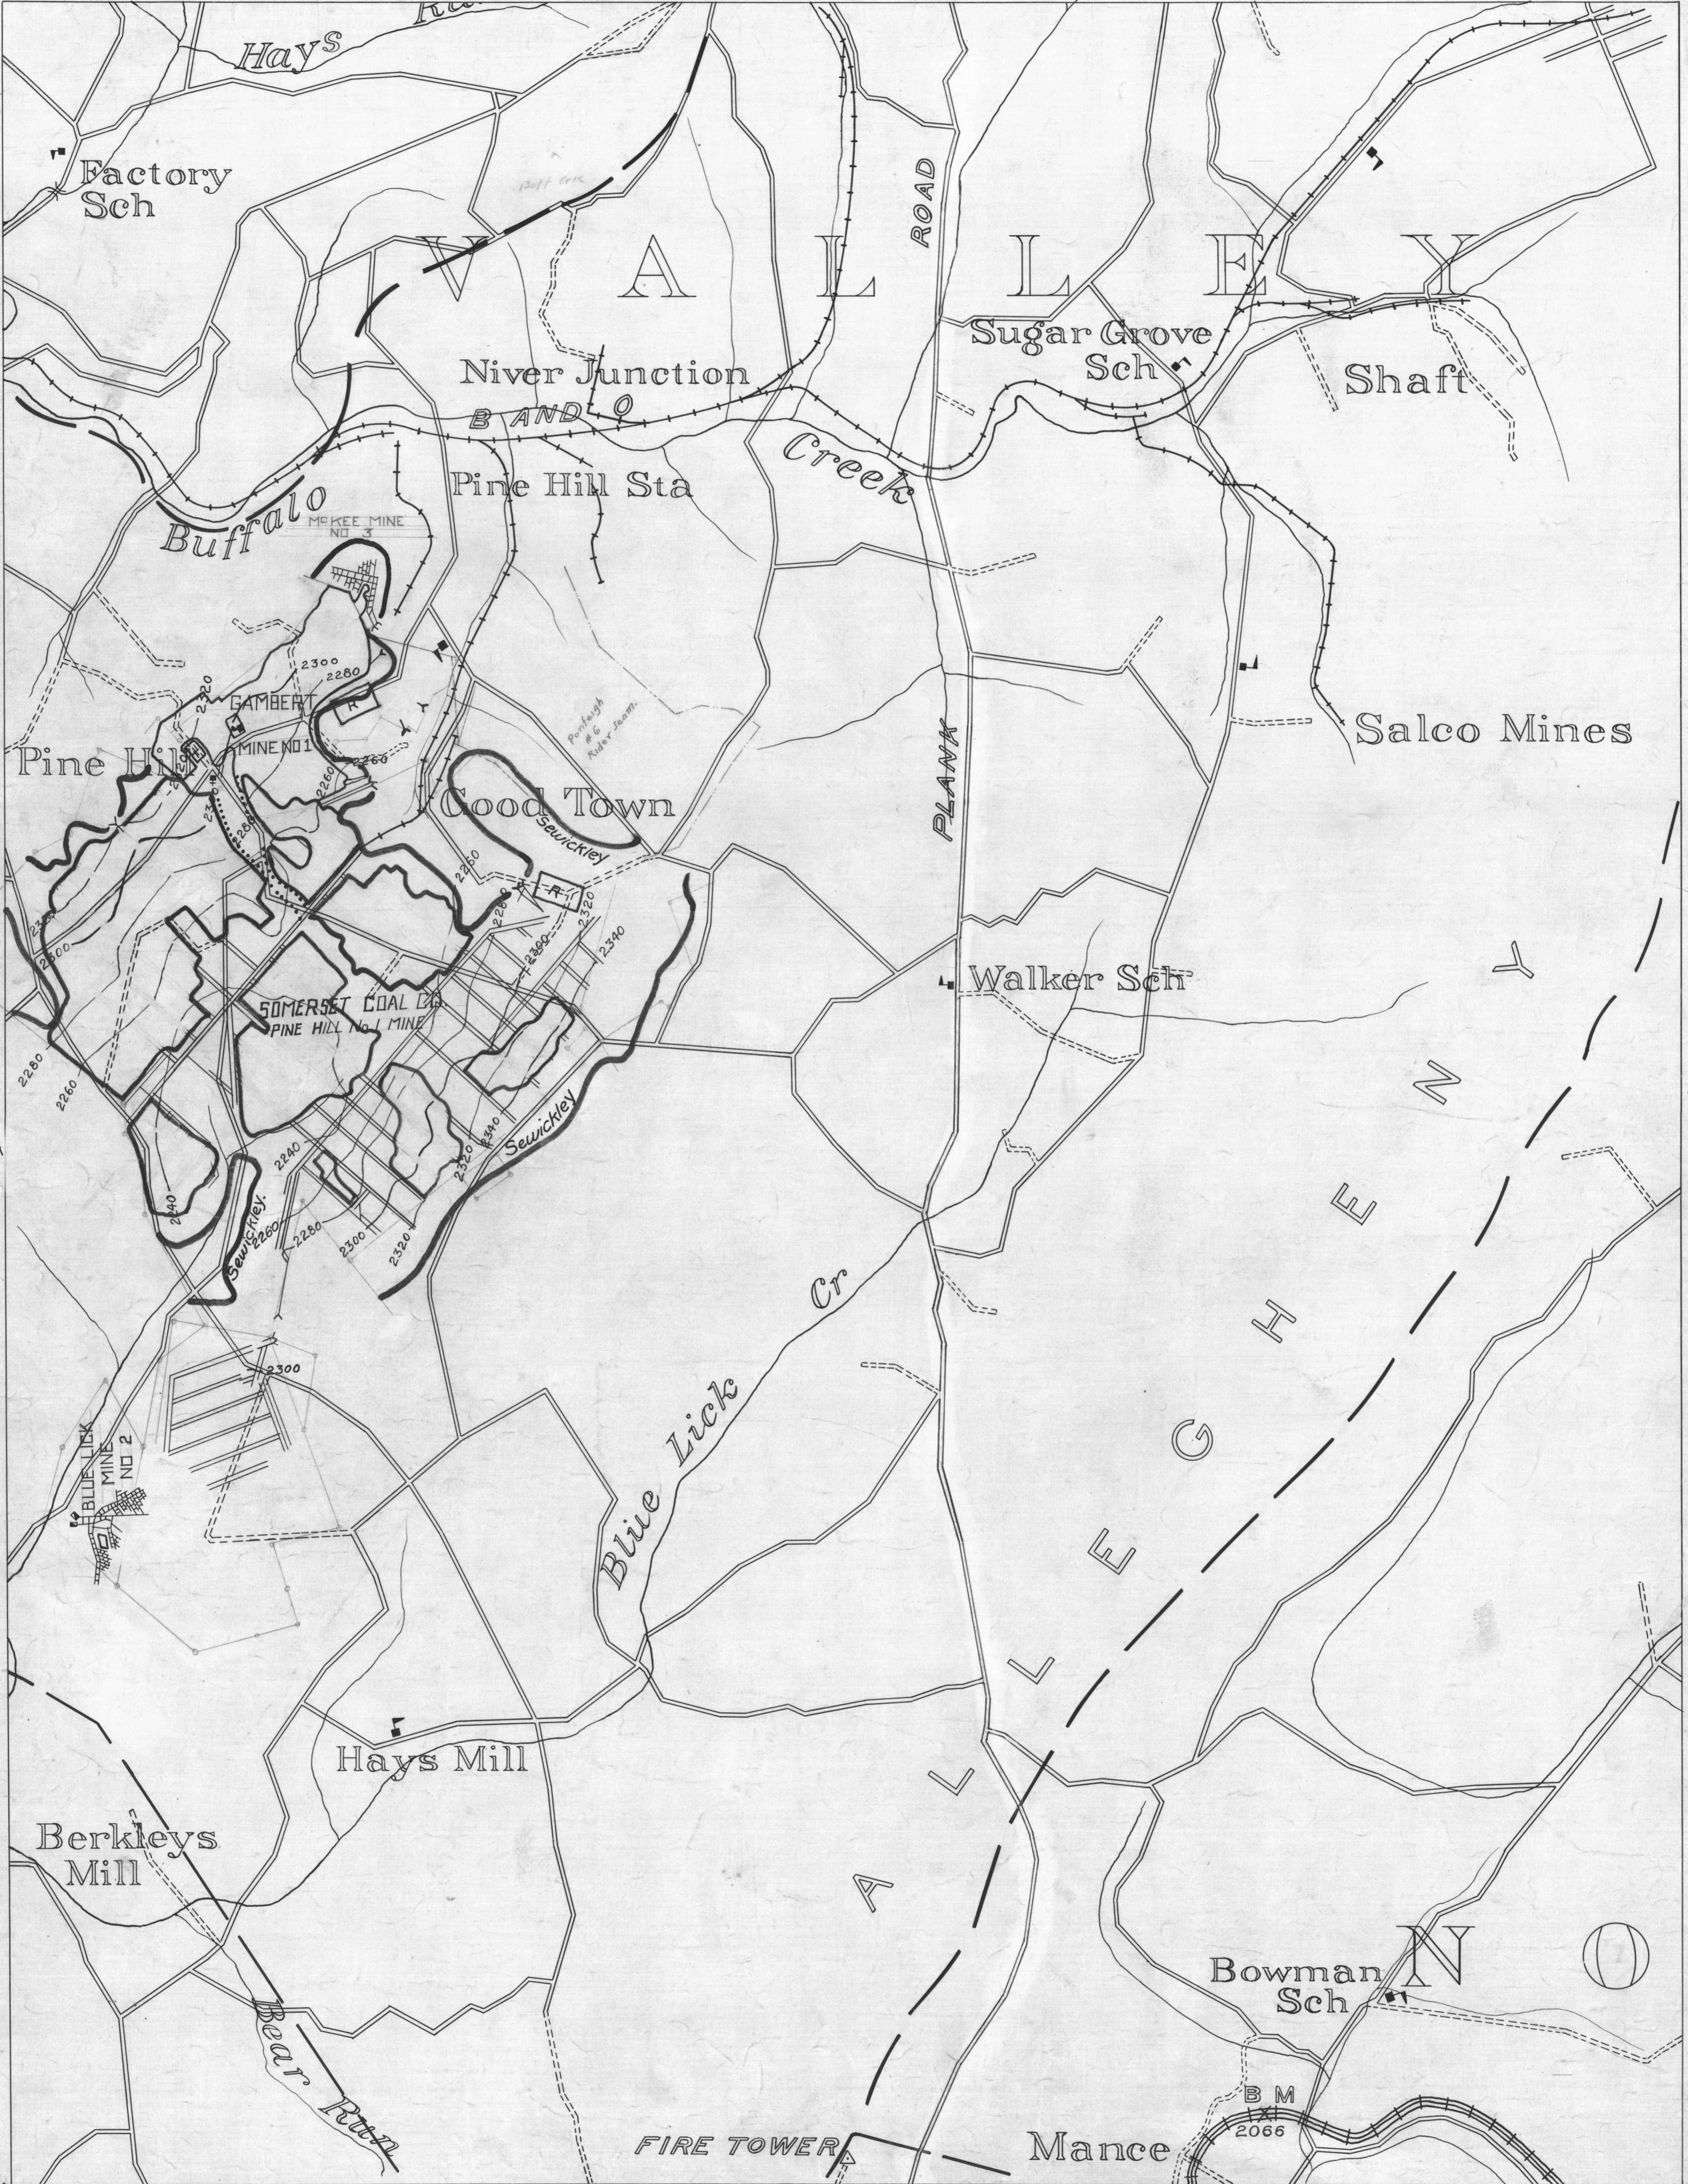


MYERSDALE 3
39° 50'

Berlin 7

78-55'
Berlin 8
39° 50'

MINE MAP DEPARTMENT 1934

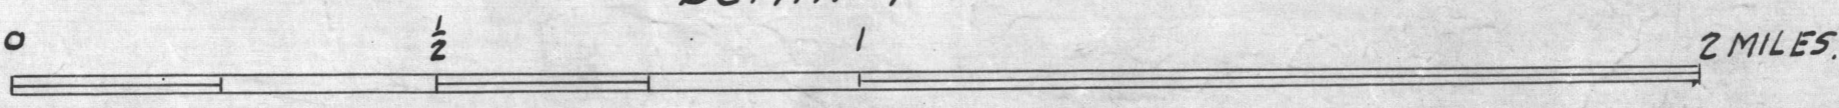

BERLIN SHEET No. 4
SEWICKLEY COAL