


Bitumen 2
41°25'

- ACTIVE OIL WELL
- ◊ ABANDONED OIL WELL
- * ACTIVE GAS WELL
- * ABANDONED GAS WELL
- * ACTIVE OIL & GAS WELL
- * ABANDONED OIL & GAS WELL
- ◊ DRY HOLE
- ◊ NO RECORD

- COUNTY LINES
- TOWNSHIP LINES
- BOROUGH LINES
- 980- COAL CONTOURS
- CROP LINES-SEAMS BEING MINED
- CROP LINES-SEAMS NOT BEING MINED

77°45'
Hyler 1
41°25'

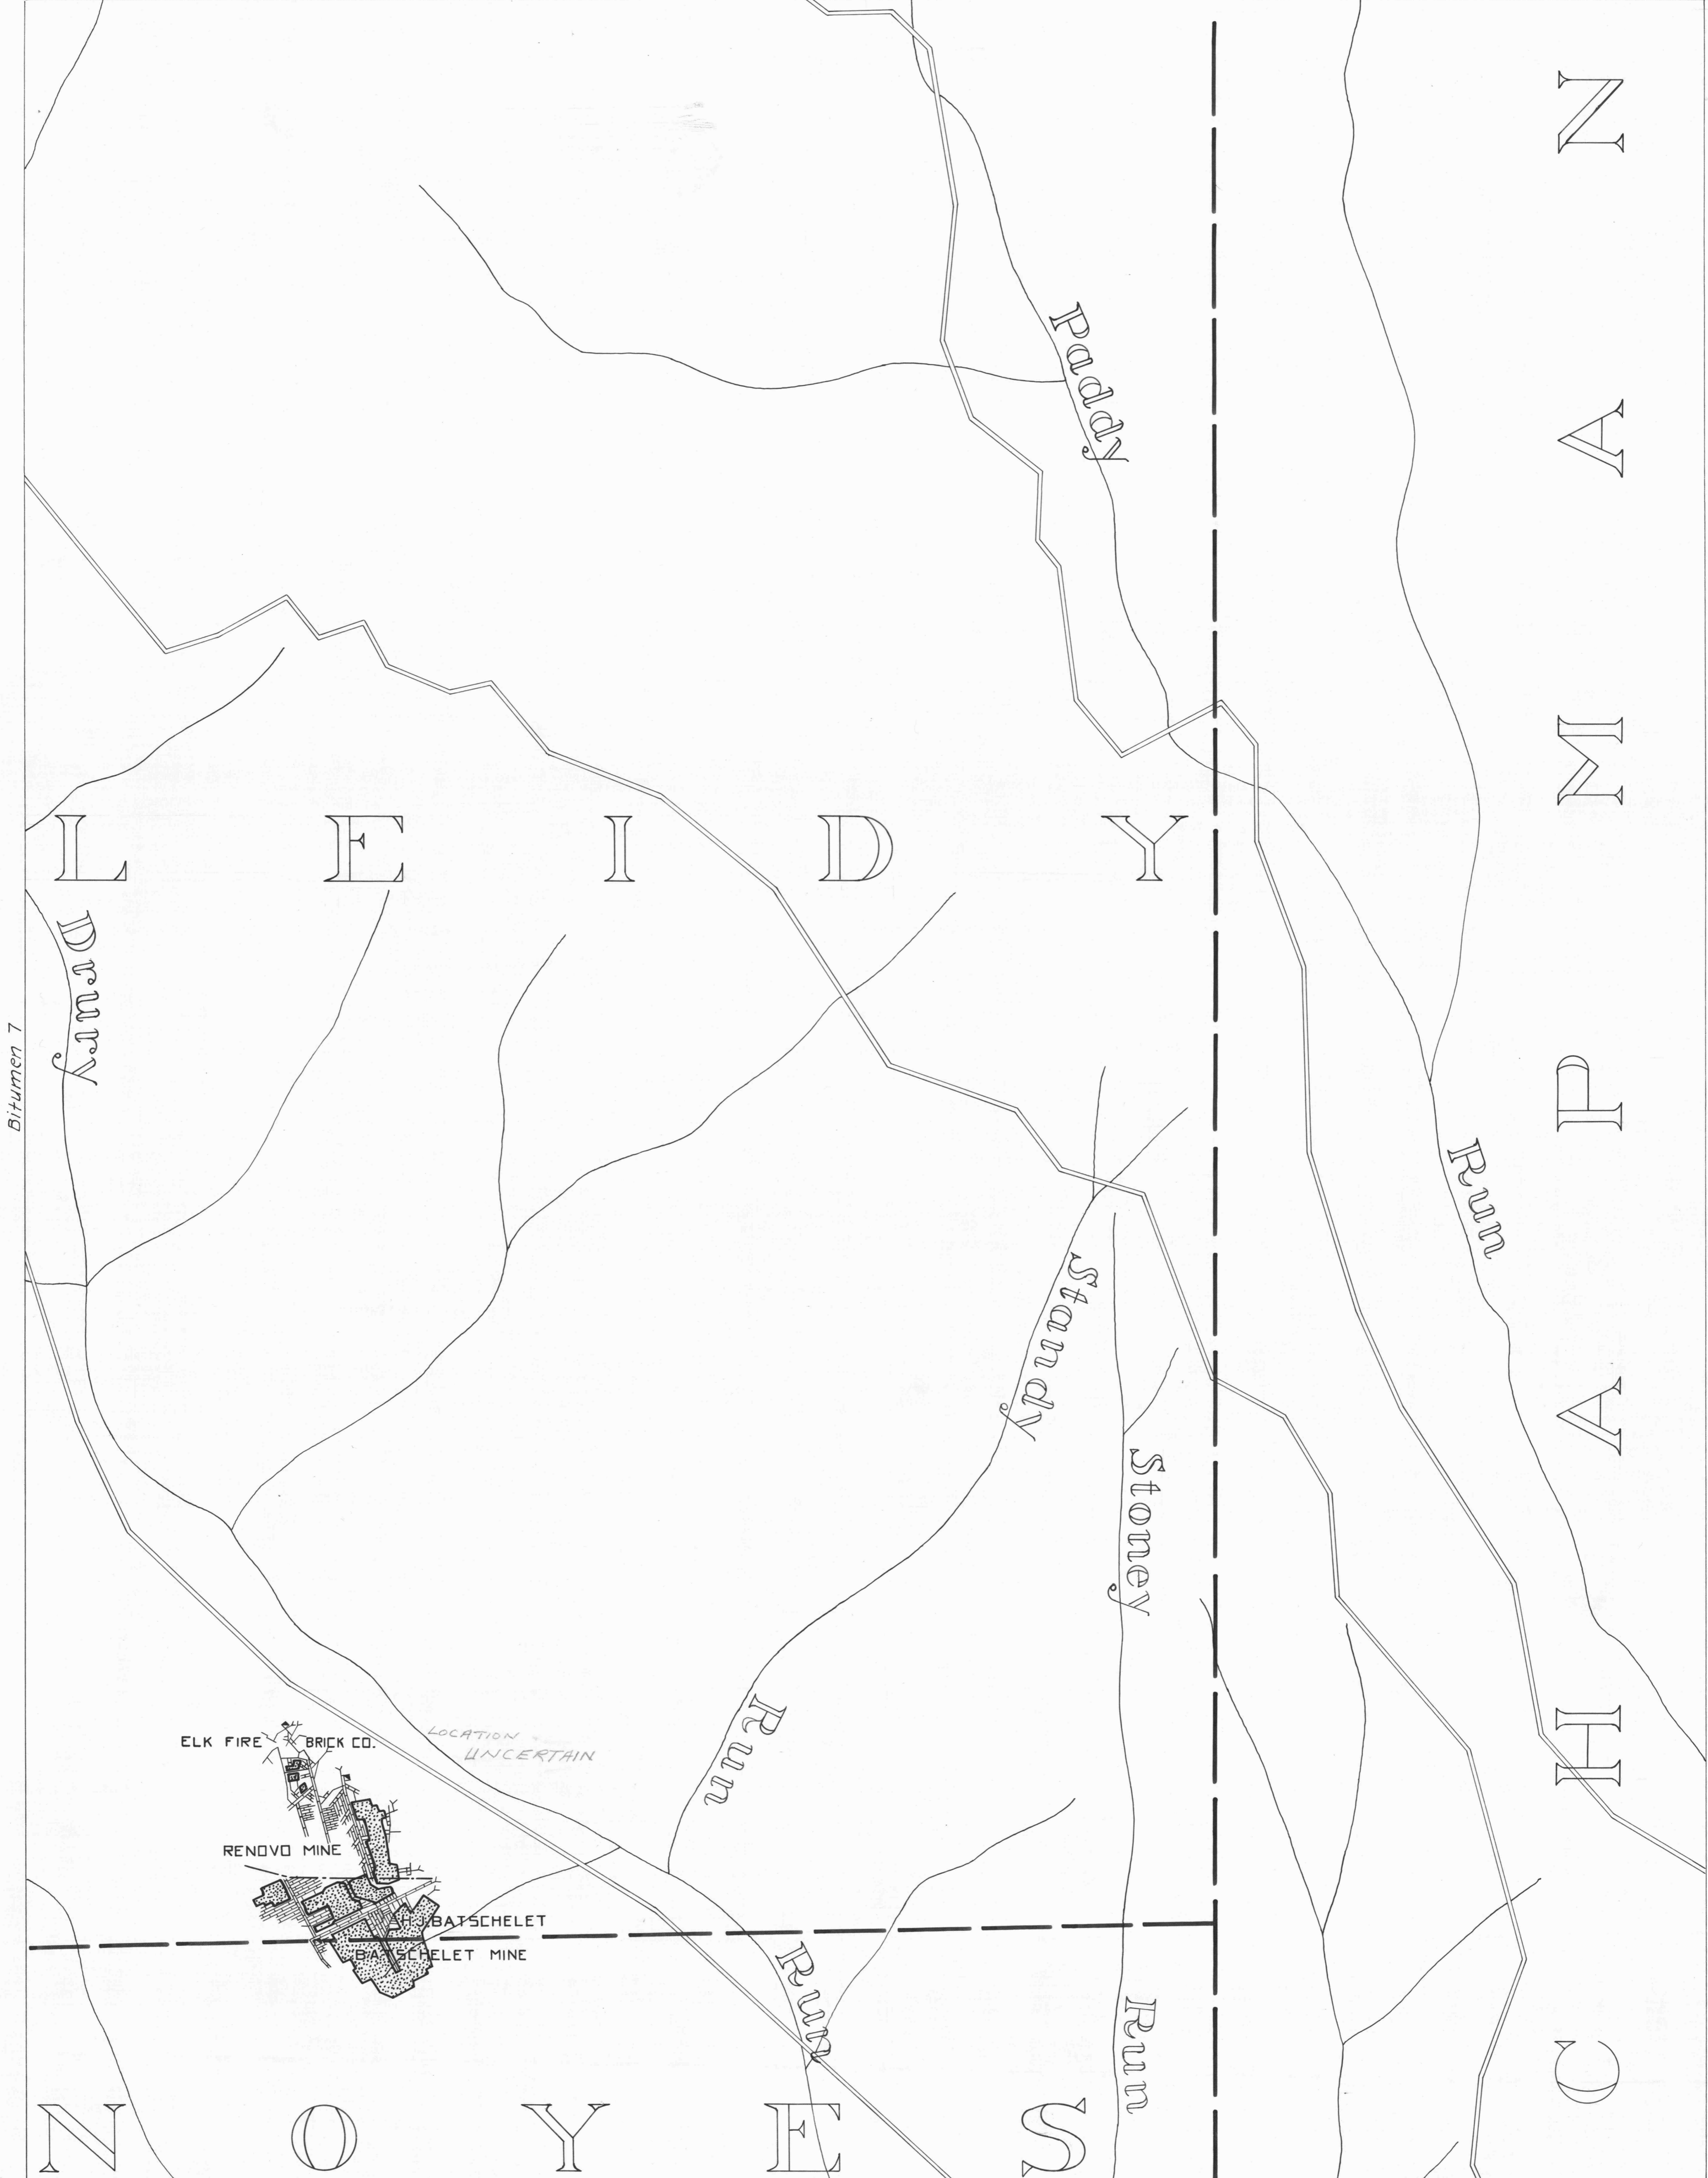

41°20'
Bitumen 8
77°50'

- DRIFT OPENING
- SLOPE OPENING
- SHAFTS
- ▨ BARRIER PILLAR

Bitumen 9 TOPOGRAPHY FROM U.S. ARMY 1941

BITUMEN SHEET NO. 6
77°45'
Hyler 7
41°20'

THIS SHEET PREPARED FROM U.S. ARMY ENGINEERS CORPS TACTICAL MAP AND IS NOT ACCURATE

W.P.A. PROJECT NO 4483

BROOKVILLE SEAM - br

