


Bitumen 5 77°50' 41°20' Bitumen 6 Bitumen 7 77°45' 41°20'

- ACTIVE OIL WELL
- ABANDONED OIL WELL
- ⊛ ACTIVE GAS WELL
- ⊛ ABANDONED GAS WELL
- ★ ACTIVE OIL & GAS WELL
- ★ ABANDONED OIL & GAS WELL
- ⊠ DRY HOLE
- NO RECORD
- COUNTY LINES
- TOWNSHIP LINES
- BOROUGH LINES
- - - COAL CONTOURS
- - - CROP LINES - SEAMS BEING MINED
- - - CROP LINES - SEAMS NOT BEING MINED

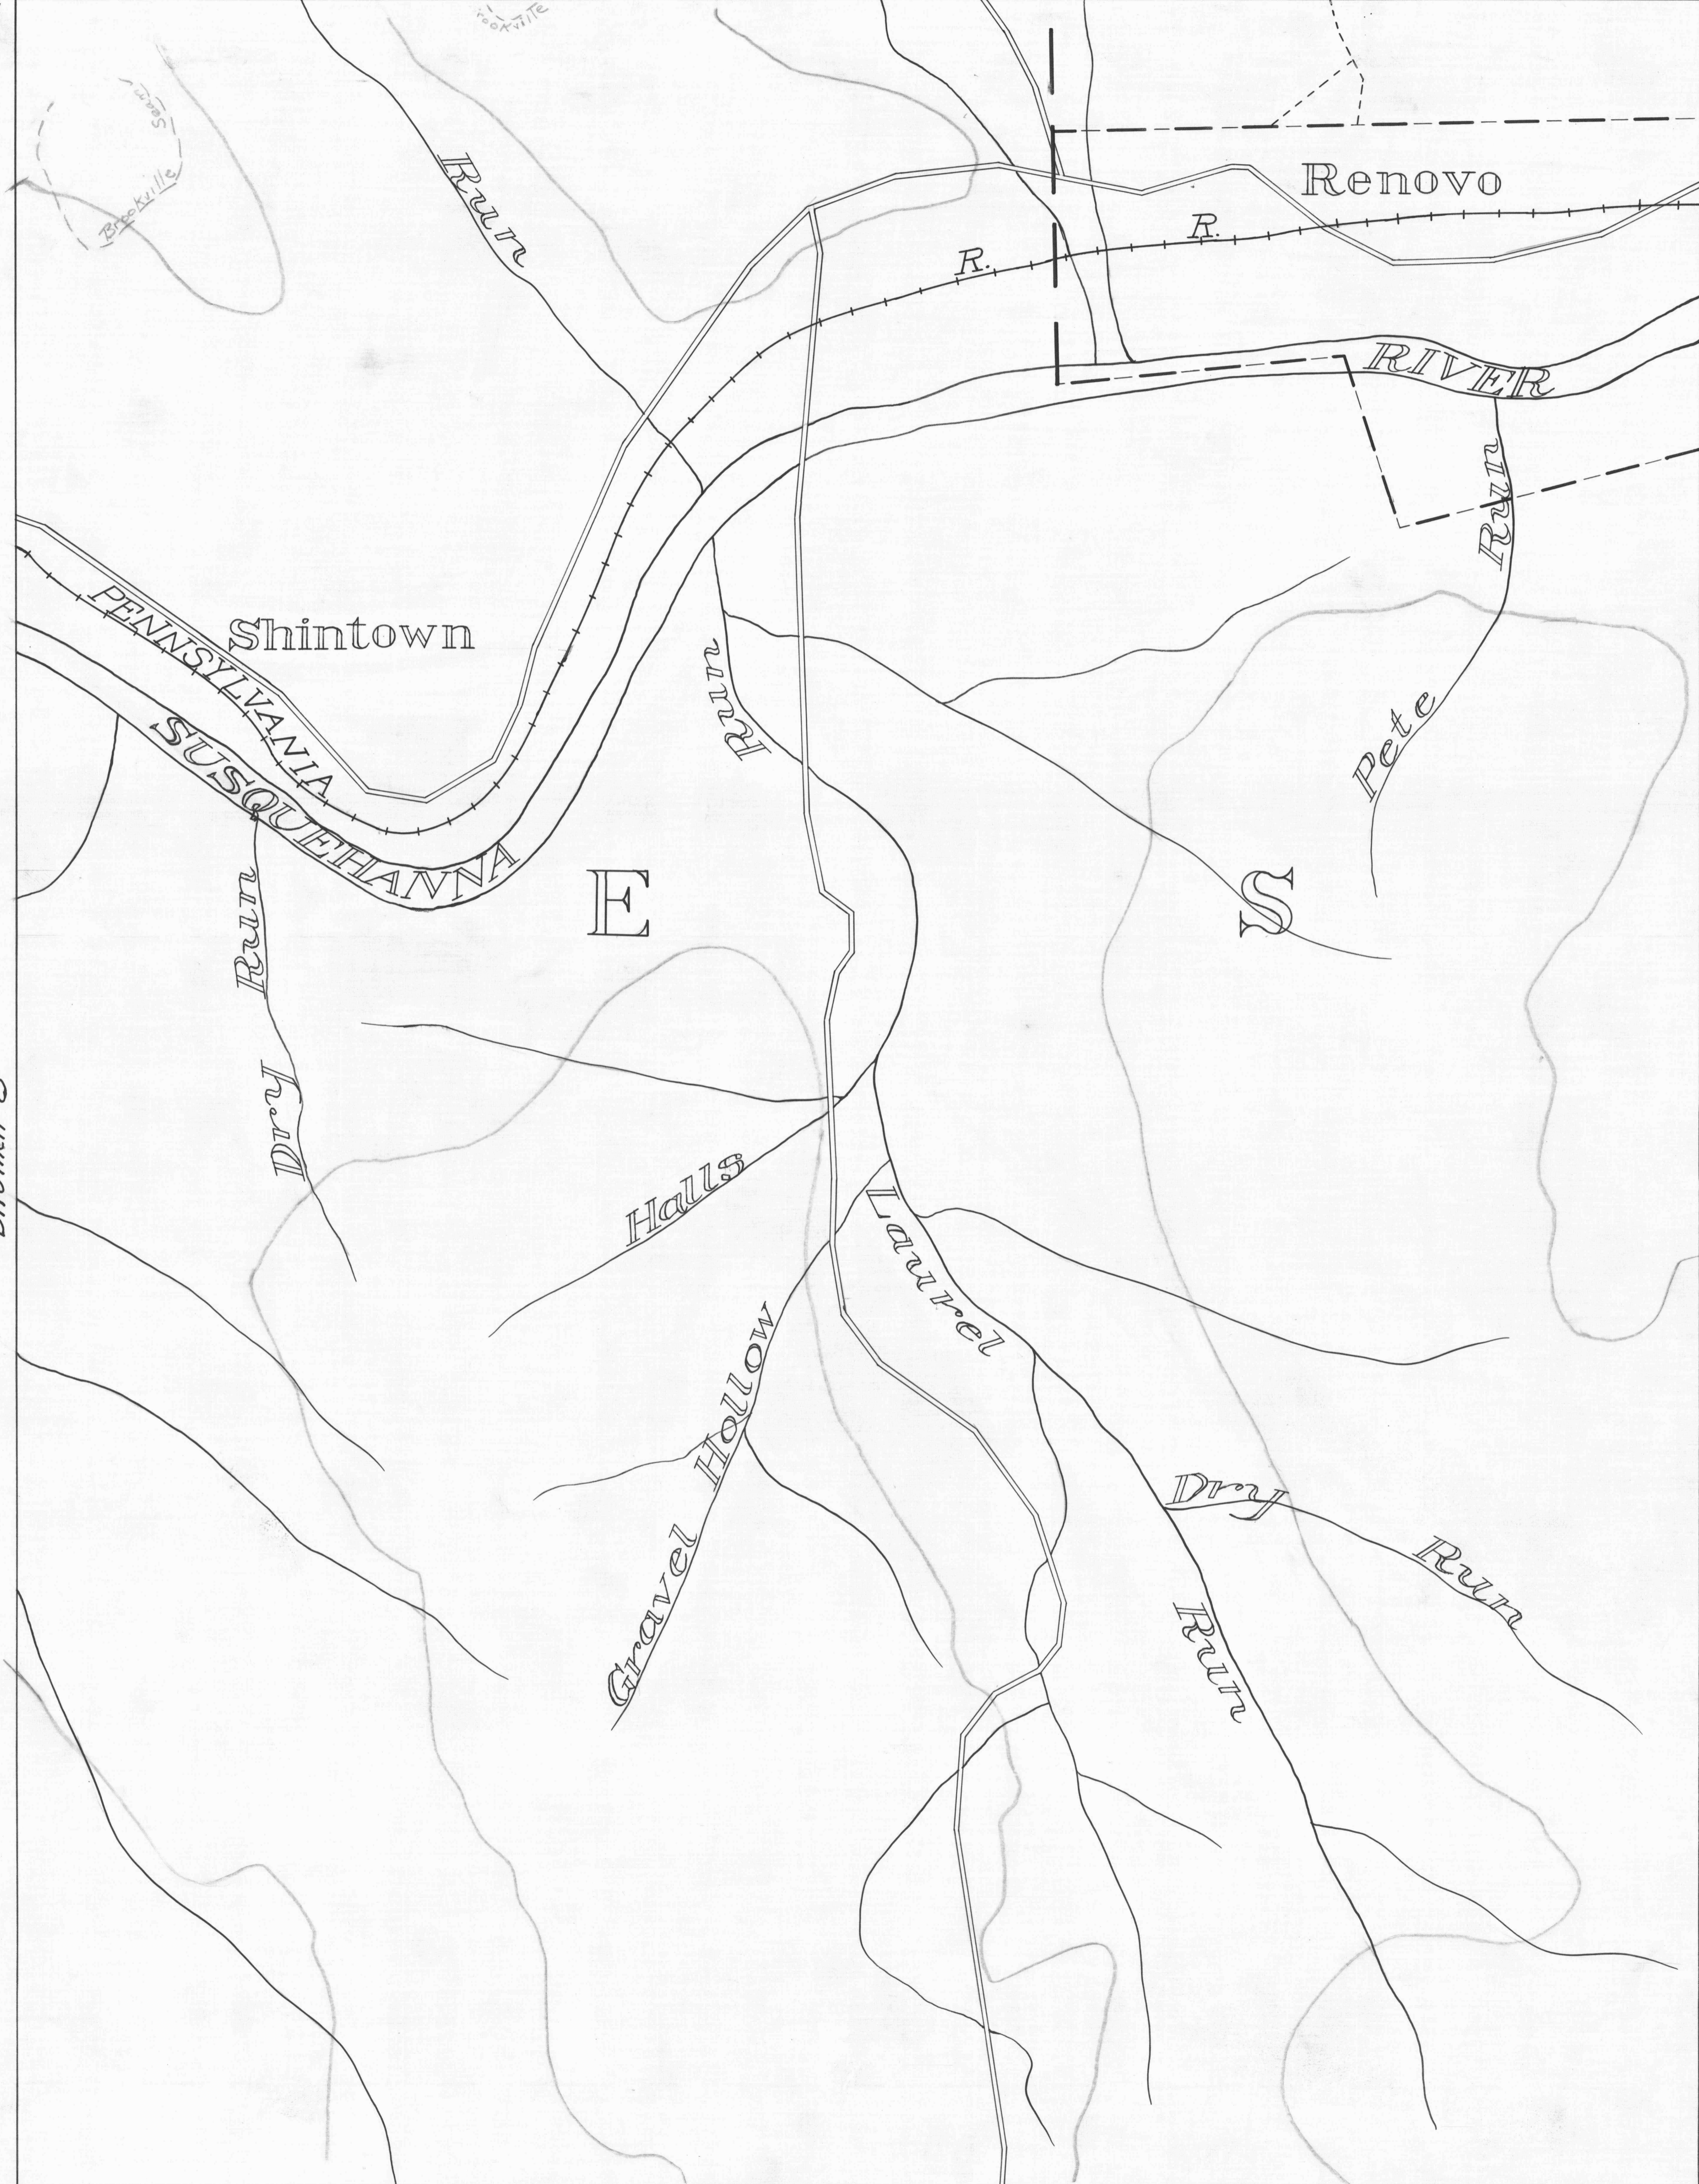

41°15' 77°50' 77°45' 41°15'

Y — DRIFT OPENING  
 Z — SLOPE OPENING  
 □ — SHAFTS  
 ▨ — BARRIER PILLAR

Snowshoe 3  
 2 MILES  
 W.P.A. PROJECT NO 4483  
 BROOKVILLE  
 BITUMEN SHEET No. 9.  
 BITUMEN, PA.  
 Howard I.