


- ACTIVE OIL WELL
- ABANDONED OIL WELL
- ✱ ACTIVE GAS WELL
- ✱ ABANDONED GAS WELL
- ✱ ACTIVE OIL & GAS WELL
- ✱ ABANDONED OIL & GAS WELL
- DRY HOLE
- NO RECORD
- DRIFT OPENING
- SLOPE OPENING
- SHAFTS
- ▨ BARRIER PILLAR
- COUNTY LINES
- TOWNSHIP LINES
- BOROUGH LINES
- 980 *uf* COAL CONTOURS
- CROP LINES - SEAMS BEING MINED
- - - CROP LINES - SEAMS NOT BEING MINED

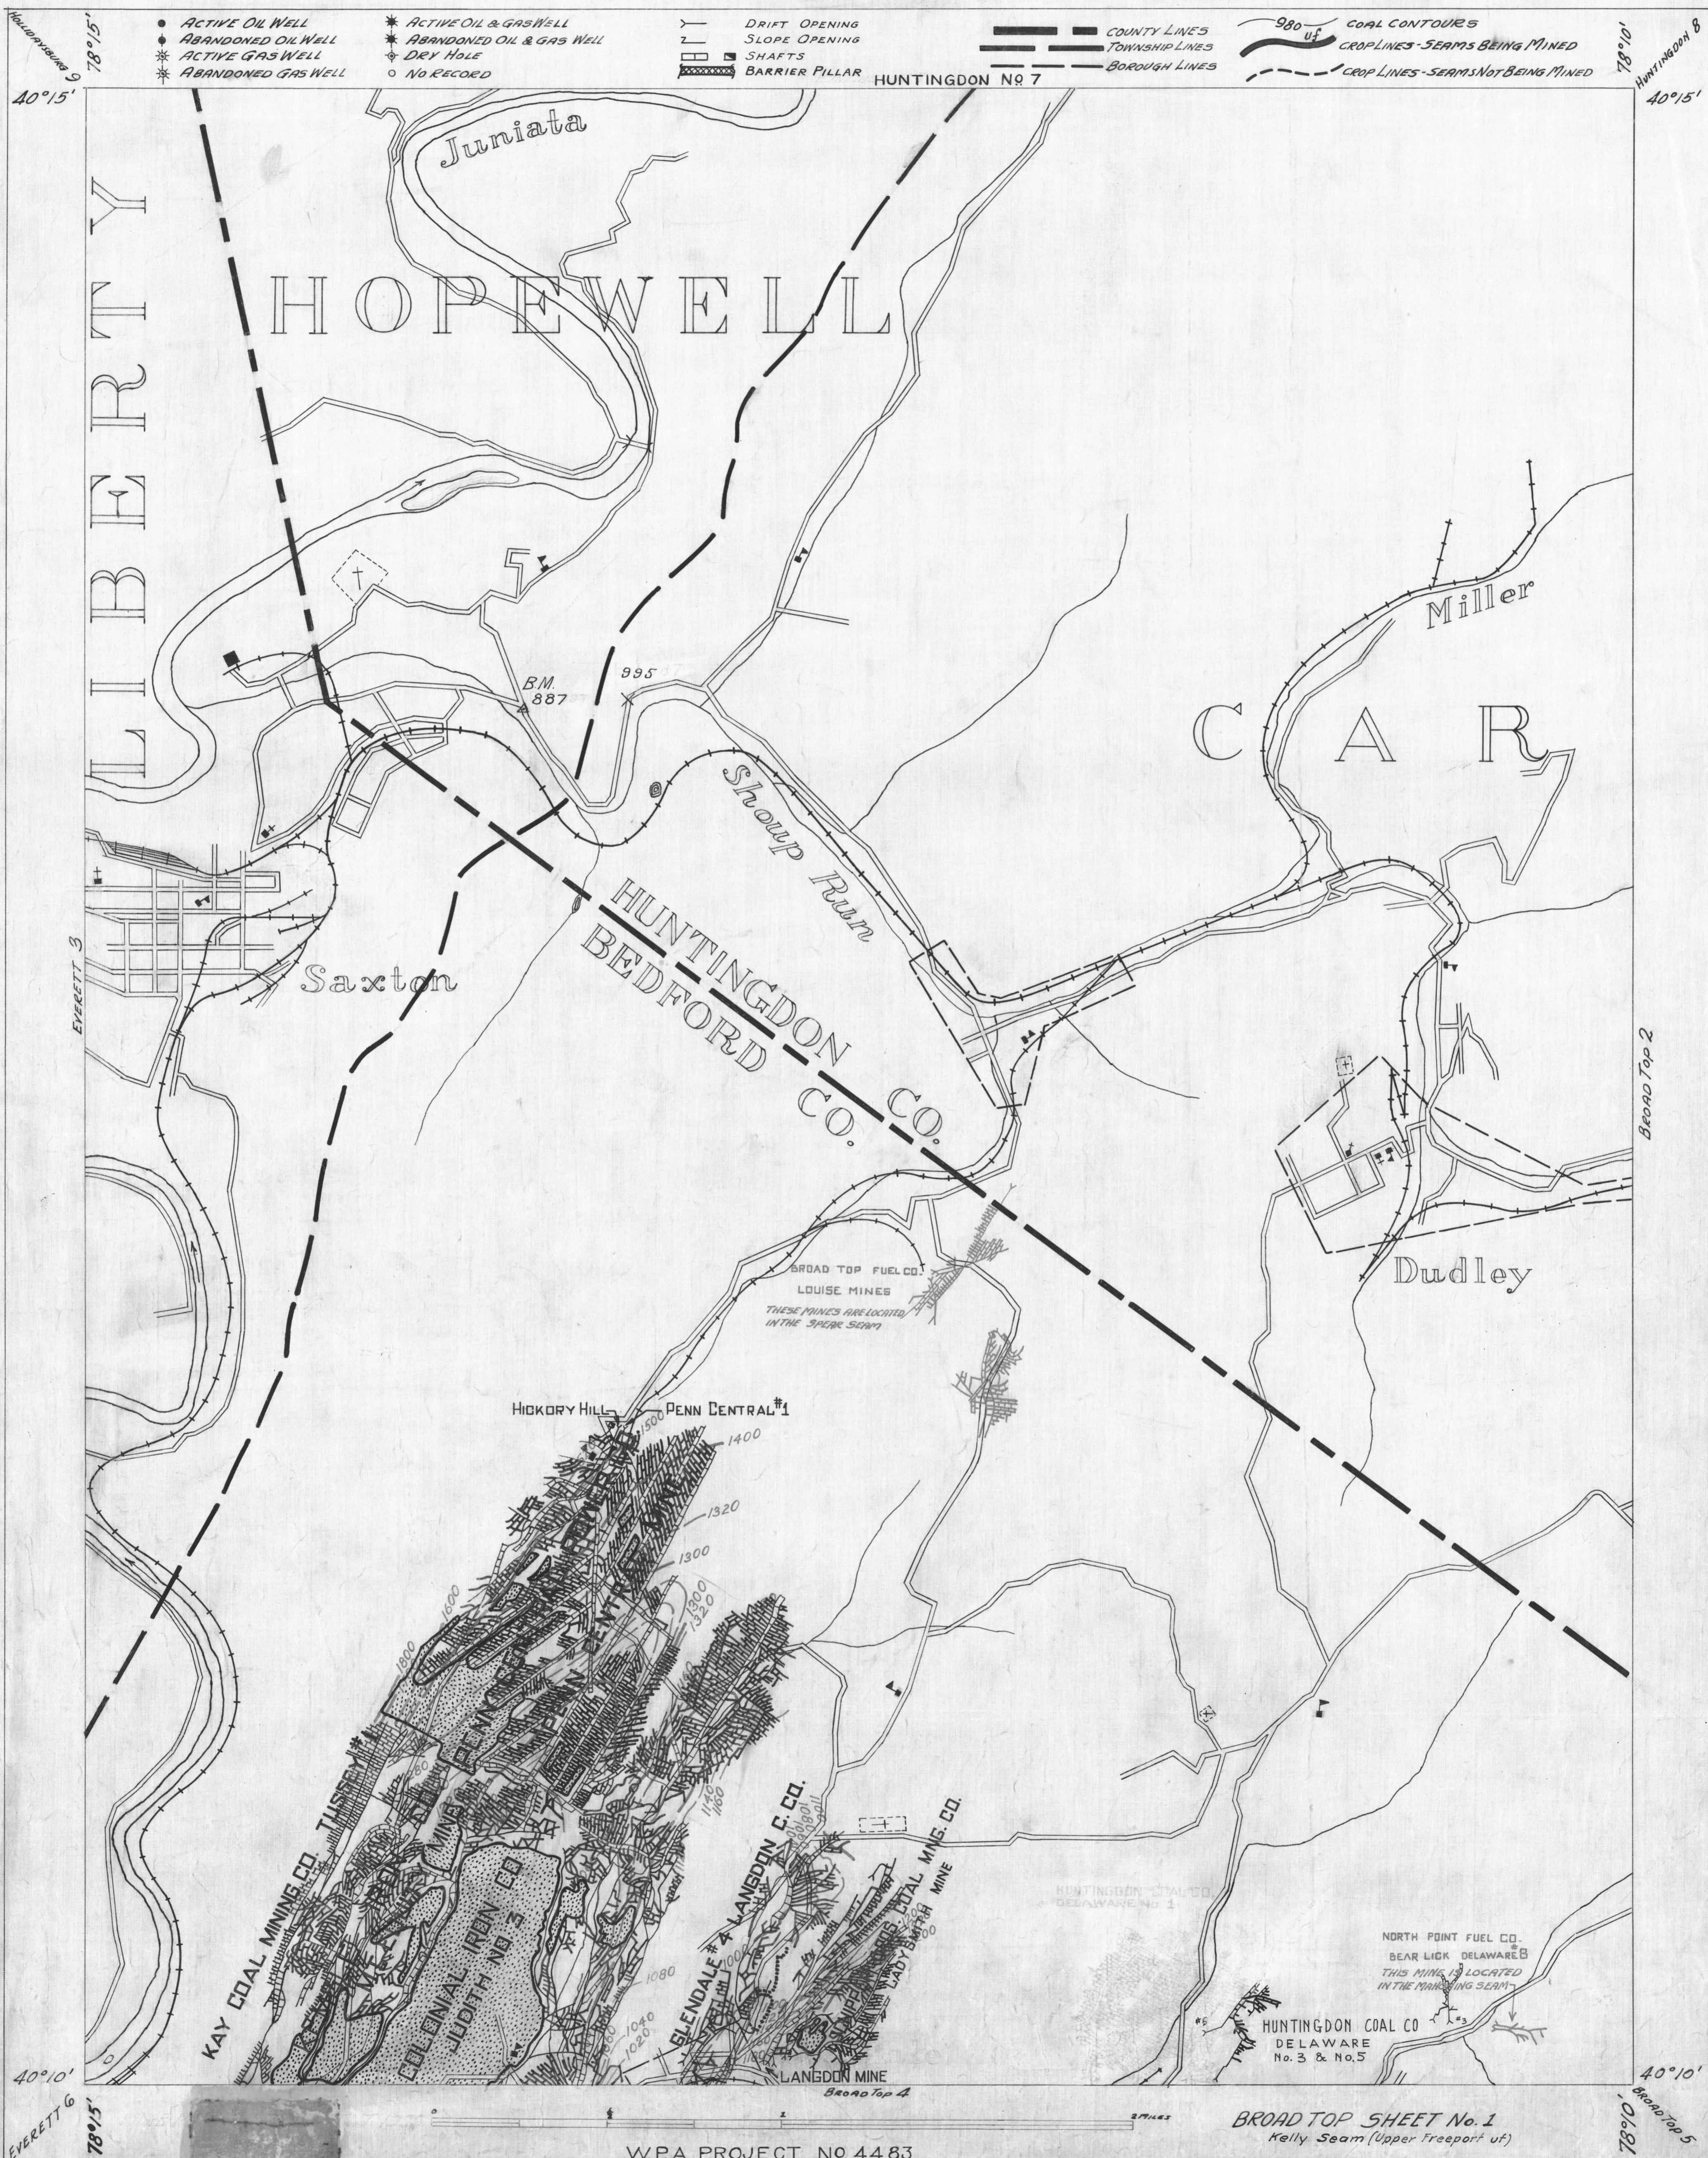

BROAD TOP SHEET No. 1  
Kelly Seam (Upper Freeport *uf*)