


Pittsburgh 8
40°-15'

- ACTIVE OIL WELL
- ABANDONED OIL WELL
- ★ ACTIVE GAS WELL
- ★ ABANDONED GAS WELL
- ★ ACTIVE OIL & GAS WELL
- ★ ABANDONED OIL & GAS WELL
- DRY HOLE
- NO RECORD

Pittsburgh 9

- COUNTY LINES
- TOWNSHIP LINES
- BOROUGH LINES
- 000 COAL CONTOURS
- CROP LINES - SEAM BEING MINED
- CROP LINES - SEAMS NOT BEING MINED

Greensburg 7
40°-15'

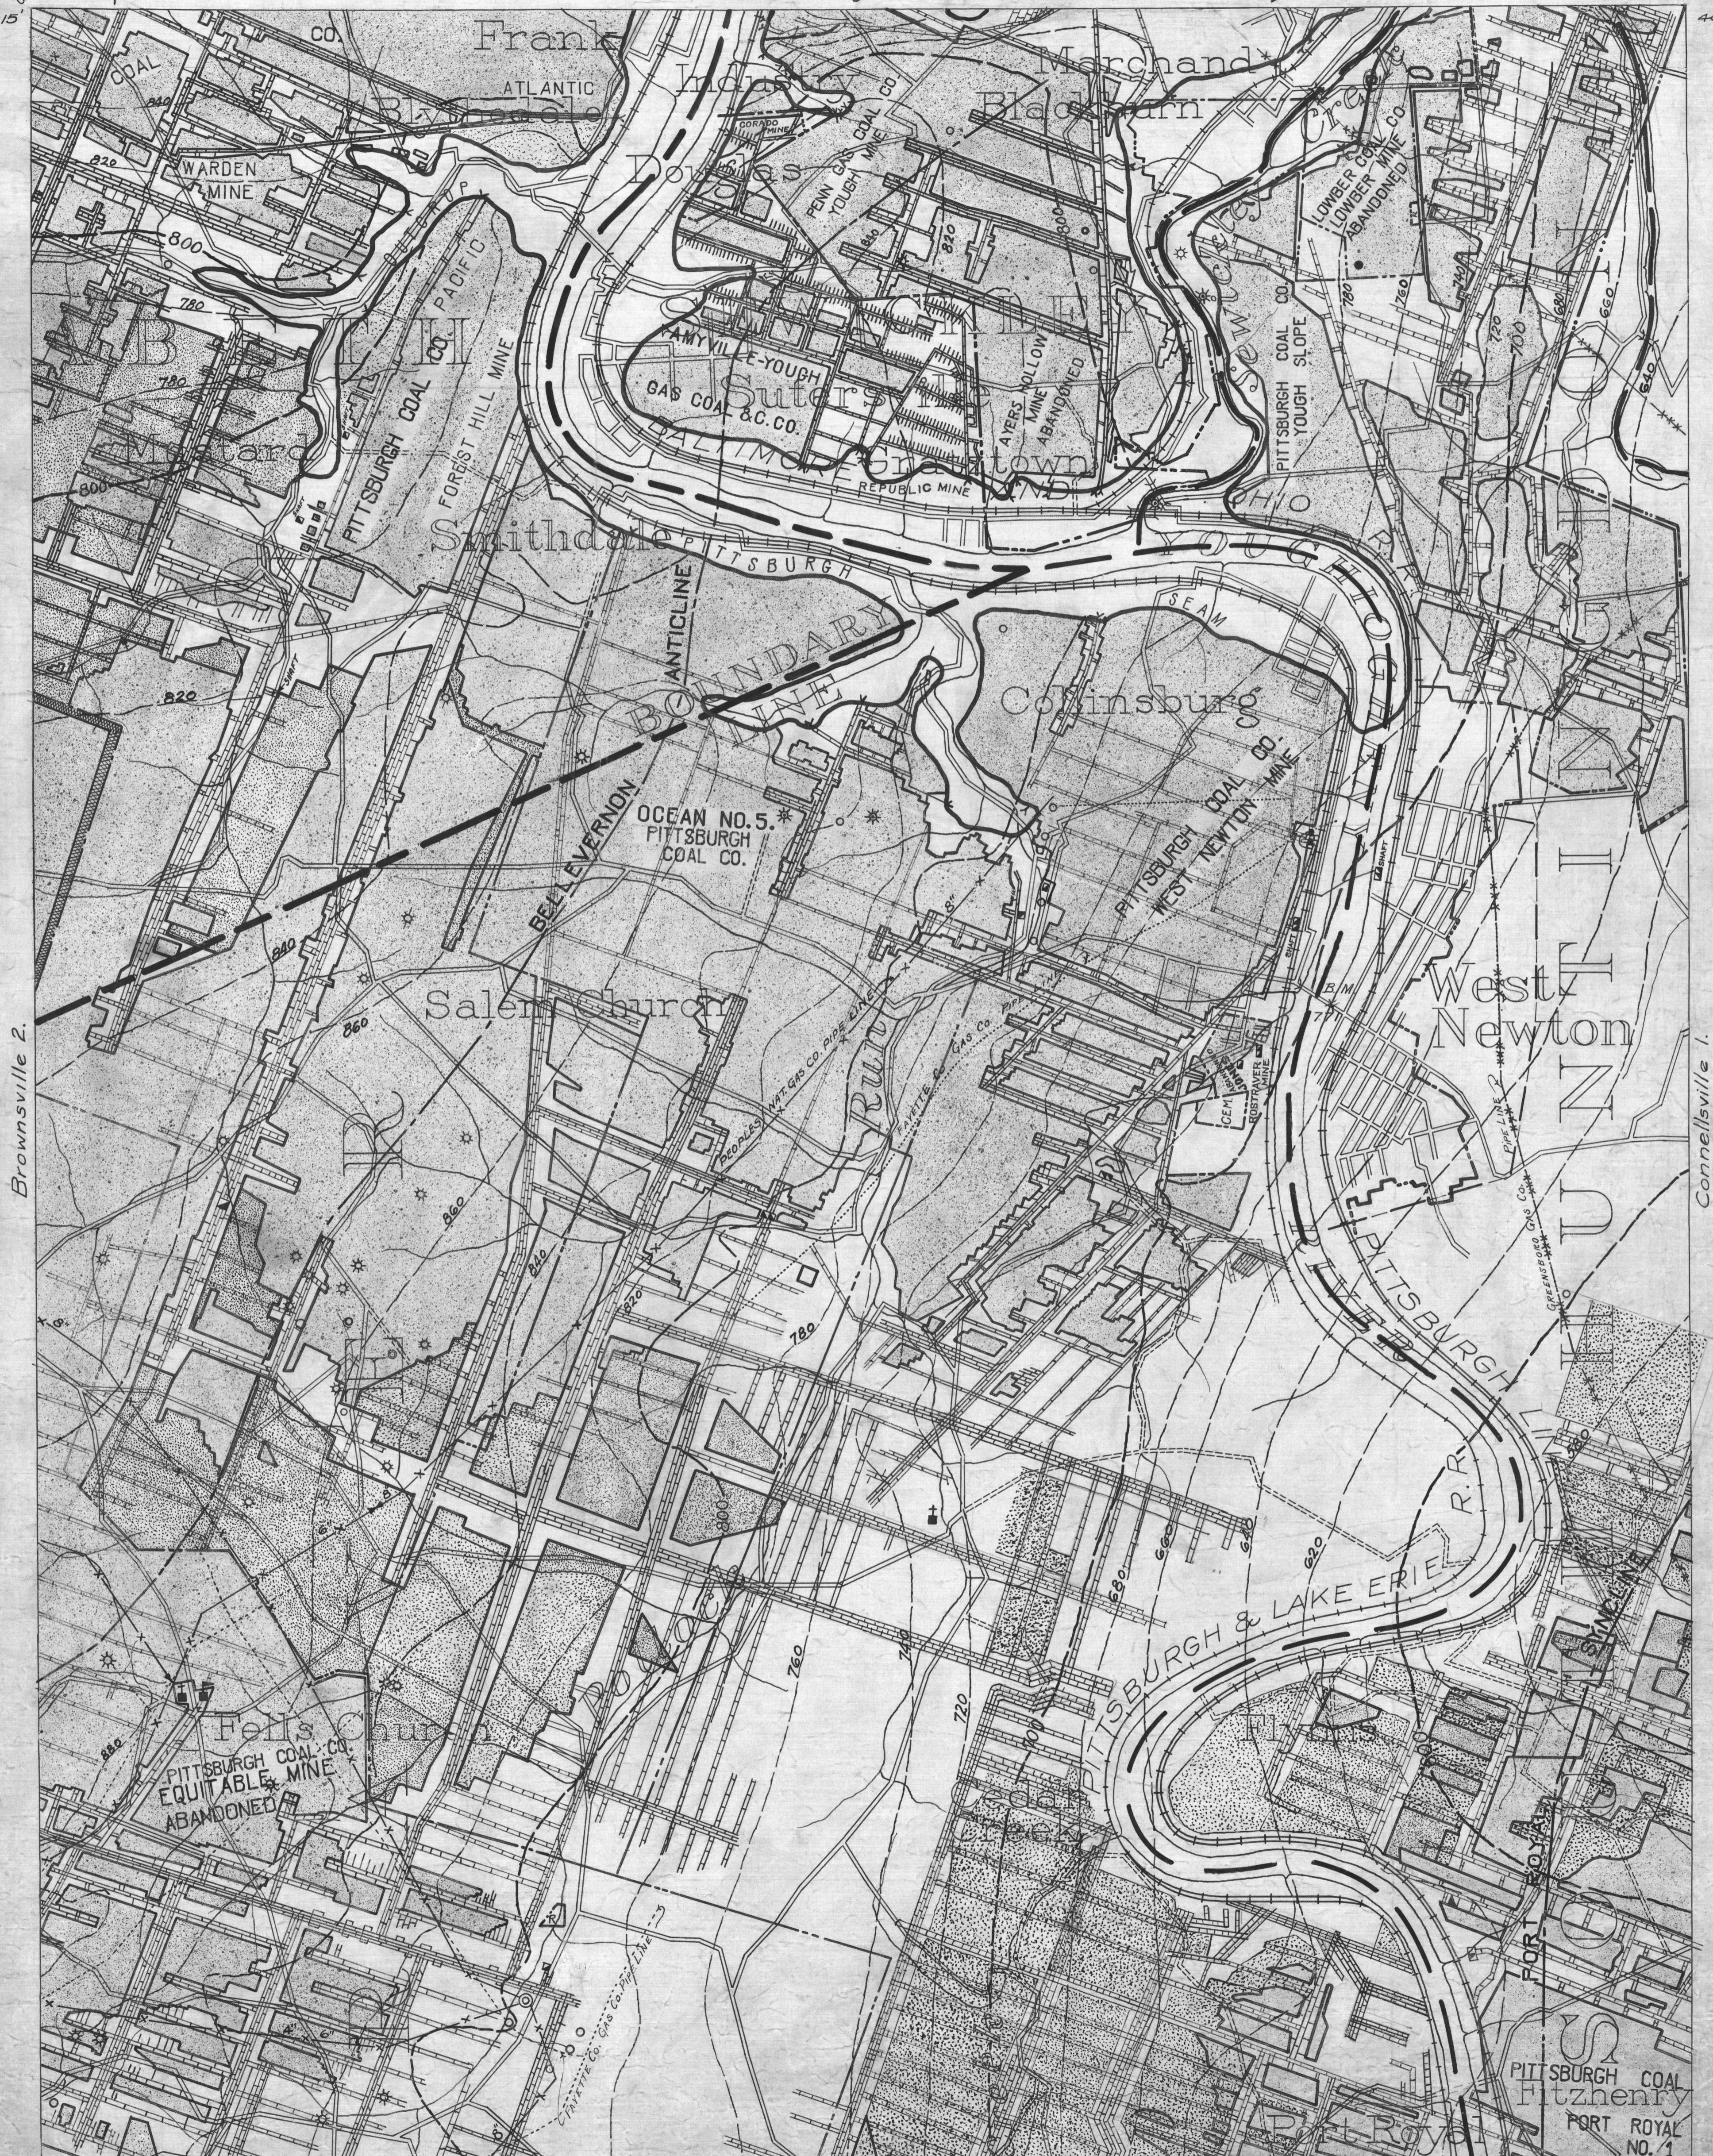

Brownsville 2.

Connellsville 1.

Brownsville 5
40°-10'
79°-50'

- DRIFT OPENING
- SLOPE OPENING
- SHAFTS
- ▨ BARRIER PILLAR

Brownsville 6.

2 MILES BROWNVILLE SHEET NO. 3
PITTSBURGH SEAM

W.P.A. PROJECT NO. 4483

Connellsville 4
40°-10'
79°-50'