


BEAVER 8 80°20' 40°20'

* ACTIVE OIL WELL
 * ABANDONED OIL WELL
 * ACTIVE GAS WELL
 * ABANDONED GAS WELL
 * ACTIVE OIL & GAS WELL
 * ABANDONED OIL & GAS WELL
 * DRY HOLE
 o NO RECORD

COUNTY LINES
 TOWNSHIP LINES
 BOROUGH LINES

980 COAL CONTOURS
 CROP LINES- SEAM BEING MINED
 CROP LINES- SEAMS NOT BEING MINED

BEAVER 9 80°15' 40°20' SEWICKLEY 7

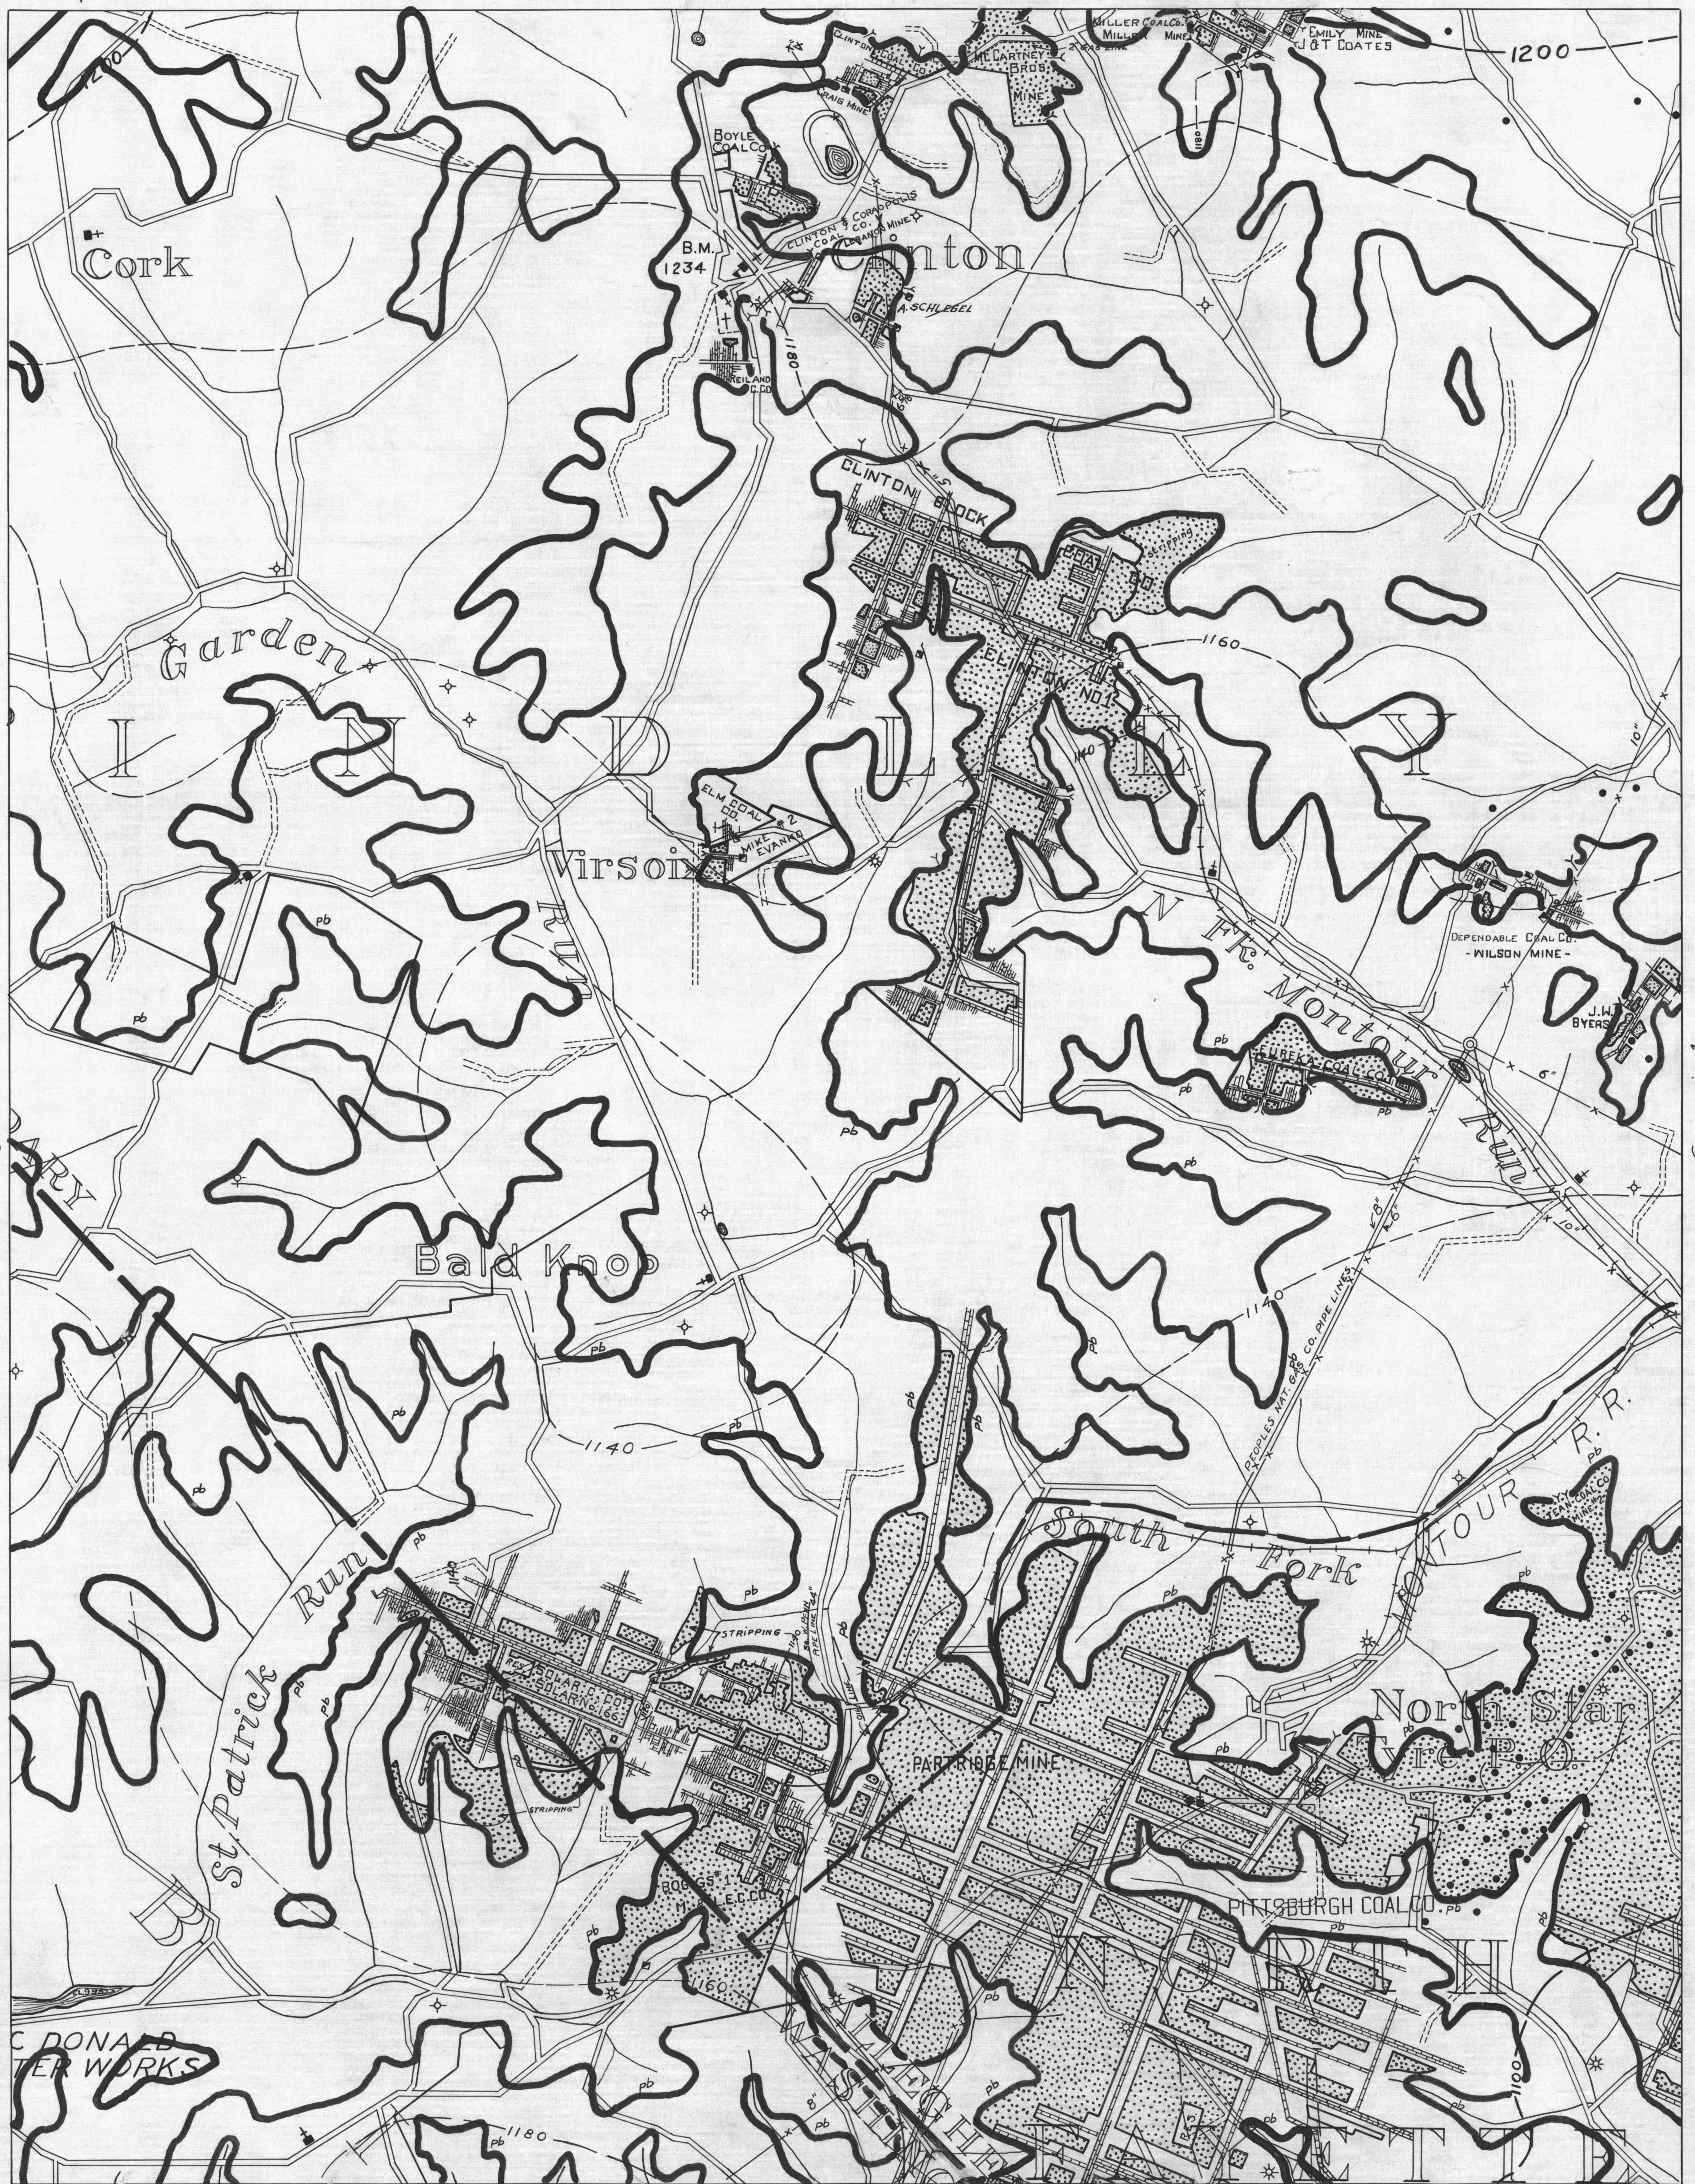

40°25' 80°20' 80°15' 40°25'

BURGETTSTOWN 2
 BURGETTSTOWN 5
 BURGETTSTOWN 6
 BURGETTSTOWN 7
 CARNEGIE 1
 CARNEGIE 4

DRIFT OPENING
 SLOPE OPENING
 SHAFTS
 BARRIER PILLAR

0 1/2 1 2 MILES
 W.P.A. PROJECT NO. 19666
 BURGETTSTOWN SHEET N. 3
 Pittsburgh Seam - pb
 BGN-3 pb seam