


SEWICKLEY 7 80° 10' 40° 30' SEWICKLEY 8 80° 05' 40° 30' SEWICKLEY 9

- ACTIVE OIL WELL
- ABANDONED OIL WELL
- ★ ACTIVE GAS WELL
- ✱ ABANDONED GAS WELL
- ✱ ACTIVE OIL & GAS WELL
- ✱ ABANDONED OIL & GAS WELL
- ◇ DRY HOLE
- NO RECORD

- COUNTY LINES
- - - TOWNSHIP LINES
- - - BOROUGH LINES
- 980 pb COAL CONTOURS
- - - CROP LINES - SEAM BEING MINED
- - - CROP LINES - SEAM'S NOT BEING MINED

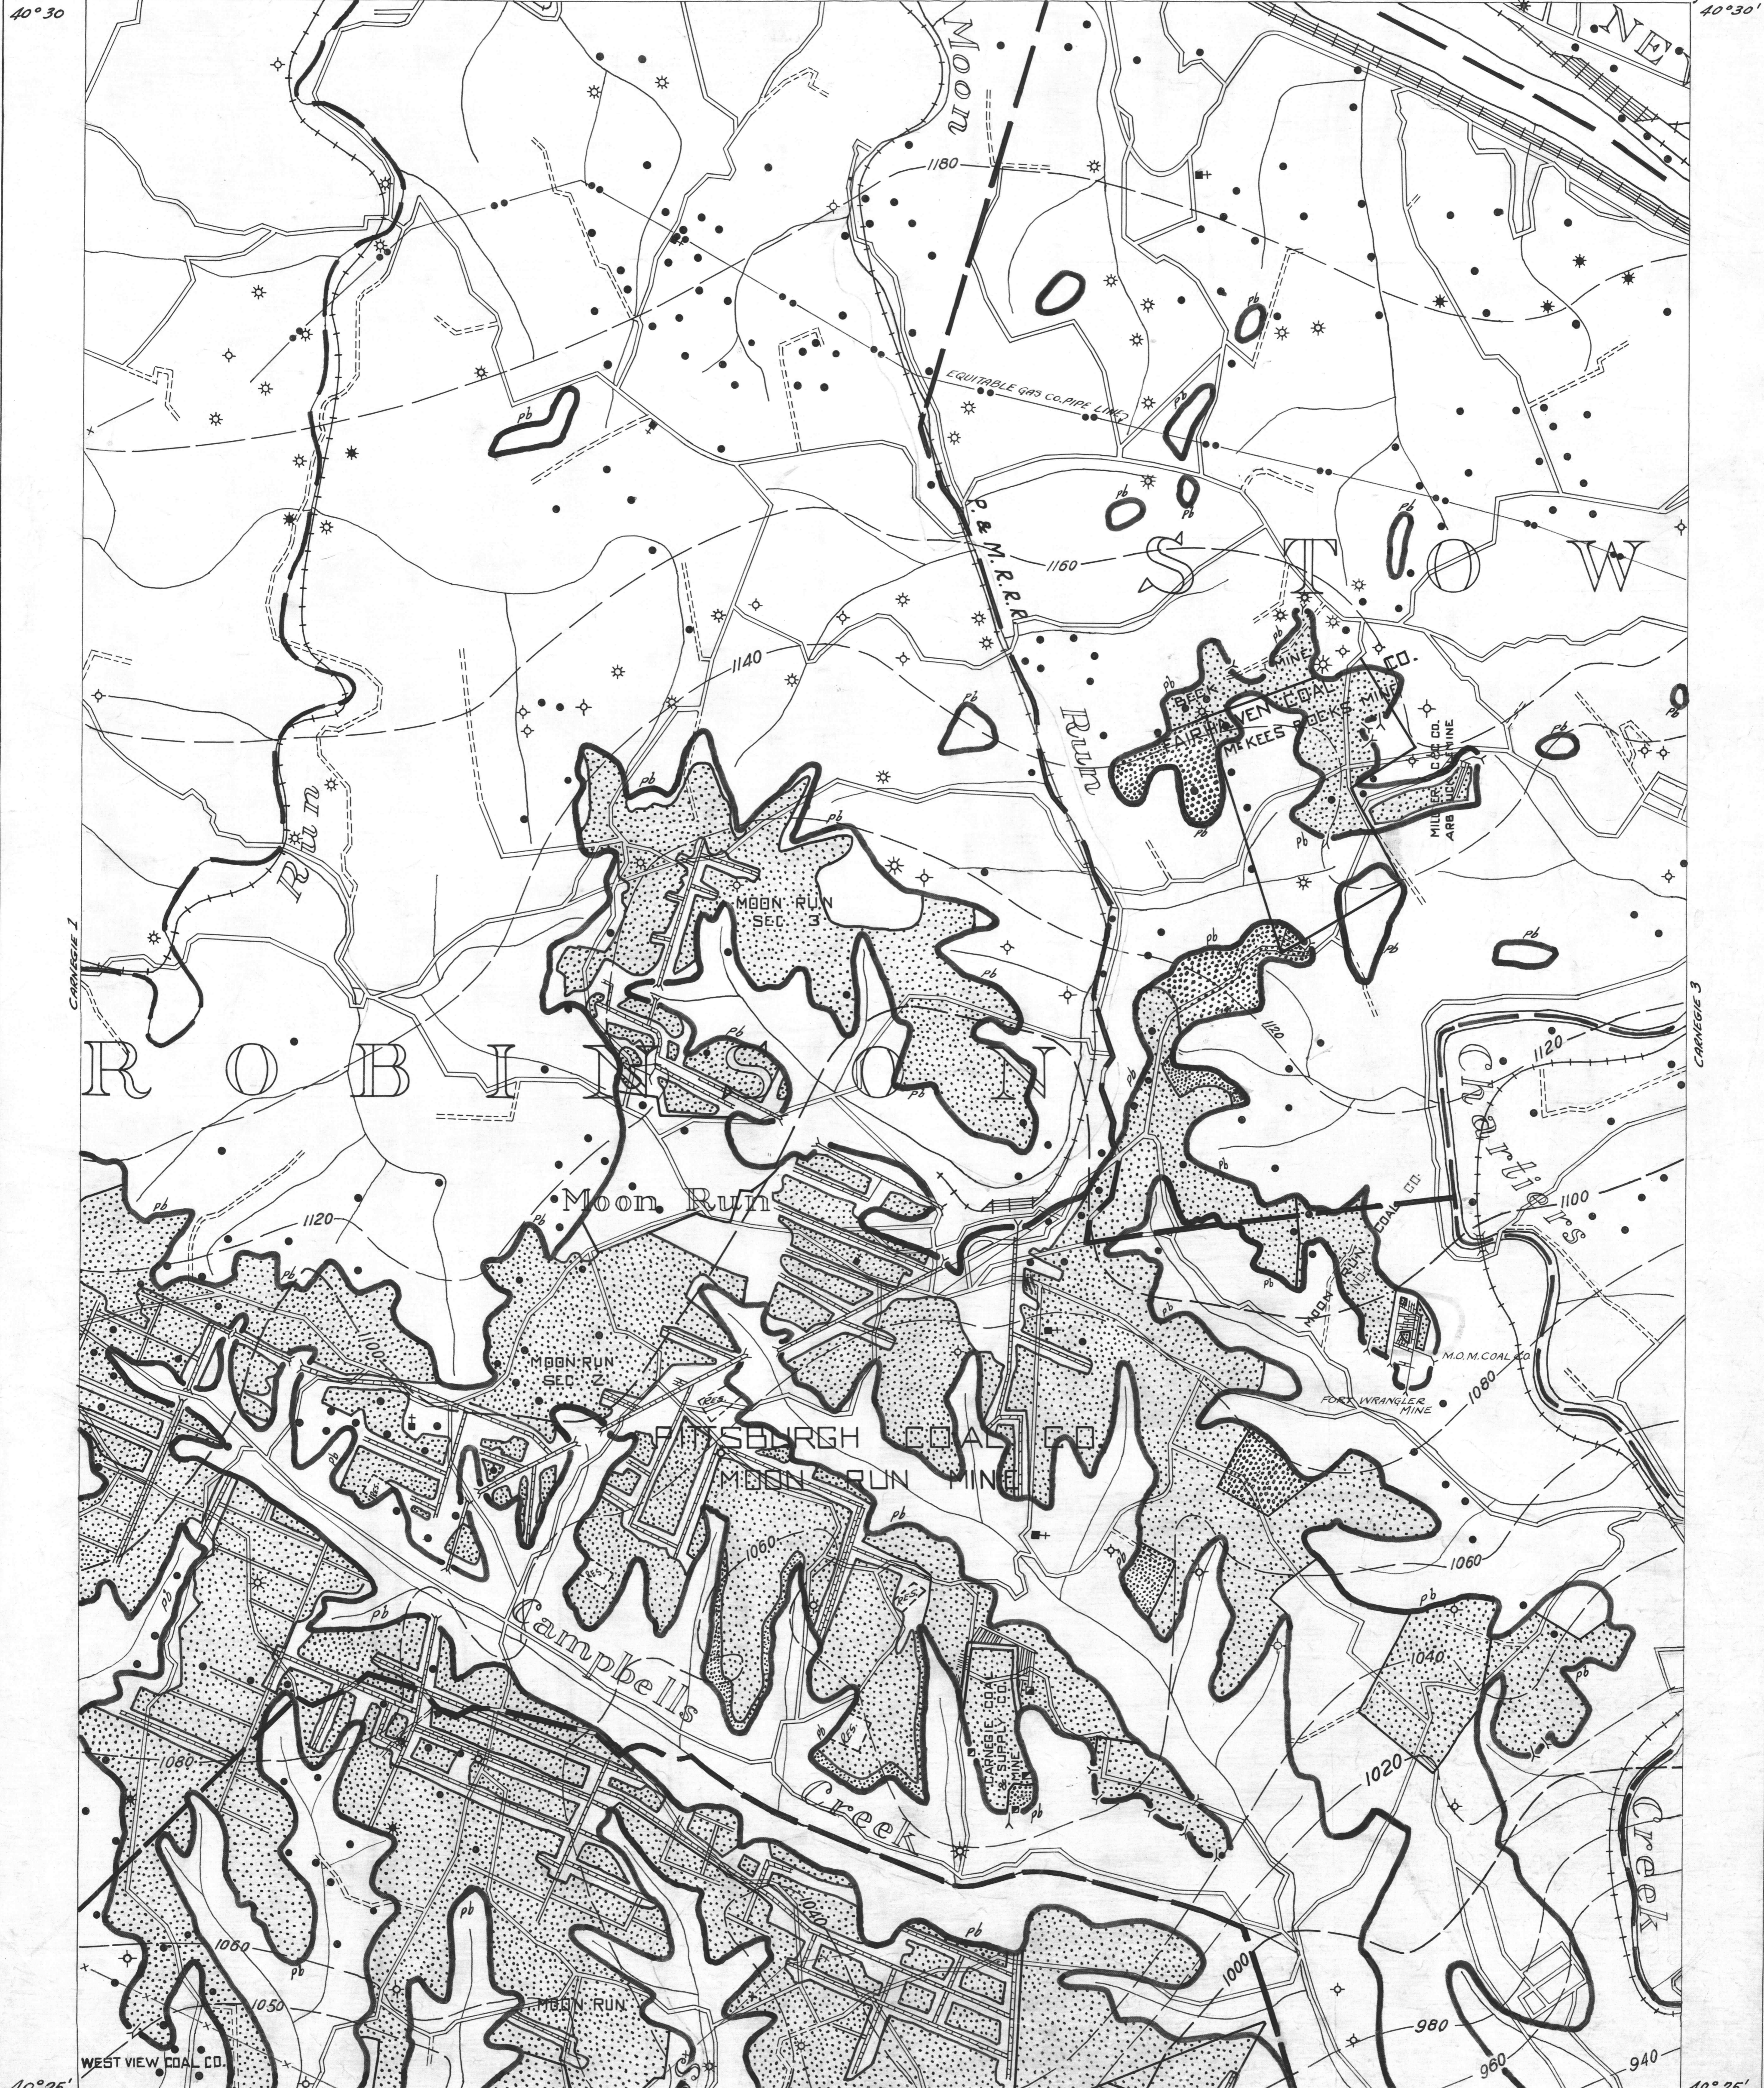

40° 25' 80° 10' 40° 25' 80° 05' 40° 25'

WEST VIEW COAL CO. CARNEGIE 4 CARNEGIE 5 CARNEGIE 5

DRIFT OPENING
SLOPE OPENING
SHAFTS
BARRIER PILLAR

W.P.A. PROJECT NO.4483

CARNEGIE SHEET No. 2
Pittsburgh Seam - pb