


● ACTIVE OIL WELL
 ○ ABANDONED OIL WELL
 * ACTIVE GAS WELL
 * ABANDONED GAS WELL
 * ACTIVE OIL & GAS WELL
 * ABANDONED OIL & GAS WELL
 ◇ DRY HOLE
 ○ NO RECORD

Confluence 6

COUNTY LINES
 TOWNSHIP LINES
 BOROUGH LINES

980 COAL CONTOURS
 CROP LINES - SEAMS BEING MINED
 CROP LINES - SEAMS NOT BEING MINED

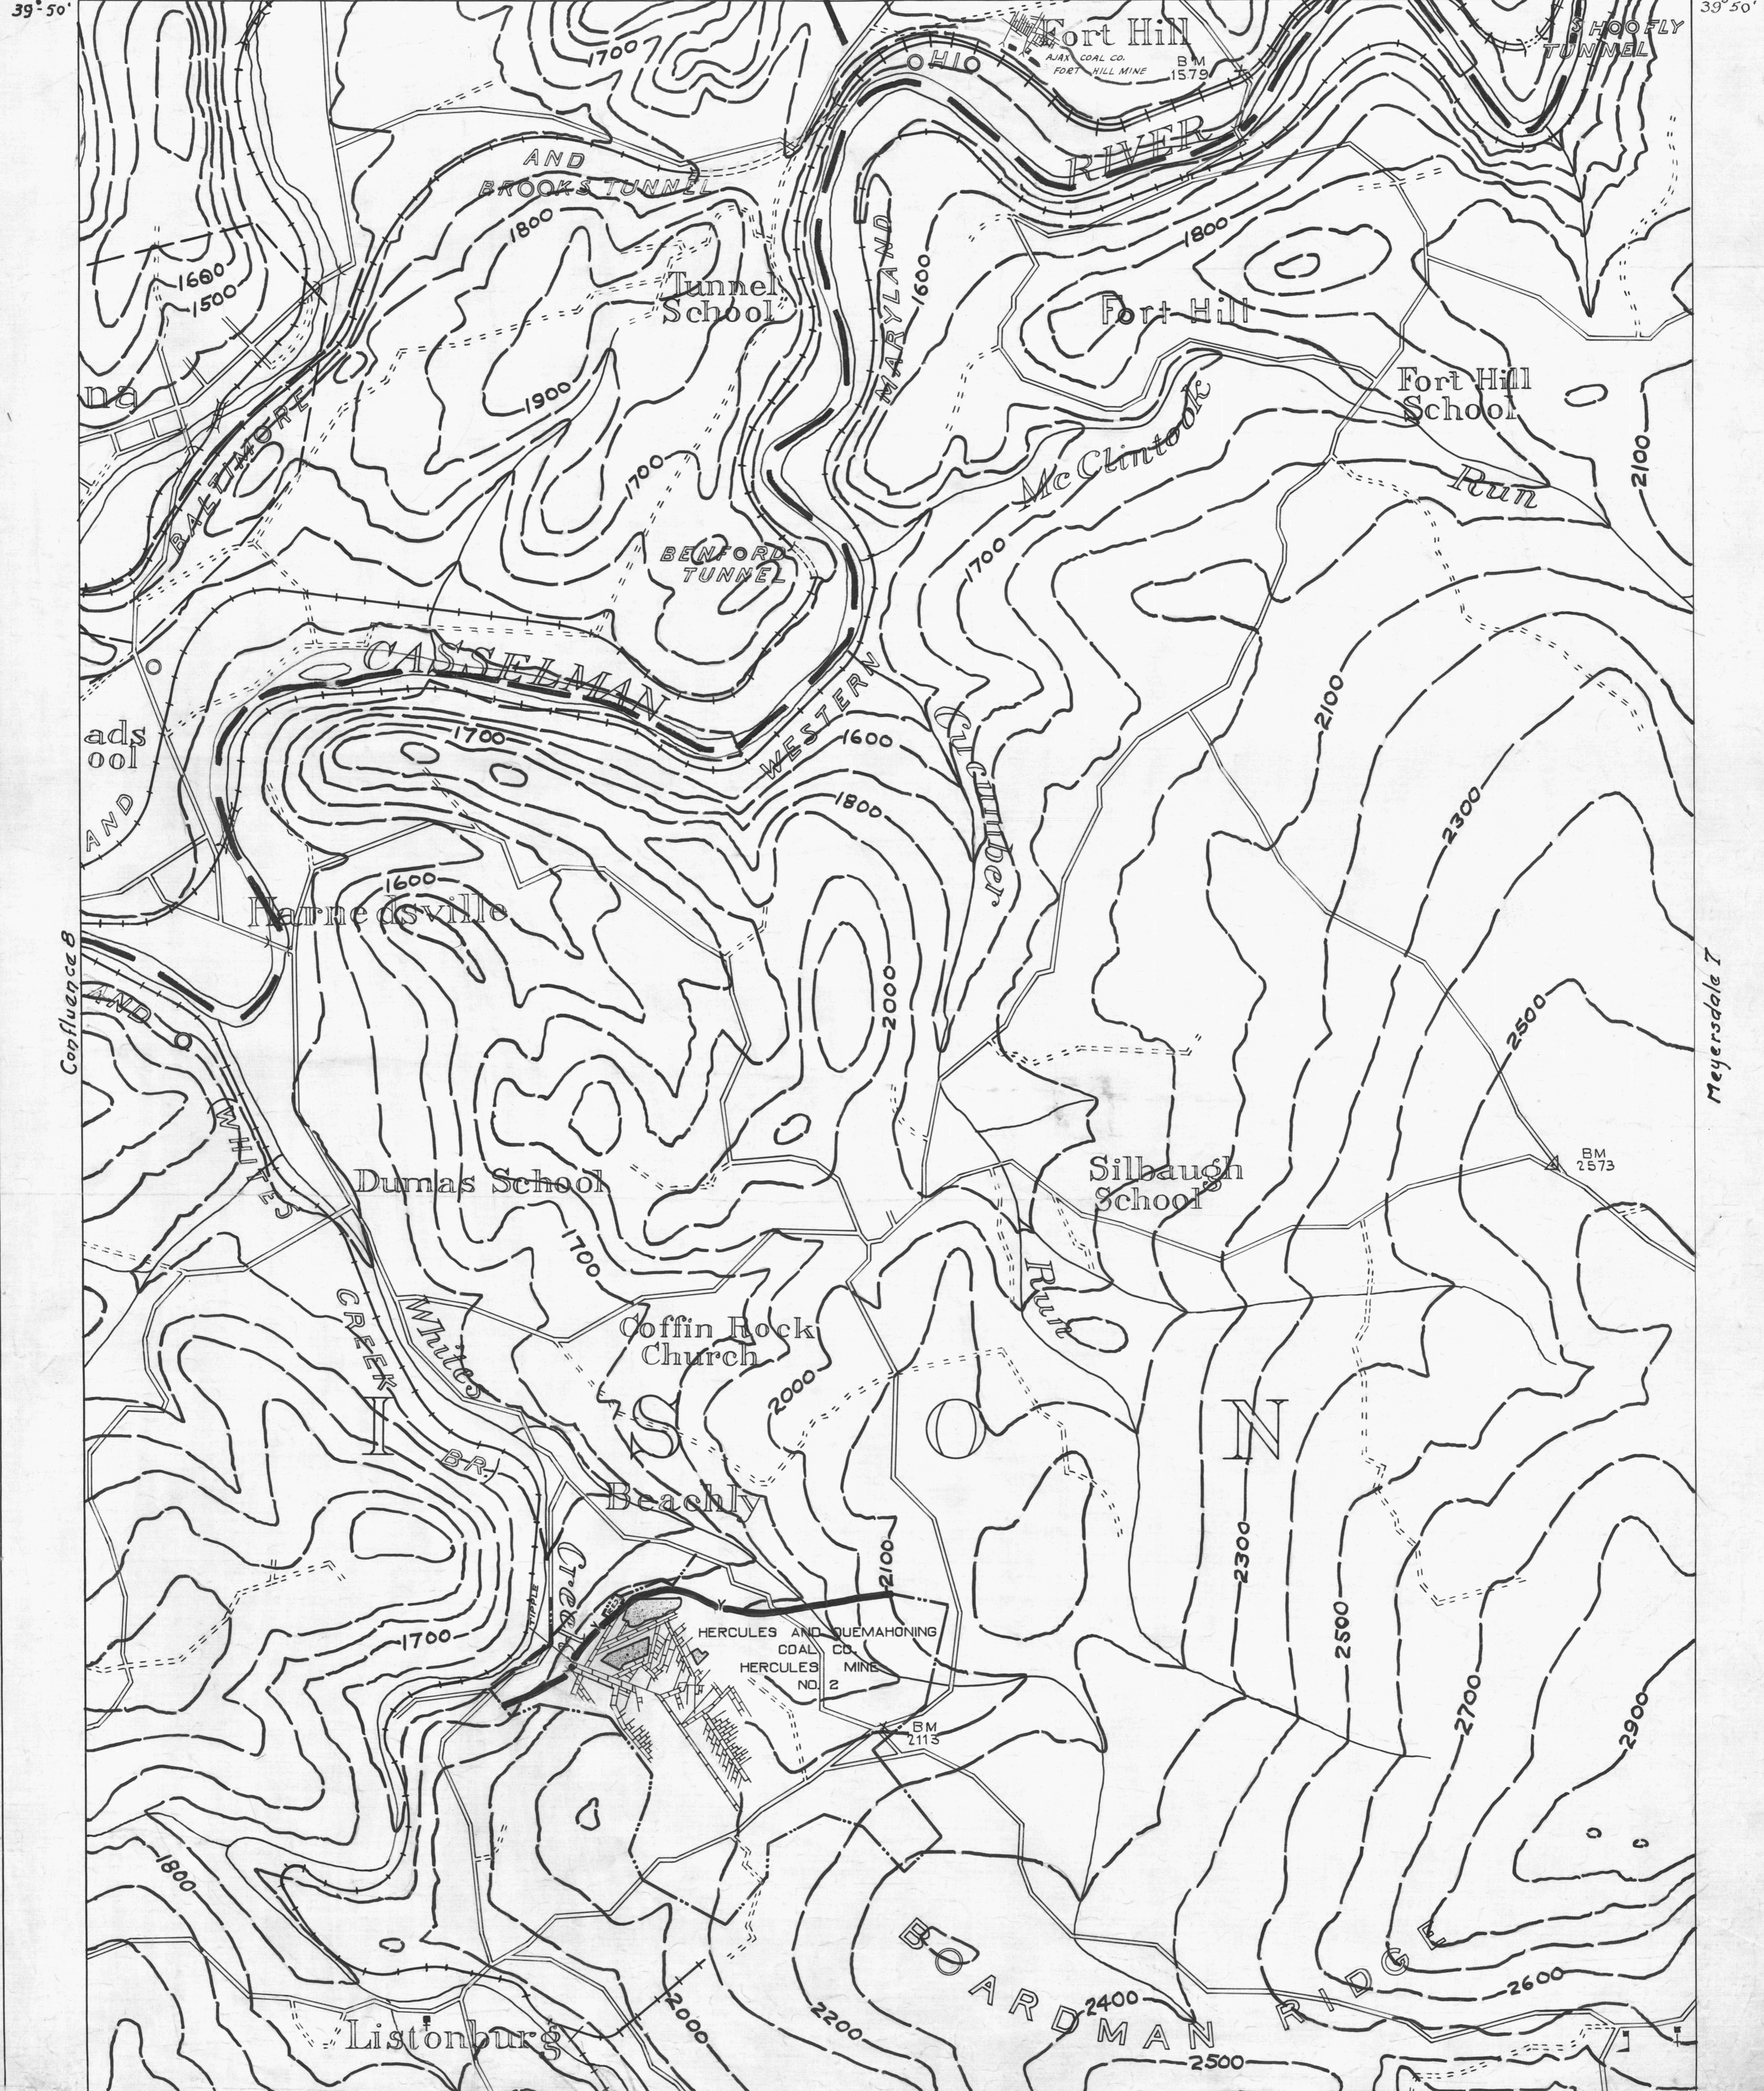

39° 45'
 79° 20'
 Accident 2
 DRIFT OPENING
 SLOPE OPENING
 SHAFTS
 BARRIER PILLAR

Accident 3
 0 1 2 MILES
 W.P.A. PROJECT No 4483

CONFLUENCE SHEET No. 9.
 L.K. SEAM
 39° 45'
 79° 15'
 Grabville 2