


- ACTIVE OIL WELL
- ABANDONED OIL WELL
- ⊛ ACTIVE GAS WELL
- ⊛ ABANDONED GAS WELL
- ★ ACTIVE OIL & GAS WELL
- ★ ABANDONED OIL & GAS WELL
- ◇ DRY HOLE
- NO RECORD

- COUNTY LINES
- TOWNSHIP LINES
- BOROUGH LINES
- 980 — COAL CONTOURS — 900 —
- CROP LINES - SEAMS BEING MINED
- CROP LINES - SEAMS NOT BEING MINED

Connellsville 4

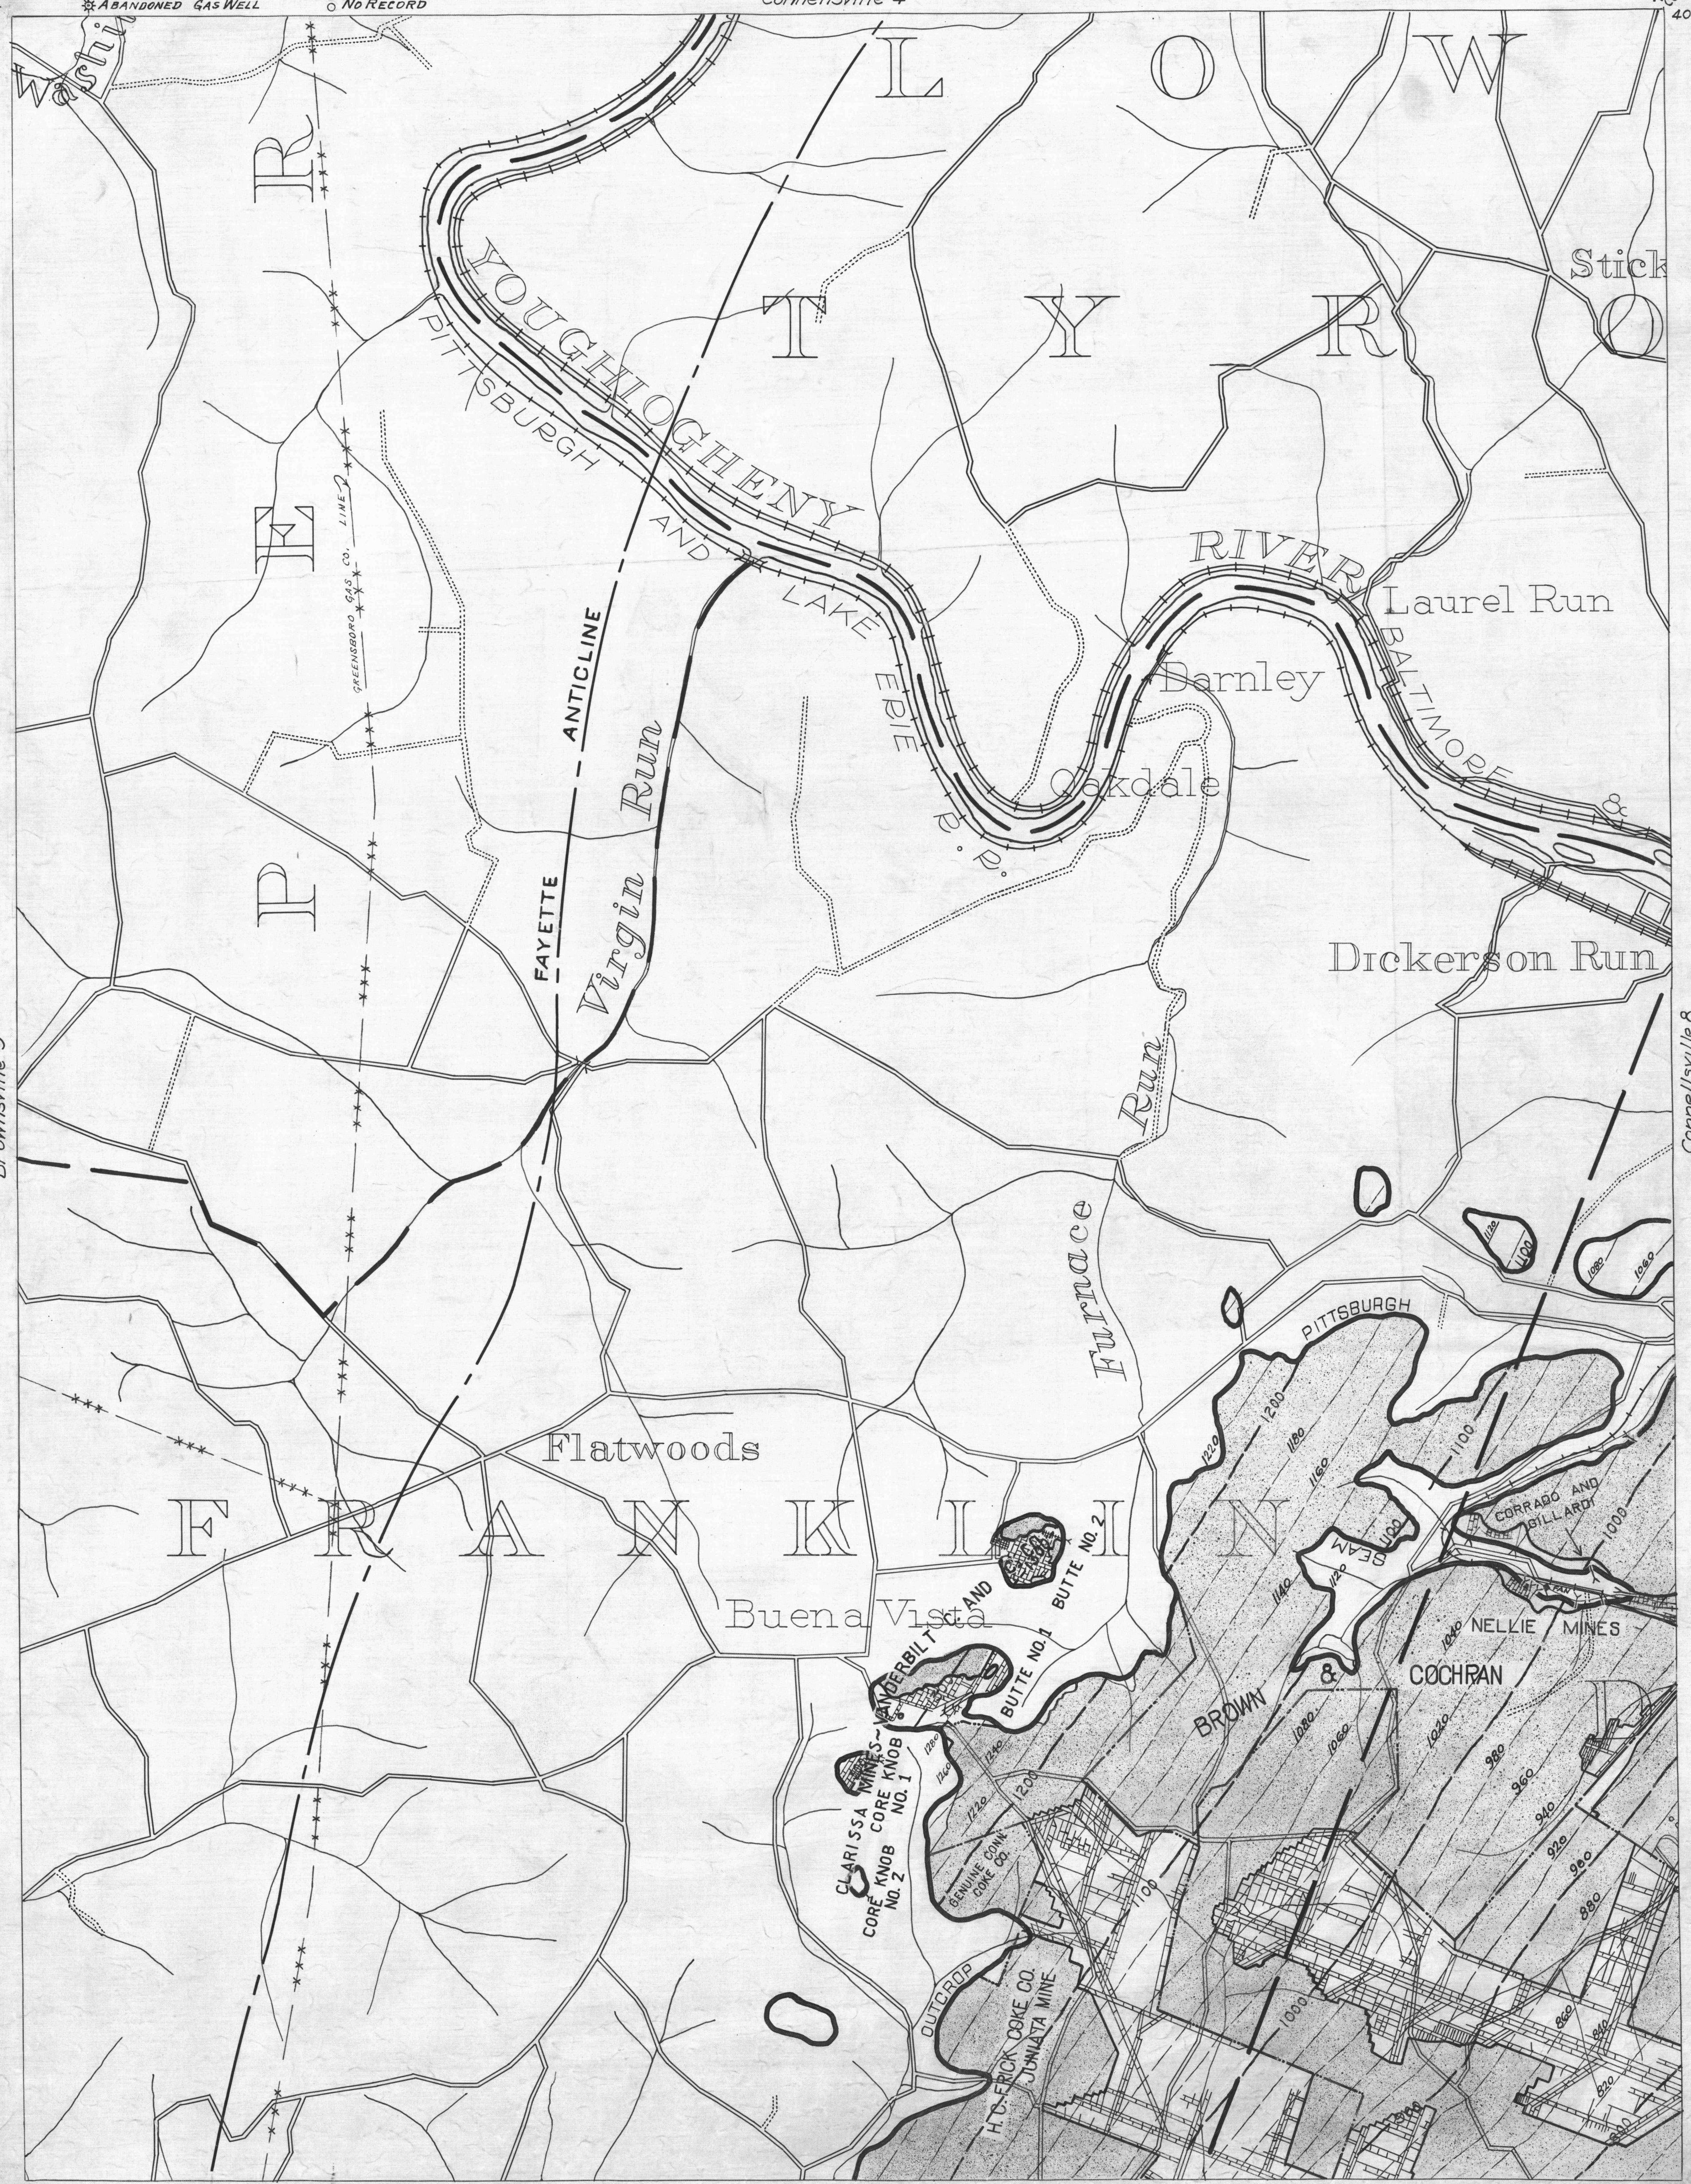

Brownsville 6  
40° 05'

Connellsville 5  
40° 05'


Brownsville 9

Connellsville 8

Masontown 13  
40° 00'  
75° 45' 13"

Uniontown 2  
40° 00'  
75° 45' 13"

- DRIFT OPENING
- SLOPE OPENING
- SHAFTS
- BARRIER PILLAR

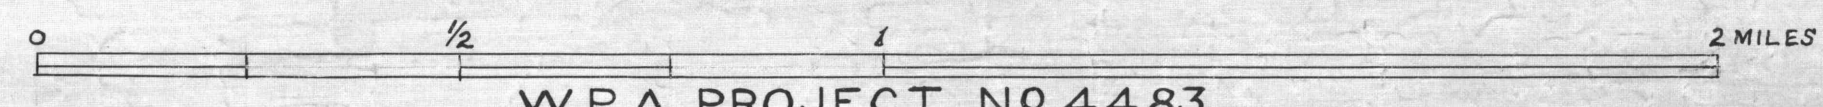

W.P.A. PROJECT NO 4483

PITTSBURGH SEAM,  
CONNELLSVILLE SHEET No. 7.