


Du Bois 2 78° 50' 41° 10' Du Bois 3 Du Bois 5 Du Bois 8 78° 50' 41° 05' Du Bois 9 78° 50' 41° 05'

- ACTIVE OIL WELL
- ABANDONED OIL WELL
- ACTIVE GAS WELL
- ABANDONED GAS WELL
- ★ ACTIVE OIL & GAS WELL
- ABANDONED OIL & GAS WELL
- ◇ DRY HOLE
- NO RECORD

- COUNTY LINES
- - - - - TOWNSHIP LINES
- - - - - BOROUGH LINES
- 990 IF COAL CONTOURS
- - - - - CROP LINES - SEAM BEING MINED
- - - - - CROP LINES - SEAMS NOT BEING MINED

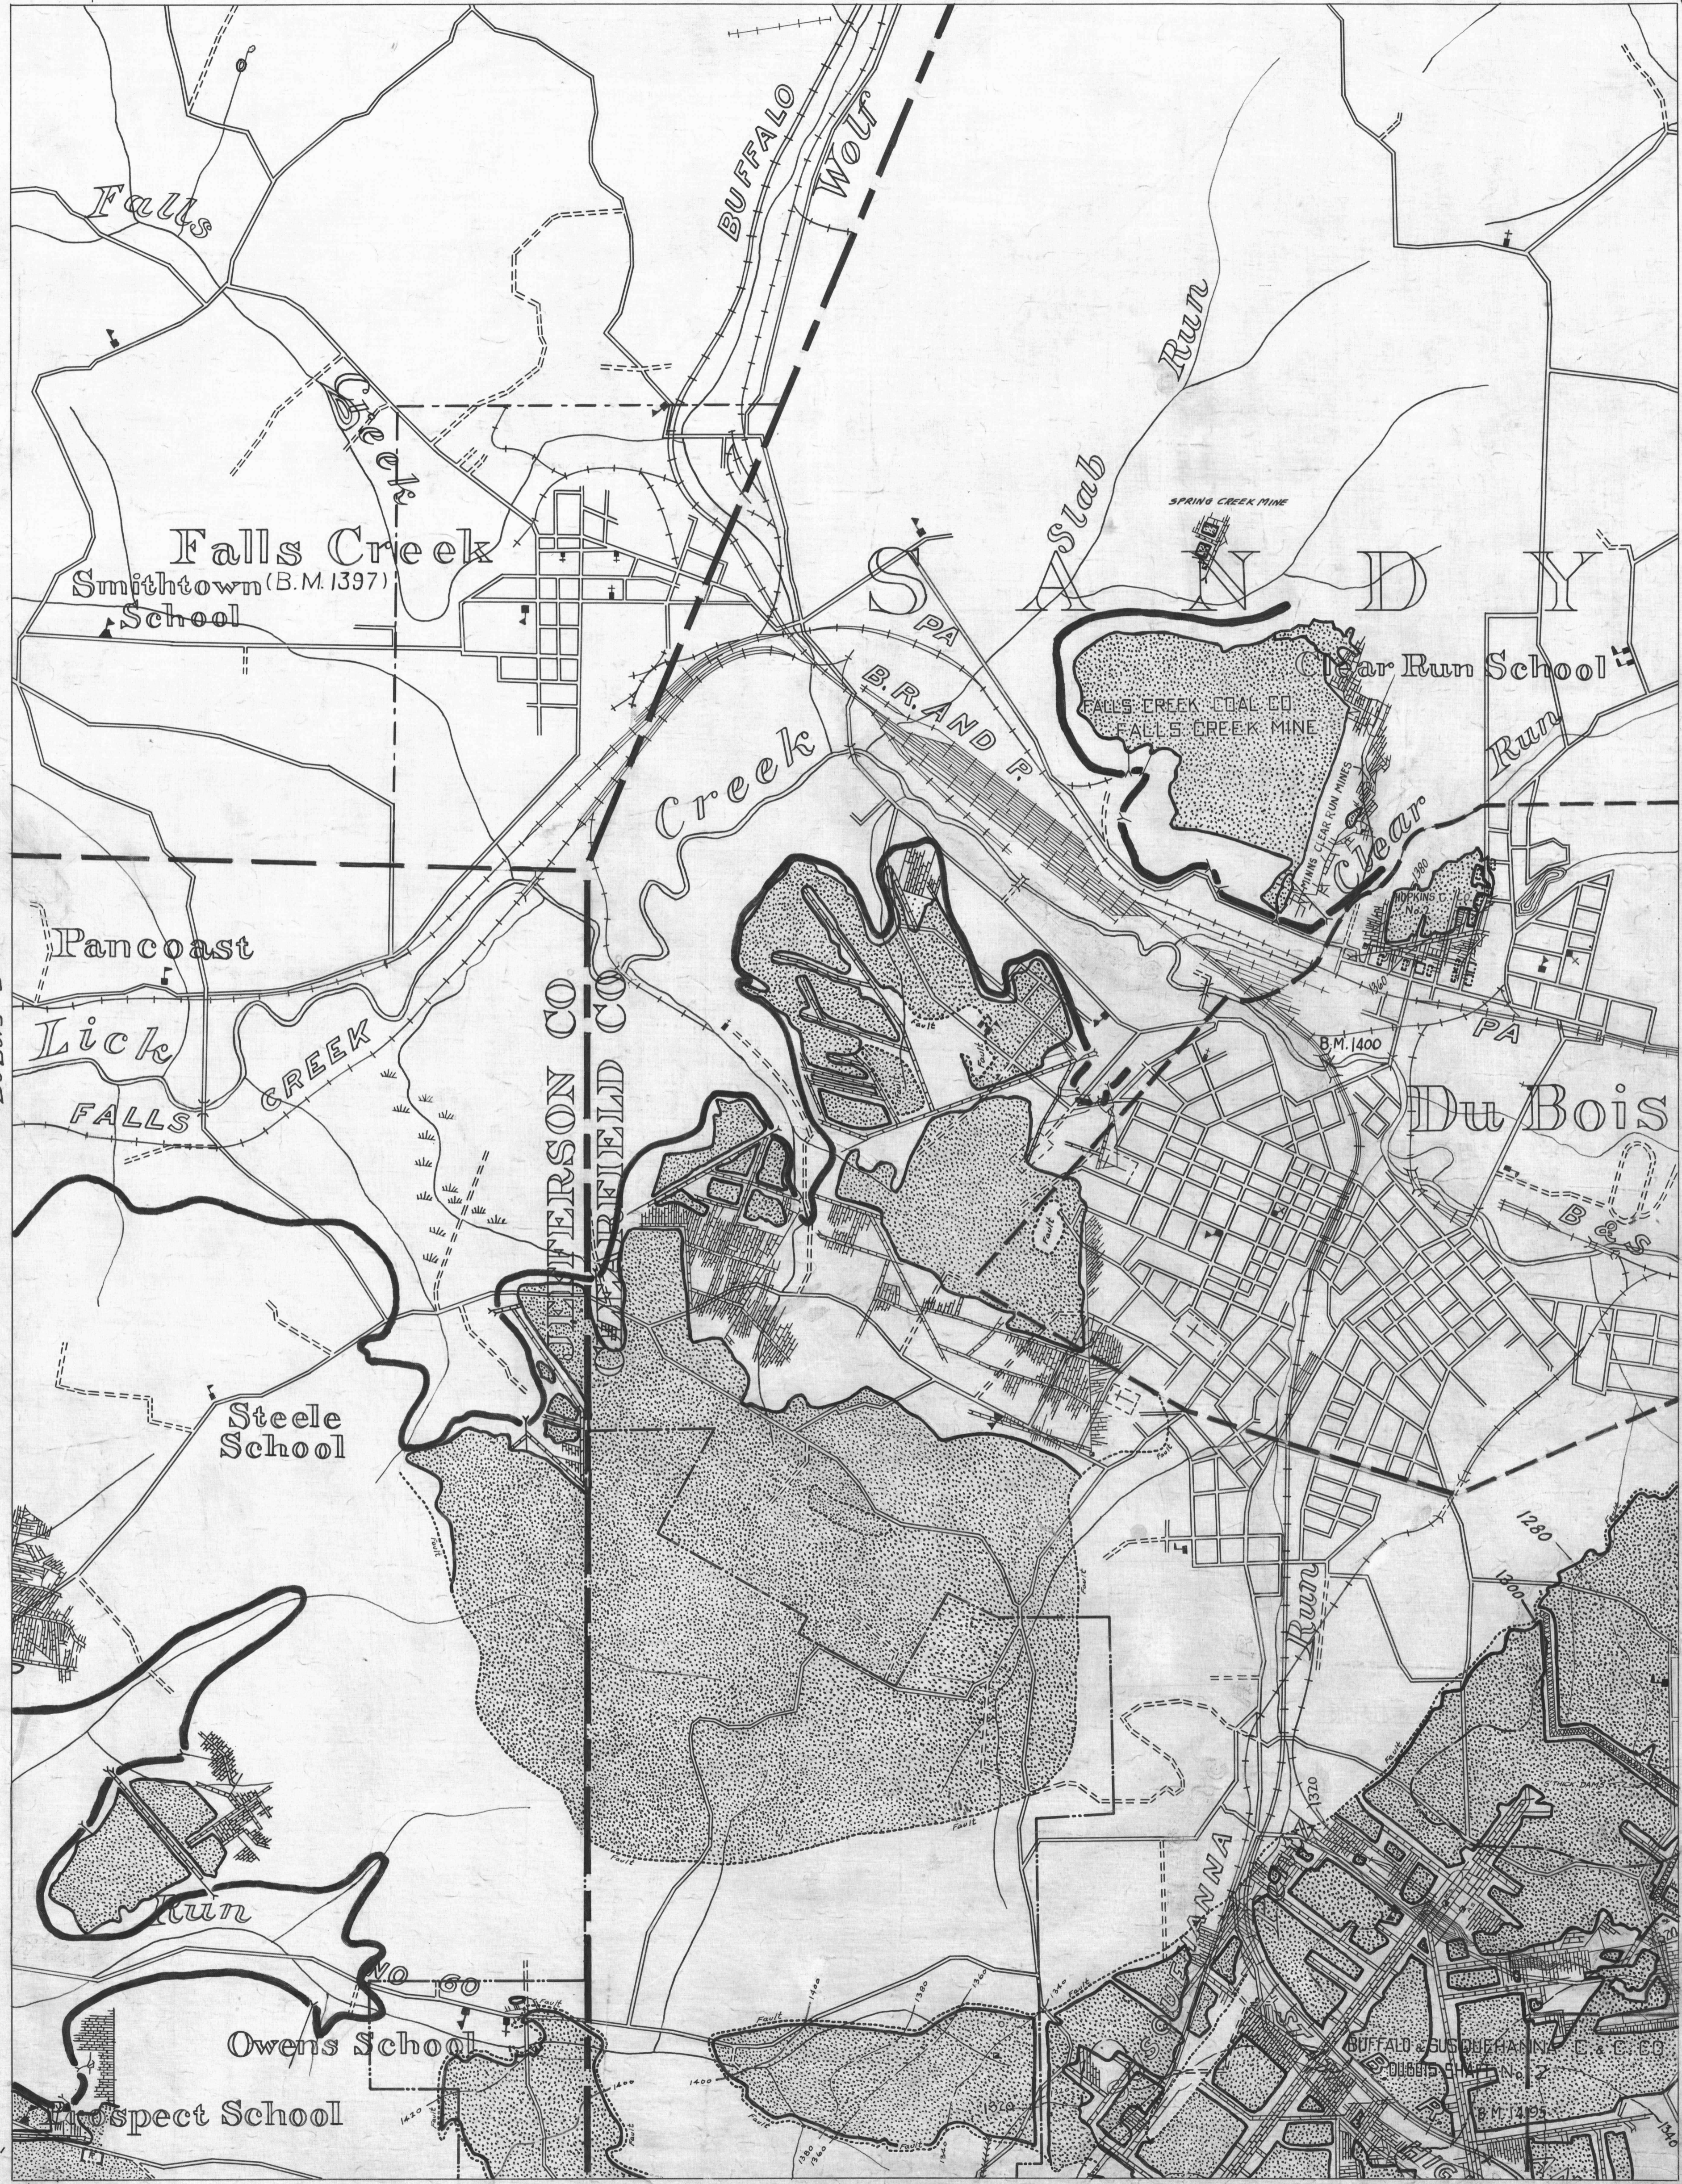

Du Bois 8 78° 50' 41° 05' Du Bois 9 Scale 2 miles DUBOIS SHEET No. 6 Lower Freeport Seams - 1f W.P.A. PROJECT No 4483 Du Bois Sheet No 6 Short DUBOIS-6