


PATTON 8 78°35' 40°30' 78°30' ALLEGANY 7 40°30'

- ACTIVE OIL WELL
- ABANDONED OIL WELL
- ★ ACTIVE GAS WELL
- ABANDONED GAS WELL

- * ACTIVE OIL & GAS WELL
- * ABANDONED OIL & GAS WELL
- ◇ DRY HOLE
- NO RECORD

- COUNTY LINES
- TOWNSHIP LINES
- BOROUGH LINES

- 980 COAL CONTOURS
- CROP LINES-SEAMS BEING MINED
- - - CROP LINES-SEAMS NOT BEING MINED

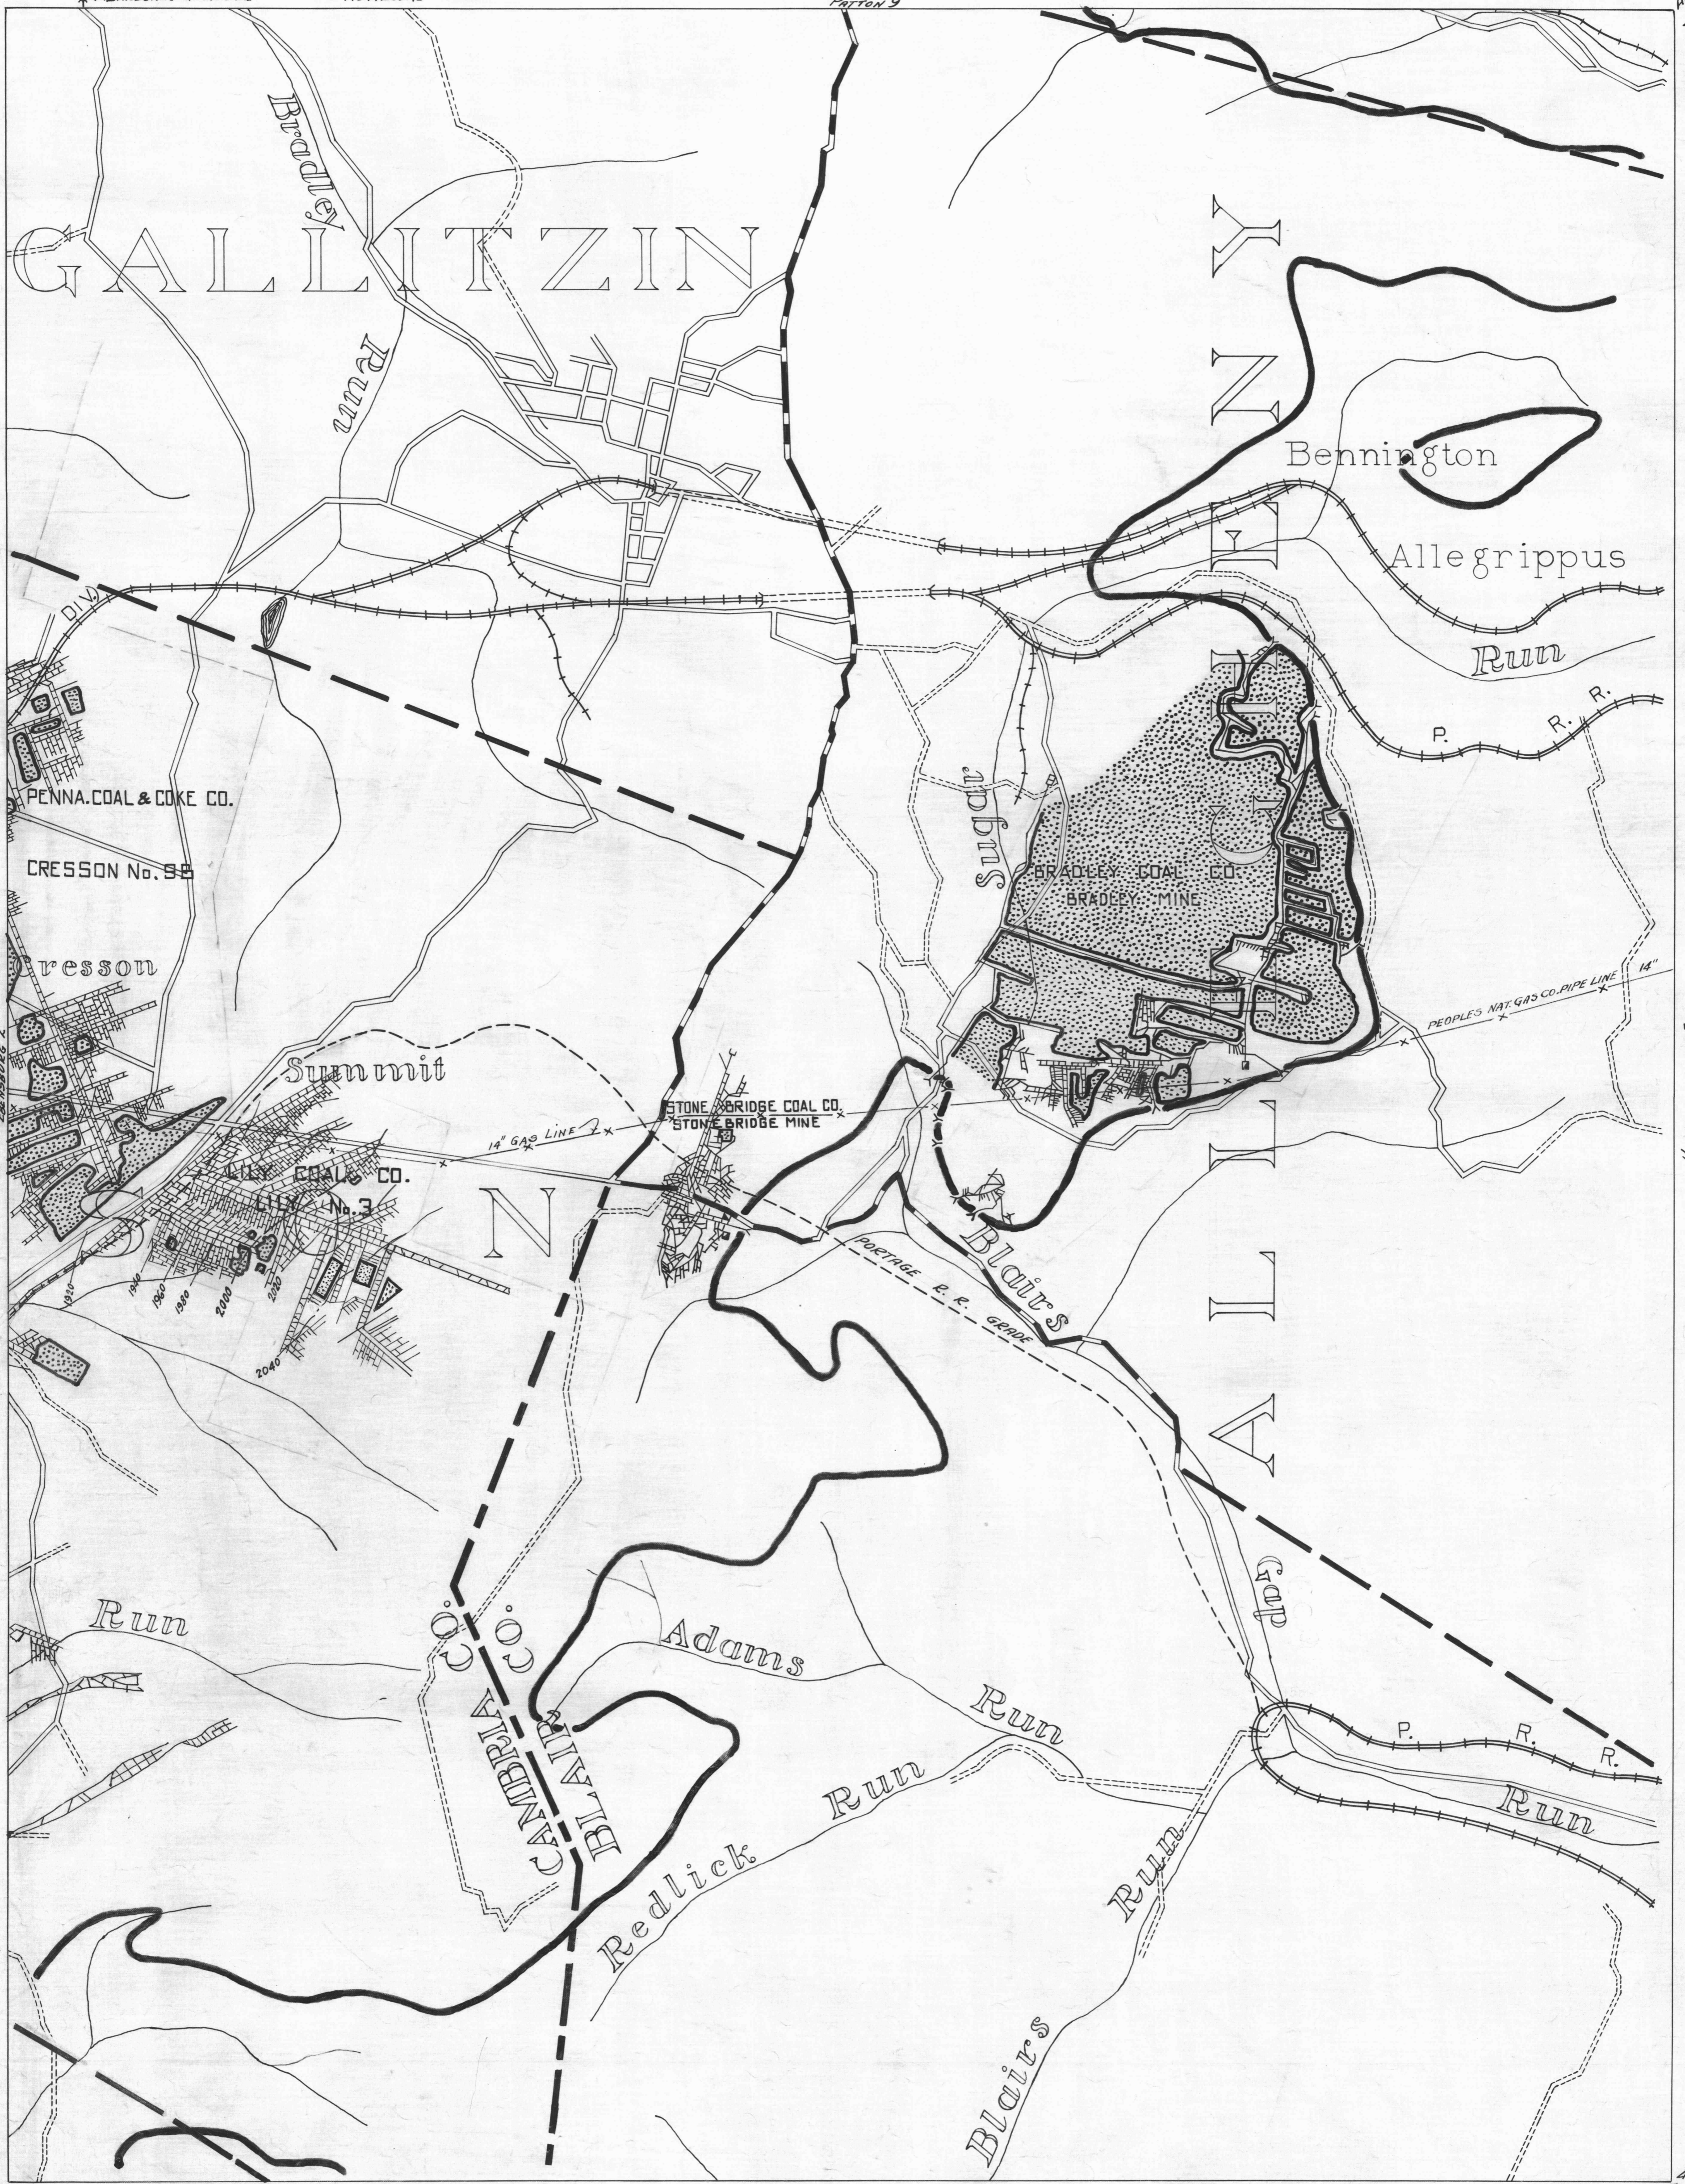

EBENSBERG 5 78°35' 40°25' EBENSBERG 6 78°30' 40°25'

- Y DRIFT OPENING
- Z SLOPE OPENING
- SHAFTS
- ▨ BARRIER PILLAR



W.P.A. PROJECT NO.4483

EBENSBERG SHEET No 3
Lower Kittanning seam - 1k