


JOHNSTOWN 6 78°45' 40°20' EBENSBURG 4

- ACTIVE OIL WELL
- ABANDONED OIL WELL
- * ACTIVE GAS WELL
- ◇ ABANDONED GAS WELL
- NO RECORD
- * ACTIVE OIL & GAS WELL
- ABANDONED OIL & GAS WELL
- ◇ DRY HOLE
- NO RECORD

— COUNTY LINES
 - - - TOWNSHIP LINES
 - - - BOROUGH LINES

980 COAL CONTOURS
 - - - CROP LINES - SEAMS BEING MINED
 - - - CROP LINES - SEAMS NOT BEING MINED

EBENSBURG 5 78°40' 40°20'

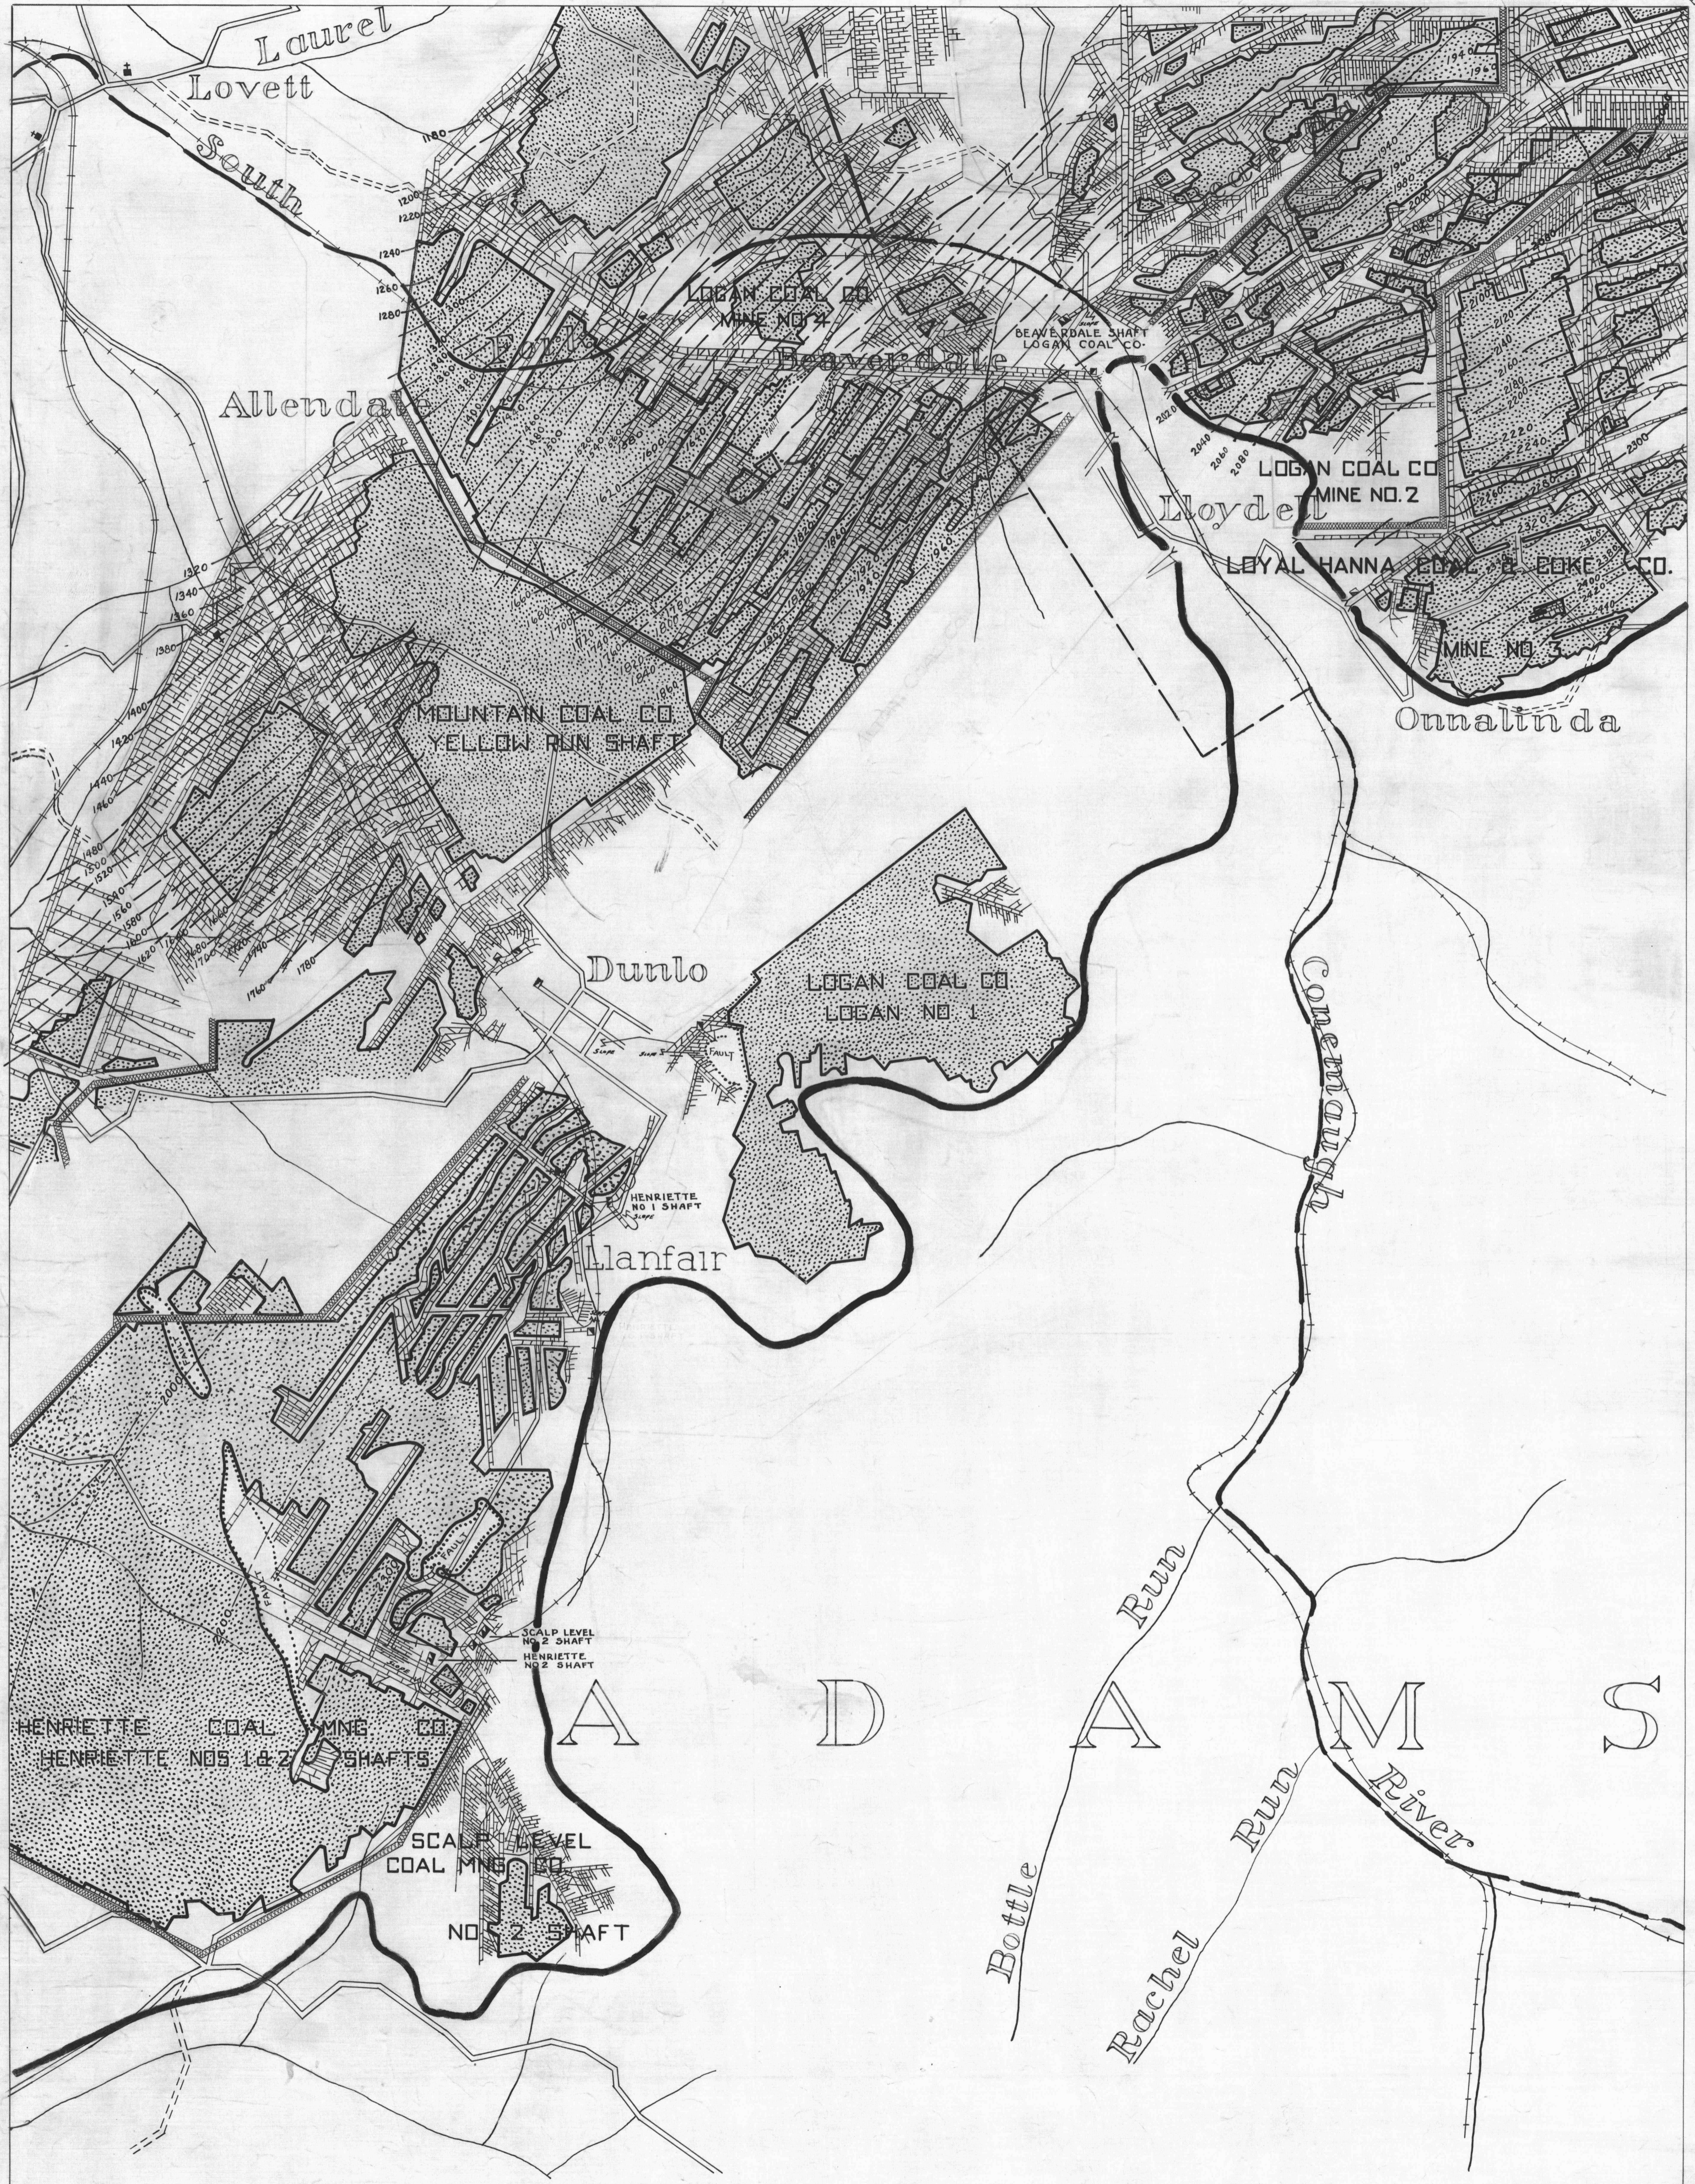

JOHNSTOWN 9 78°45' 40°15' WINDBER 3

— DRIFT OPENING ▤ BARRIER PILLAR
 - - - SLOPE OPENING
 □ SHAFTS

BEDFORD 1

0 1 2 3 4 5 6 7 8 9 10 MILES

W.P.A. PROJECT NO. 4483

EBENSBURG SHEET No. 7
 LOWER KITTANNING SEAM

EBENSBURG 8 78°40' 40°15' BEDFORD 2