


Johnstown 6
32000 E
Ebensburg 4
COAL CONTOURS
CROP LINES-SEAM BEING MINED
CROP LINES-SEAM NOT BEING MINED
18° 40'
Ebensburg 5

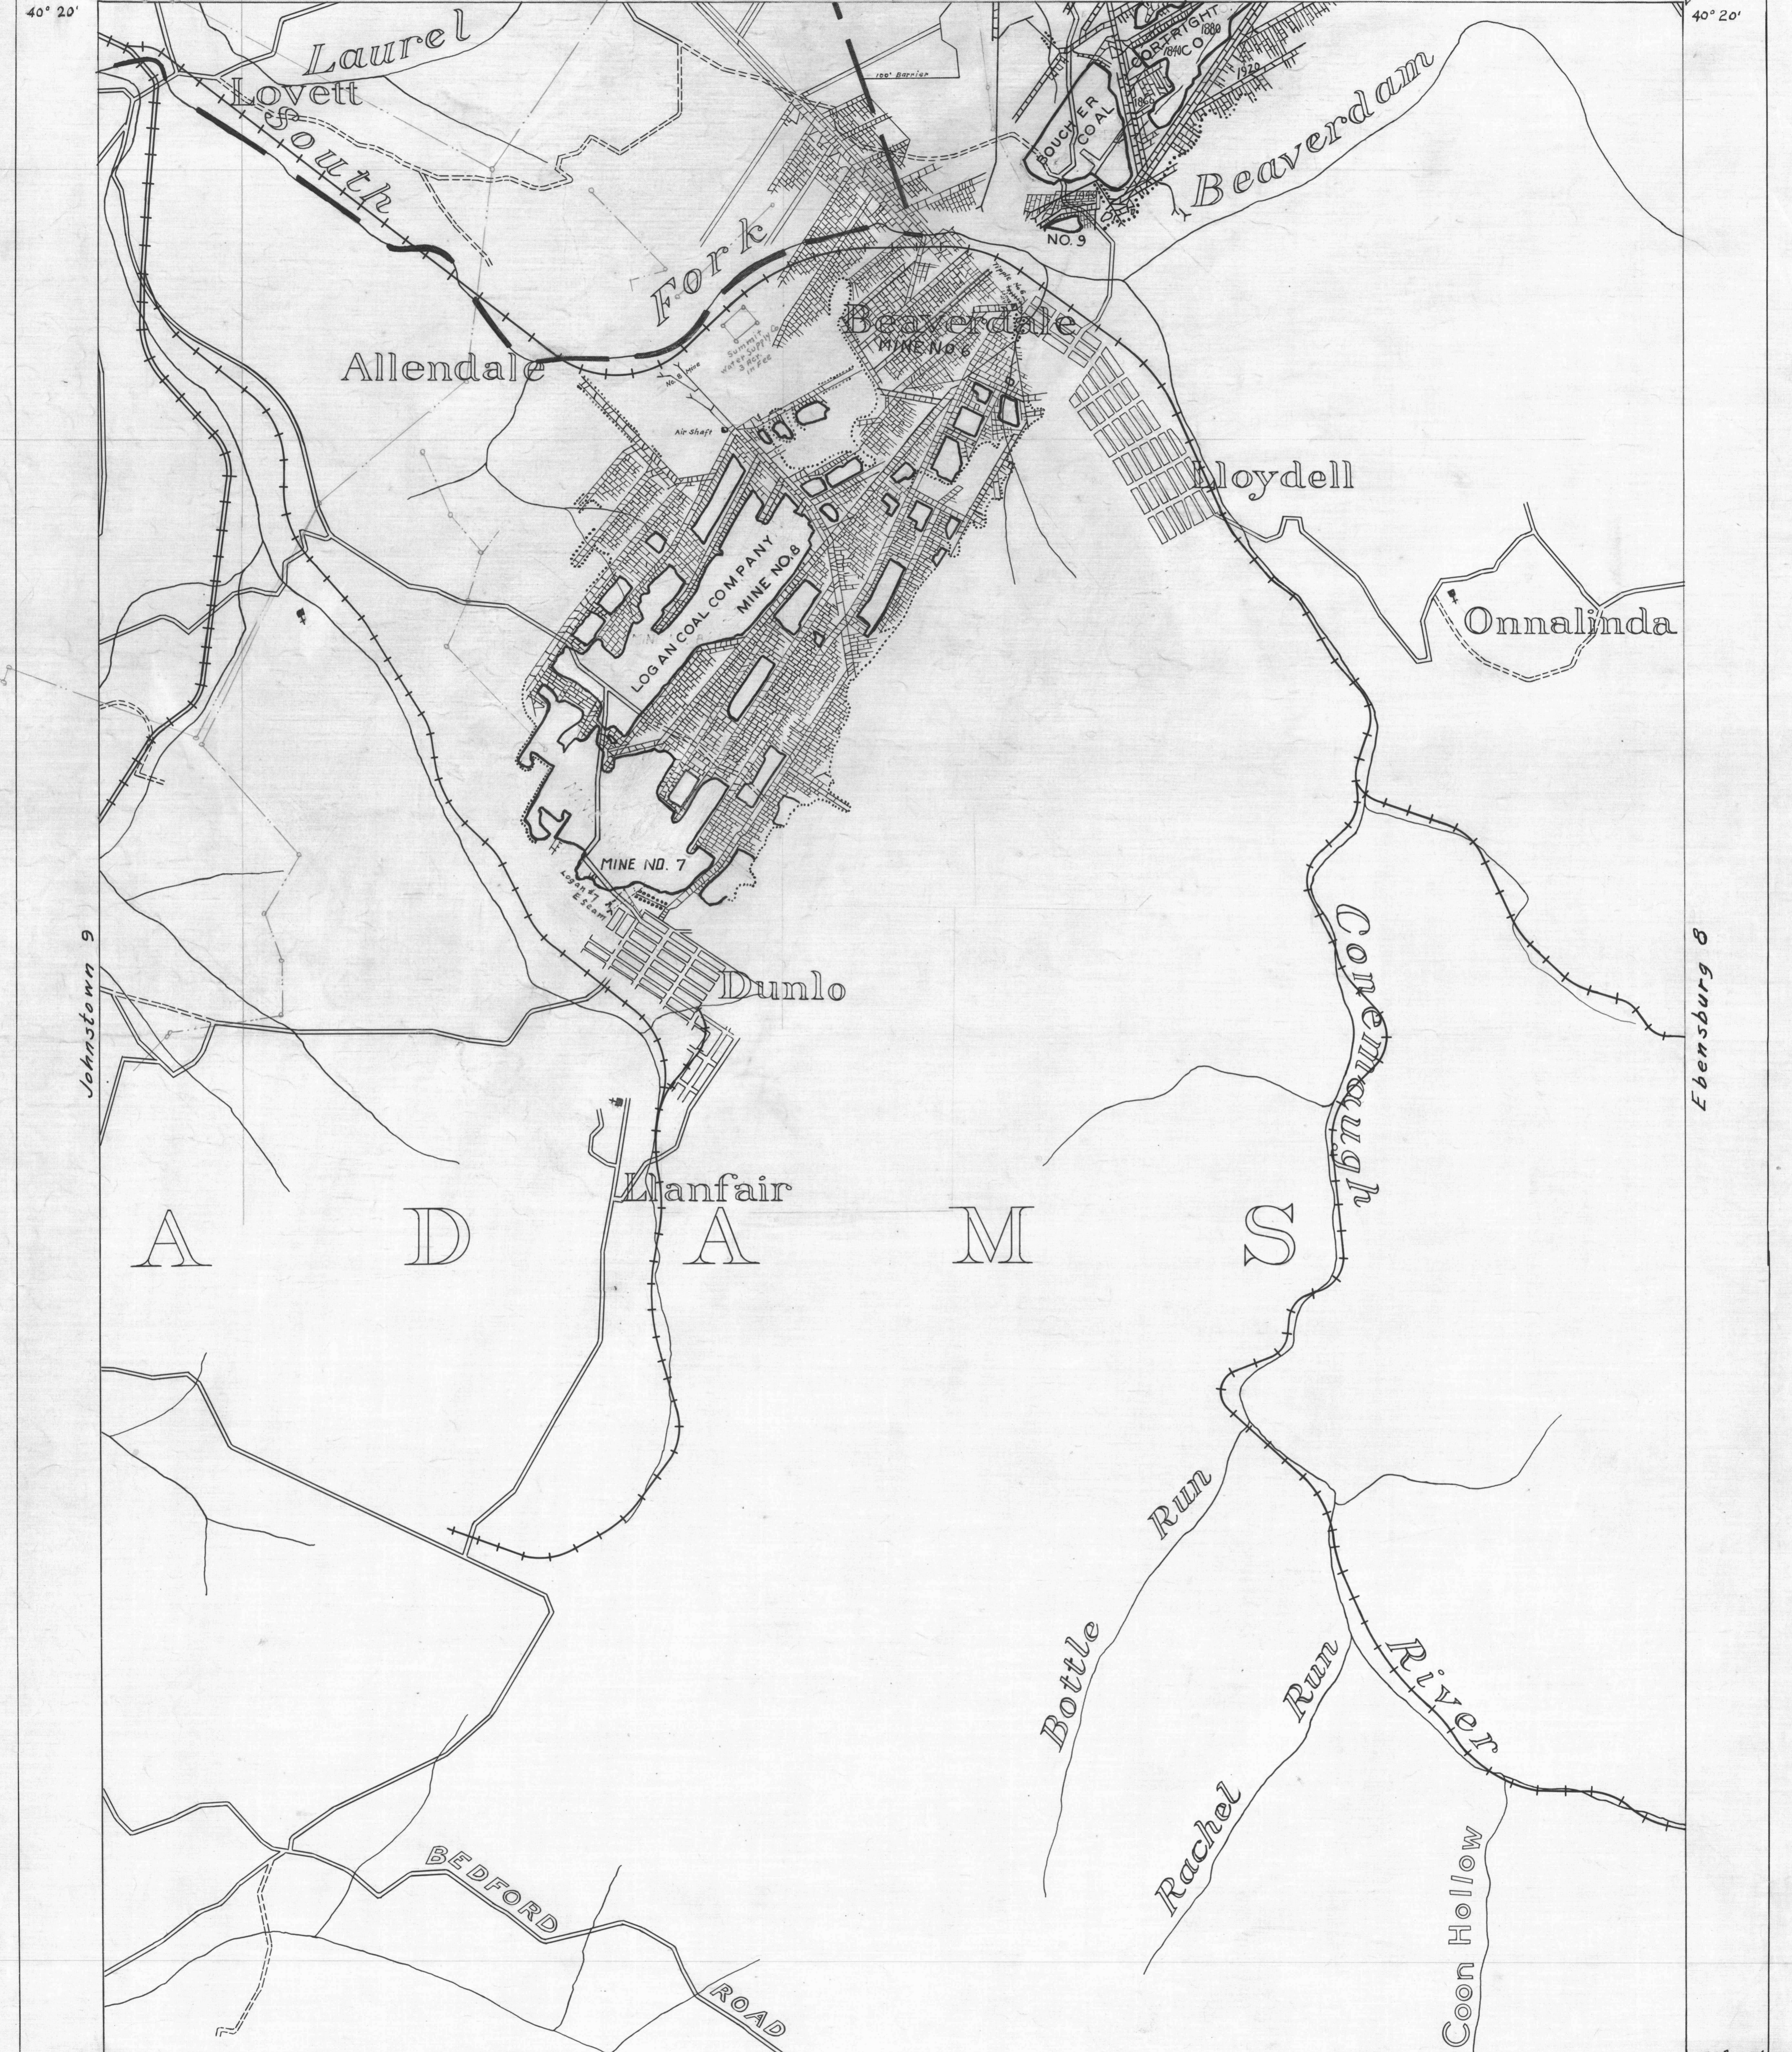

40° 20'
Johnstown 9
MINE MAP DEPARTMENT 1936
0 1/2 1
Bedford 1
2 MILES
D Seam
EBENSBURG SHEET NO. 7
LOWER FREEPORT L.F.
40° 15'
Bedford 2

W. P. A. PROJECT N°65-23-5001 & 465-23-3-192