


- ACTIVE OIL WELL
- ABANDONED OIL WELL
- ⊛ ACTIVE GAS WELL
- ⊛ ABANDONED GAS WELL
- ⊛ ACTIVE OIL & GAS WELL
- ⊛ ABANDONED OIL & GAS WELL
- DRY HOLE
- NO RECORD

- COUNTY LINES
- TOWNSHIP LINES
- BOROUGHS LINES
- 980 COAL CONTOURS
- pb CROP LINES - SEAM BEING MINED
- - - CROP LINES - SEAMS NOT BEING MINED

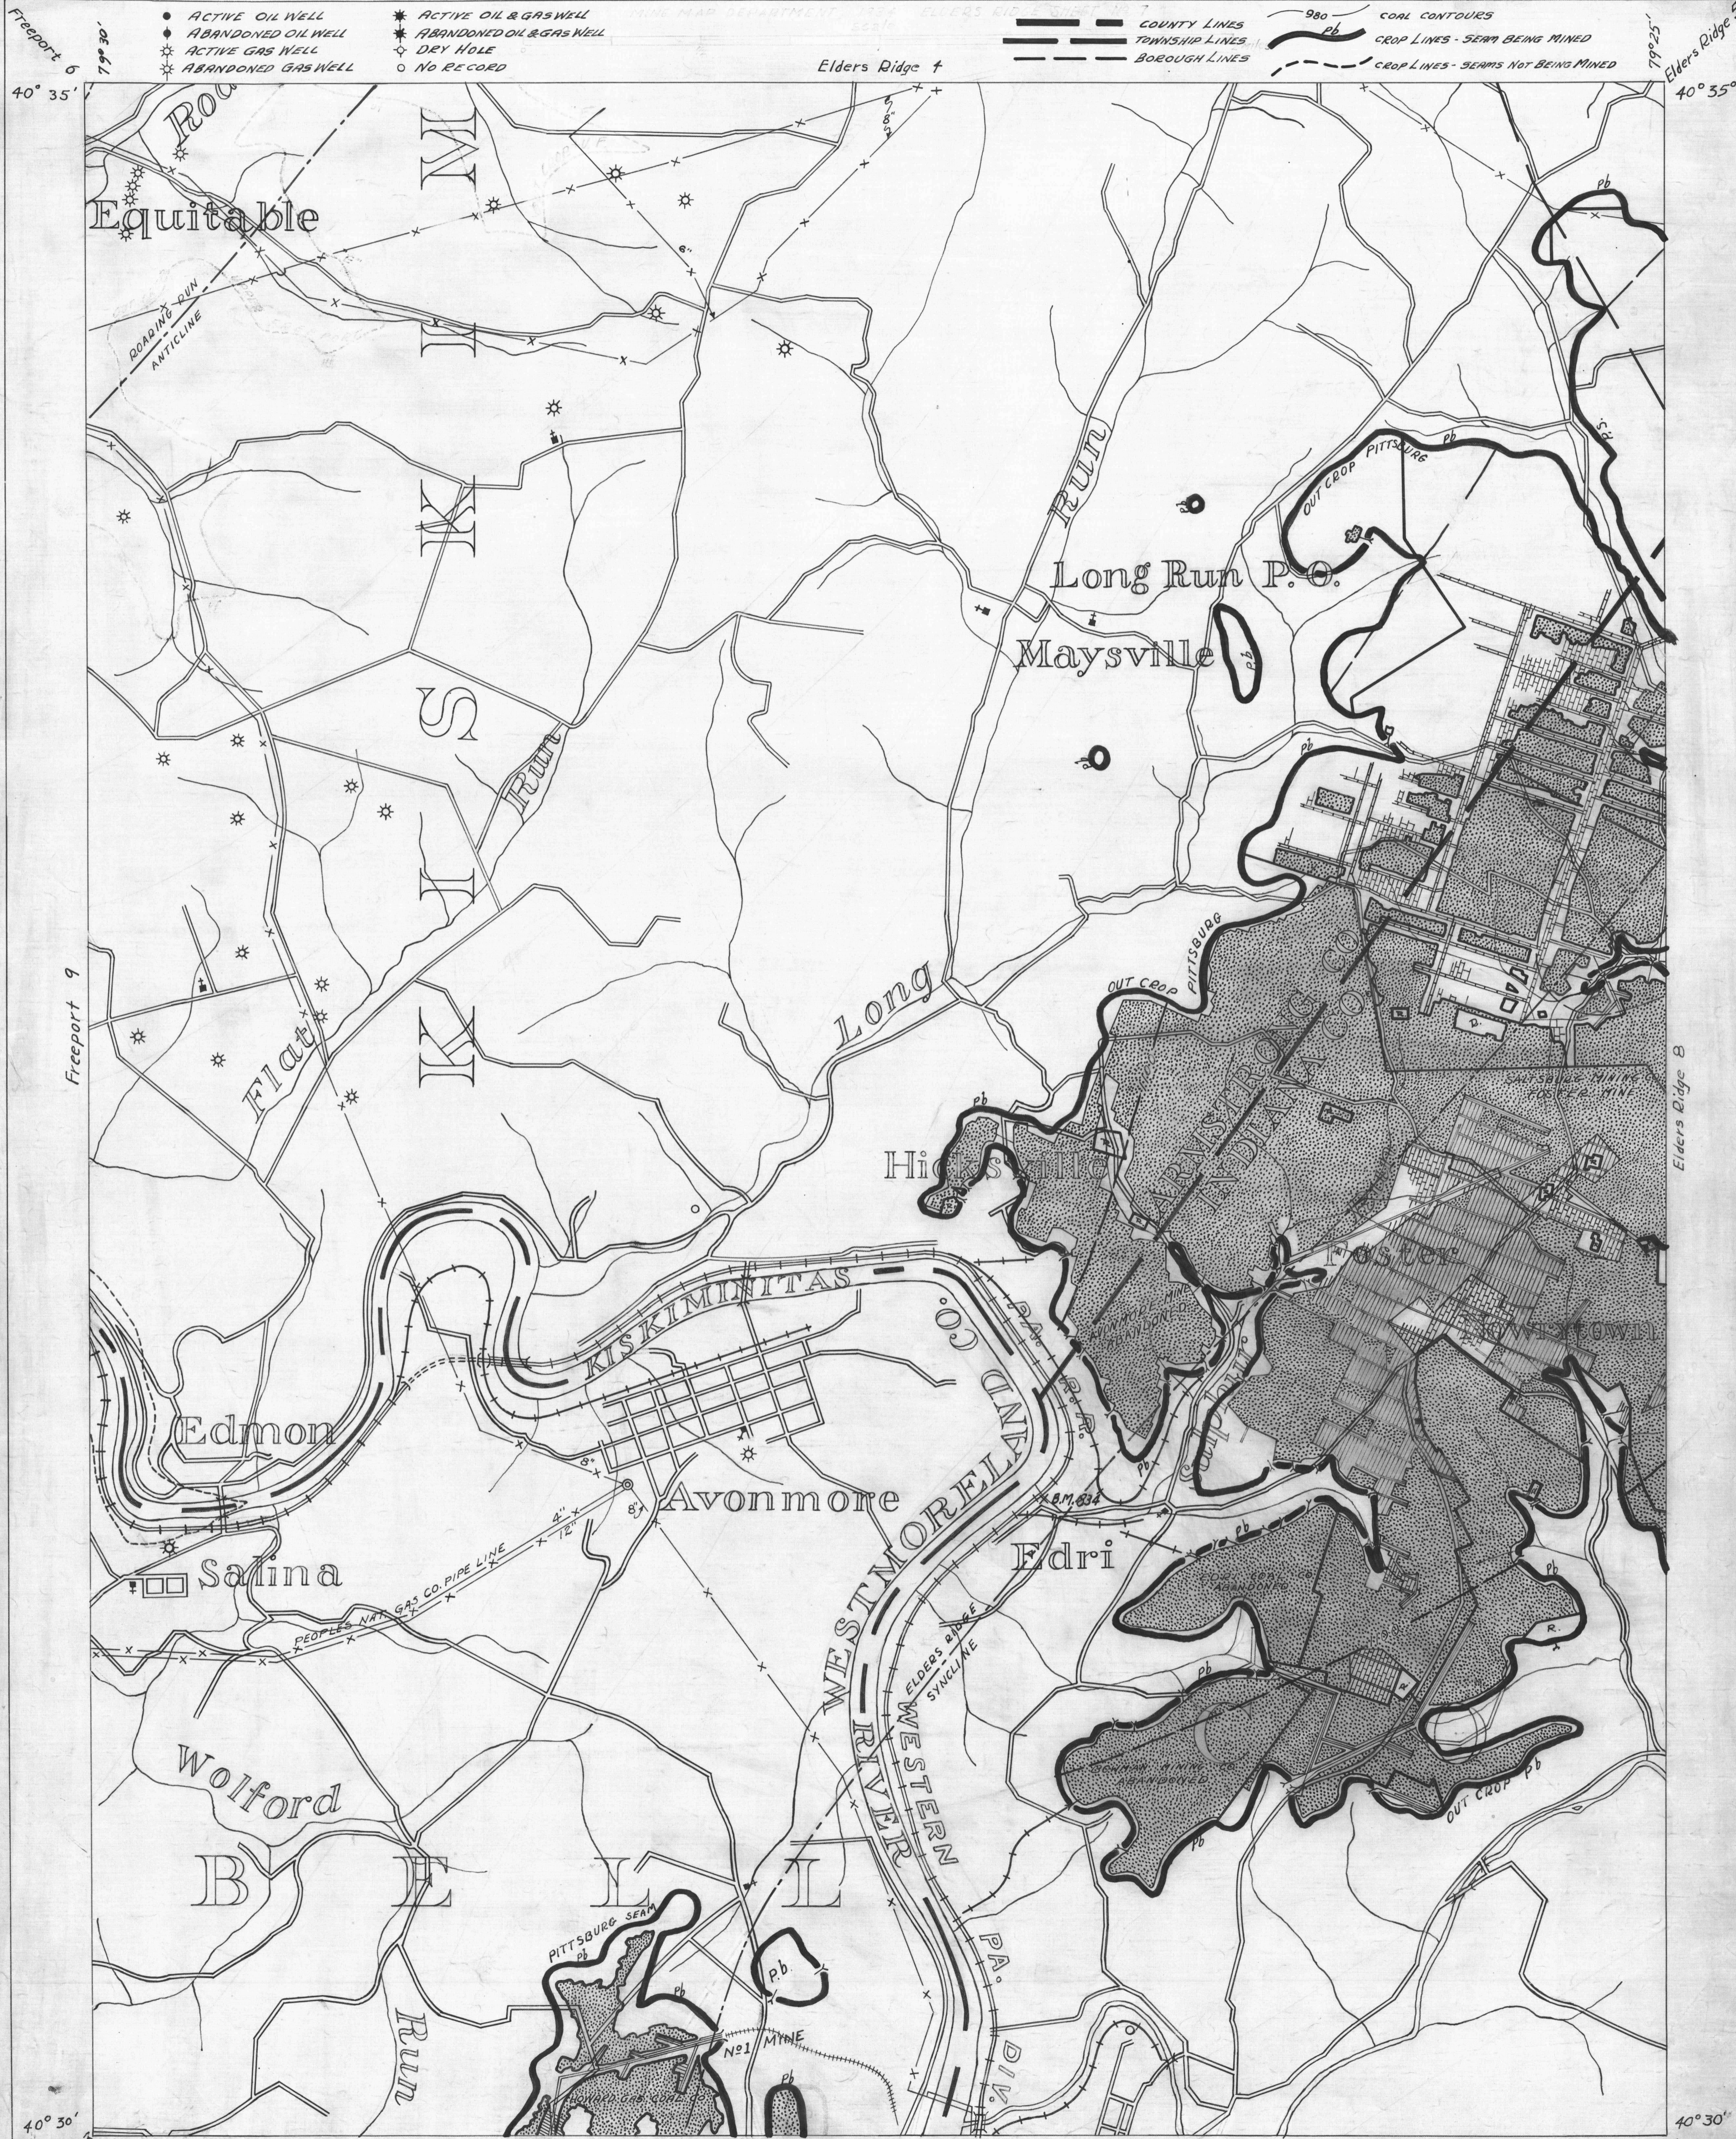

