


KITTANNING 8  
 40° 45' 79° 40'

- ACTIVE OIL WELL
- ABANDONED OIL WELL
- ★ ACTIVE GAS WELL
- ABANDONED GAS WELL
- ★ ACTIVE OIL & GAS WELL
- ABANDONED OIL & GAS WELL
- ◇ DRY HOLE
- NO RECORD

- COUNTY LINES
- TOWNSHIP LINES
- BOROUGH LINES
- 000 COAL CONTOURS
- CROP LINES - SEAM BEING MINED
- CROP LINES - SEAMS NOT BEING MINED


Kittanning 8

BOWERS COAL CO. CADSWAN NS2

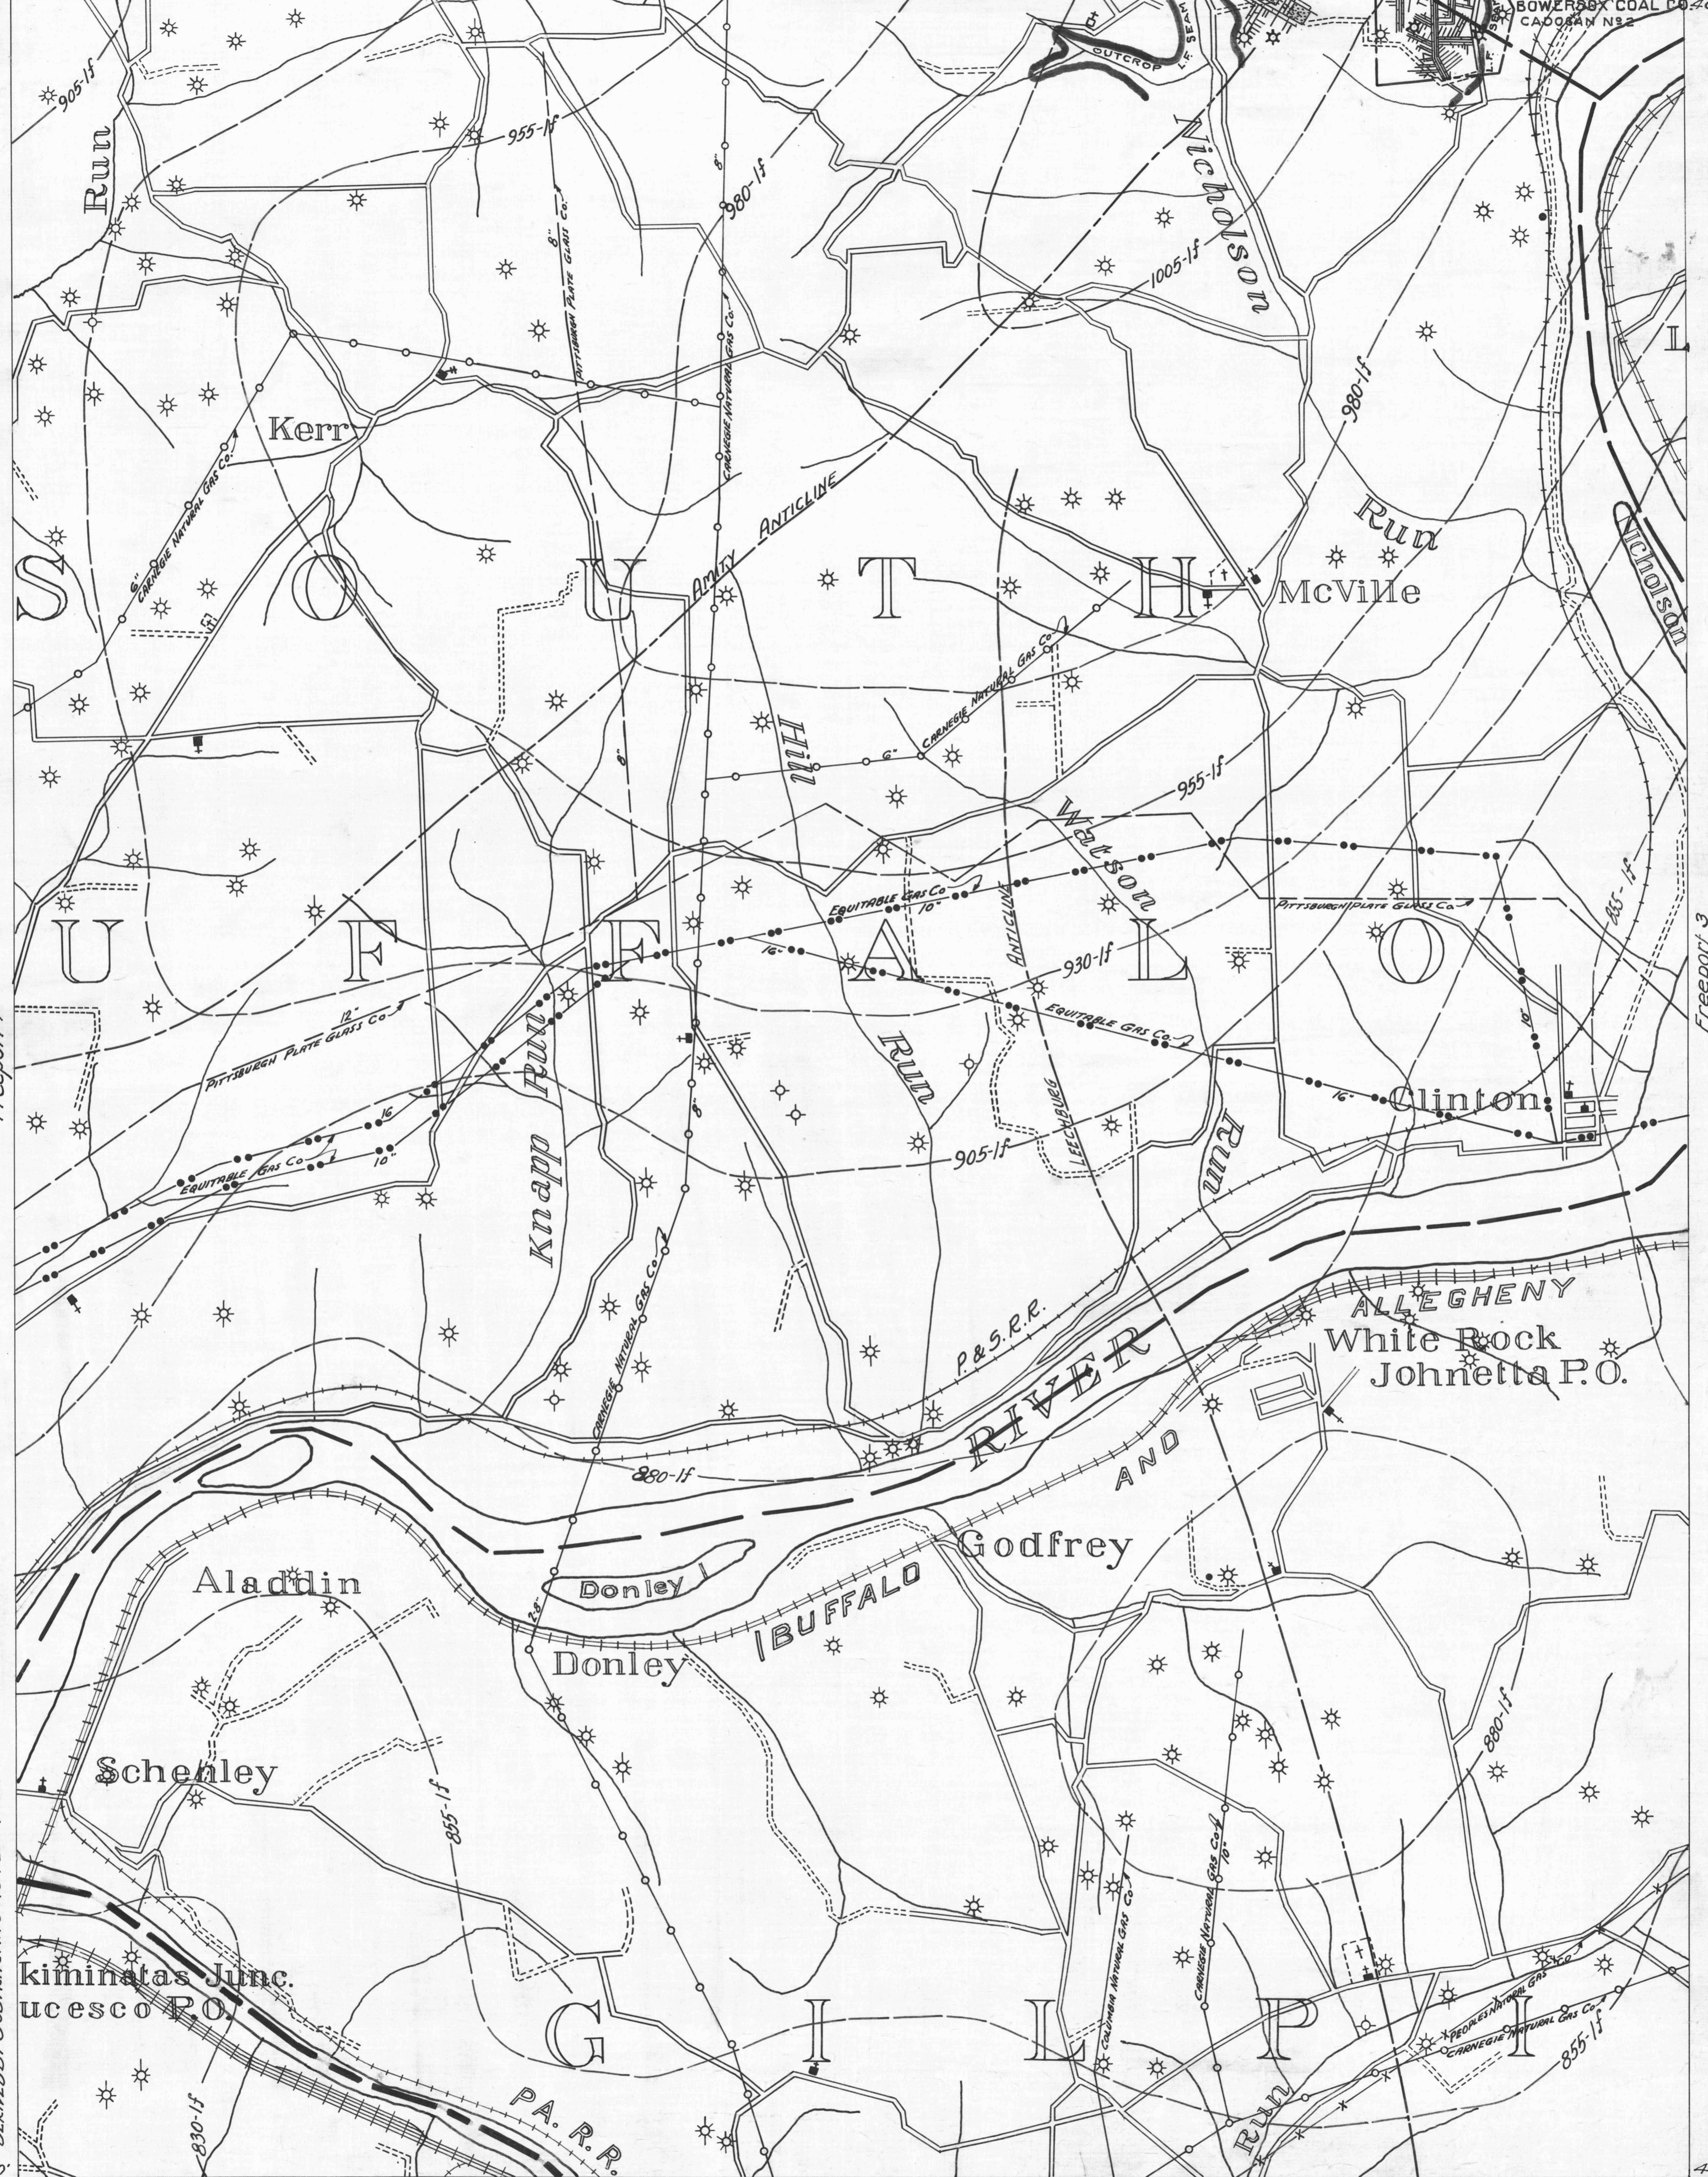

NOTE: CONTOURS MARKED (lf) ARE FOR LOWER FREEPOET SEAM AND ARE DERIVED BY SUBTRACTING 45 FEET FROM UPPER FREEPOET CONTOURS

- Y DRIFT OPENING
- Z SLOPE OPENING
- SHAFTS
- ▨ BARRIER PILLAR

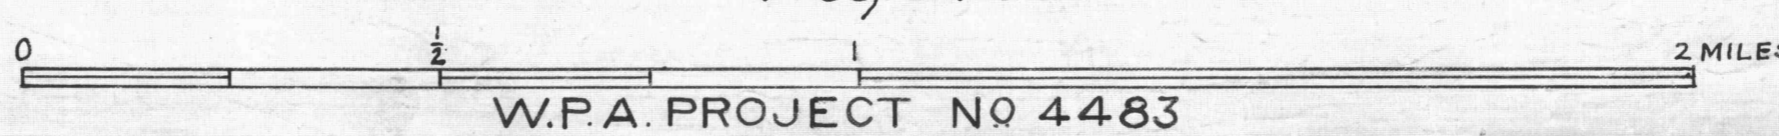

W.P.A. PROJECT NO 4483

FREEPORT SHEET No. 2. (D)-L.F. SEAM.

40° 40' 79° 40' Freepoint 4 Freepoint 5 Freepoint 6