


● ACTIVE OIL WELL      \* ACTIVE OIL & GAS WELL      ——— COUNTY LINES      980 — COAL CONTOURS  
 ○ ABANDONED OIL WELL      \* ABANDONED OIL & GAS WELL      - - - - - TOWNSHIP LINES      ——— CROP LINES-SEAM BEING MINED  
 \* ACTIVE GAS WELL      \* DRY HOLE      - - - - - BOROUGH LINES      - - - - - CROP LINES-SEAMS NOT BEING MINED  
 \* ABANDONED GAS WELL      ○ NO RECORD

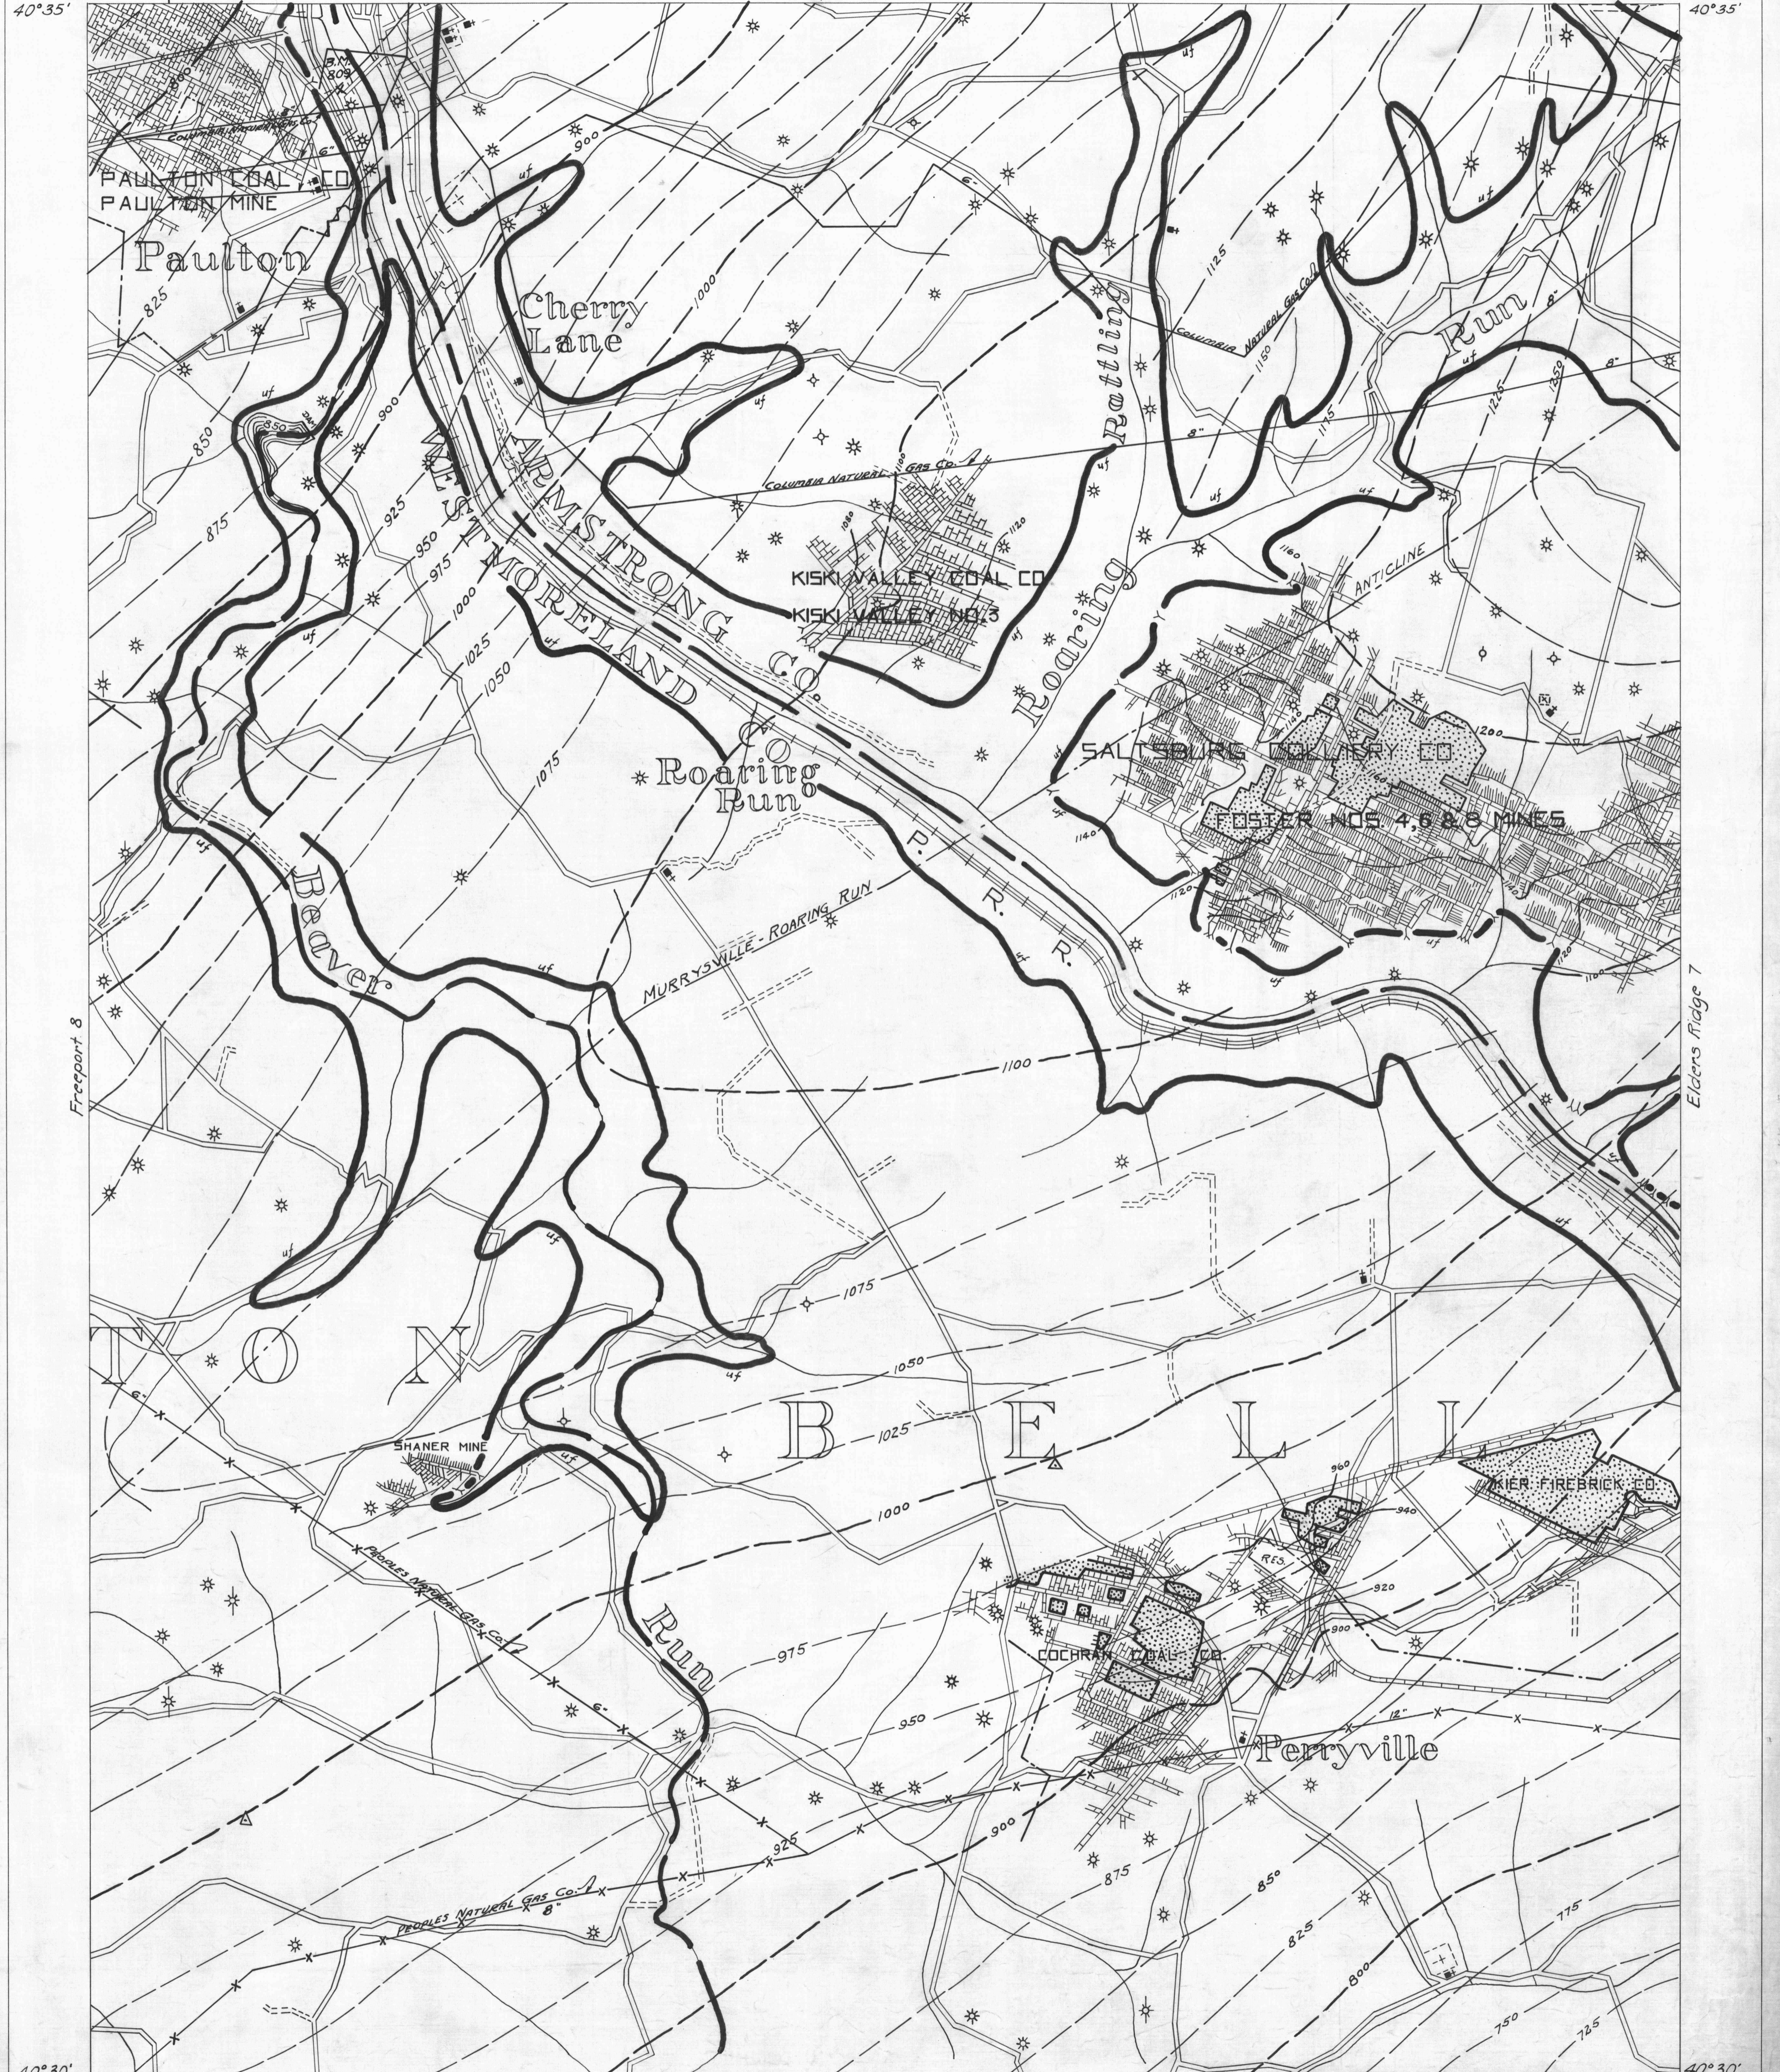

— Y — DRIFT OPENING  
 — Z — SLOPE OPENING  
 — □ — SHAFTS  
 — ▨ — BARRIER PILLAR

0 1/2 1 2 MILES  
 W.P.A. PROJECT NO 4483  
 FREEPORT SHEET NO. 9  
 UPPER FREEPORT SEAM -uf