

Greensburg 1
40° 40'

- ACTIVE OIL WELL
- ◆ ABANDONED OIL WELL
- ⊛ ACTIVE GAS WELL
- ⊛ ABANDONED GAS WELL
- ⊛ ACTIVE OIL & GAS WELL
- ⊛ ABANDONED OIL & GAS WELL
- DRY HOLE
- NO RECORD


Greensburg 2

- COUNTY LINES
- TOWNSHIP LINES
- BOROUGH LINES
- 980-Pb COAL CONTOURS
- CROP LINES - SEAM BEING MINED
- CROP LINES - SEAMS NOT BEING MINED

Greensburg 3
40° 35'

Greensburg 4


Greensburg 6

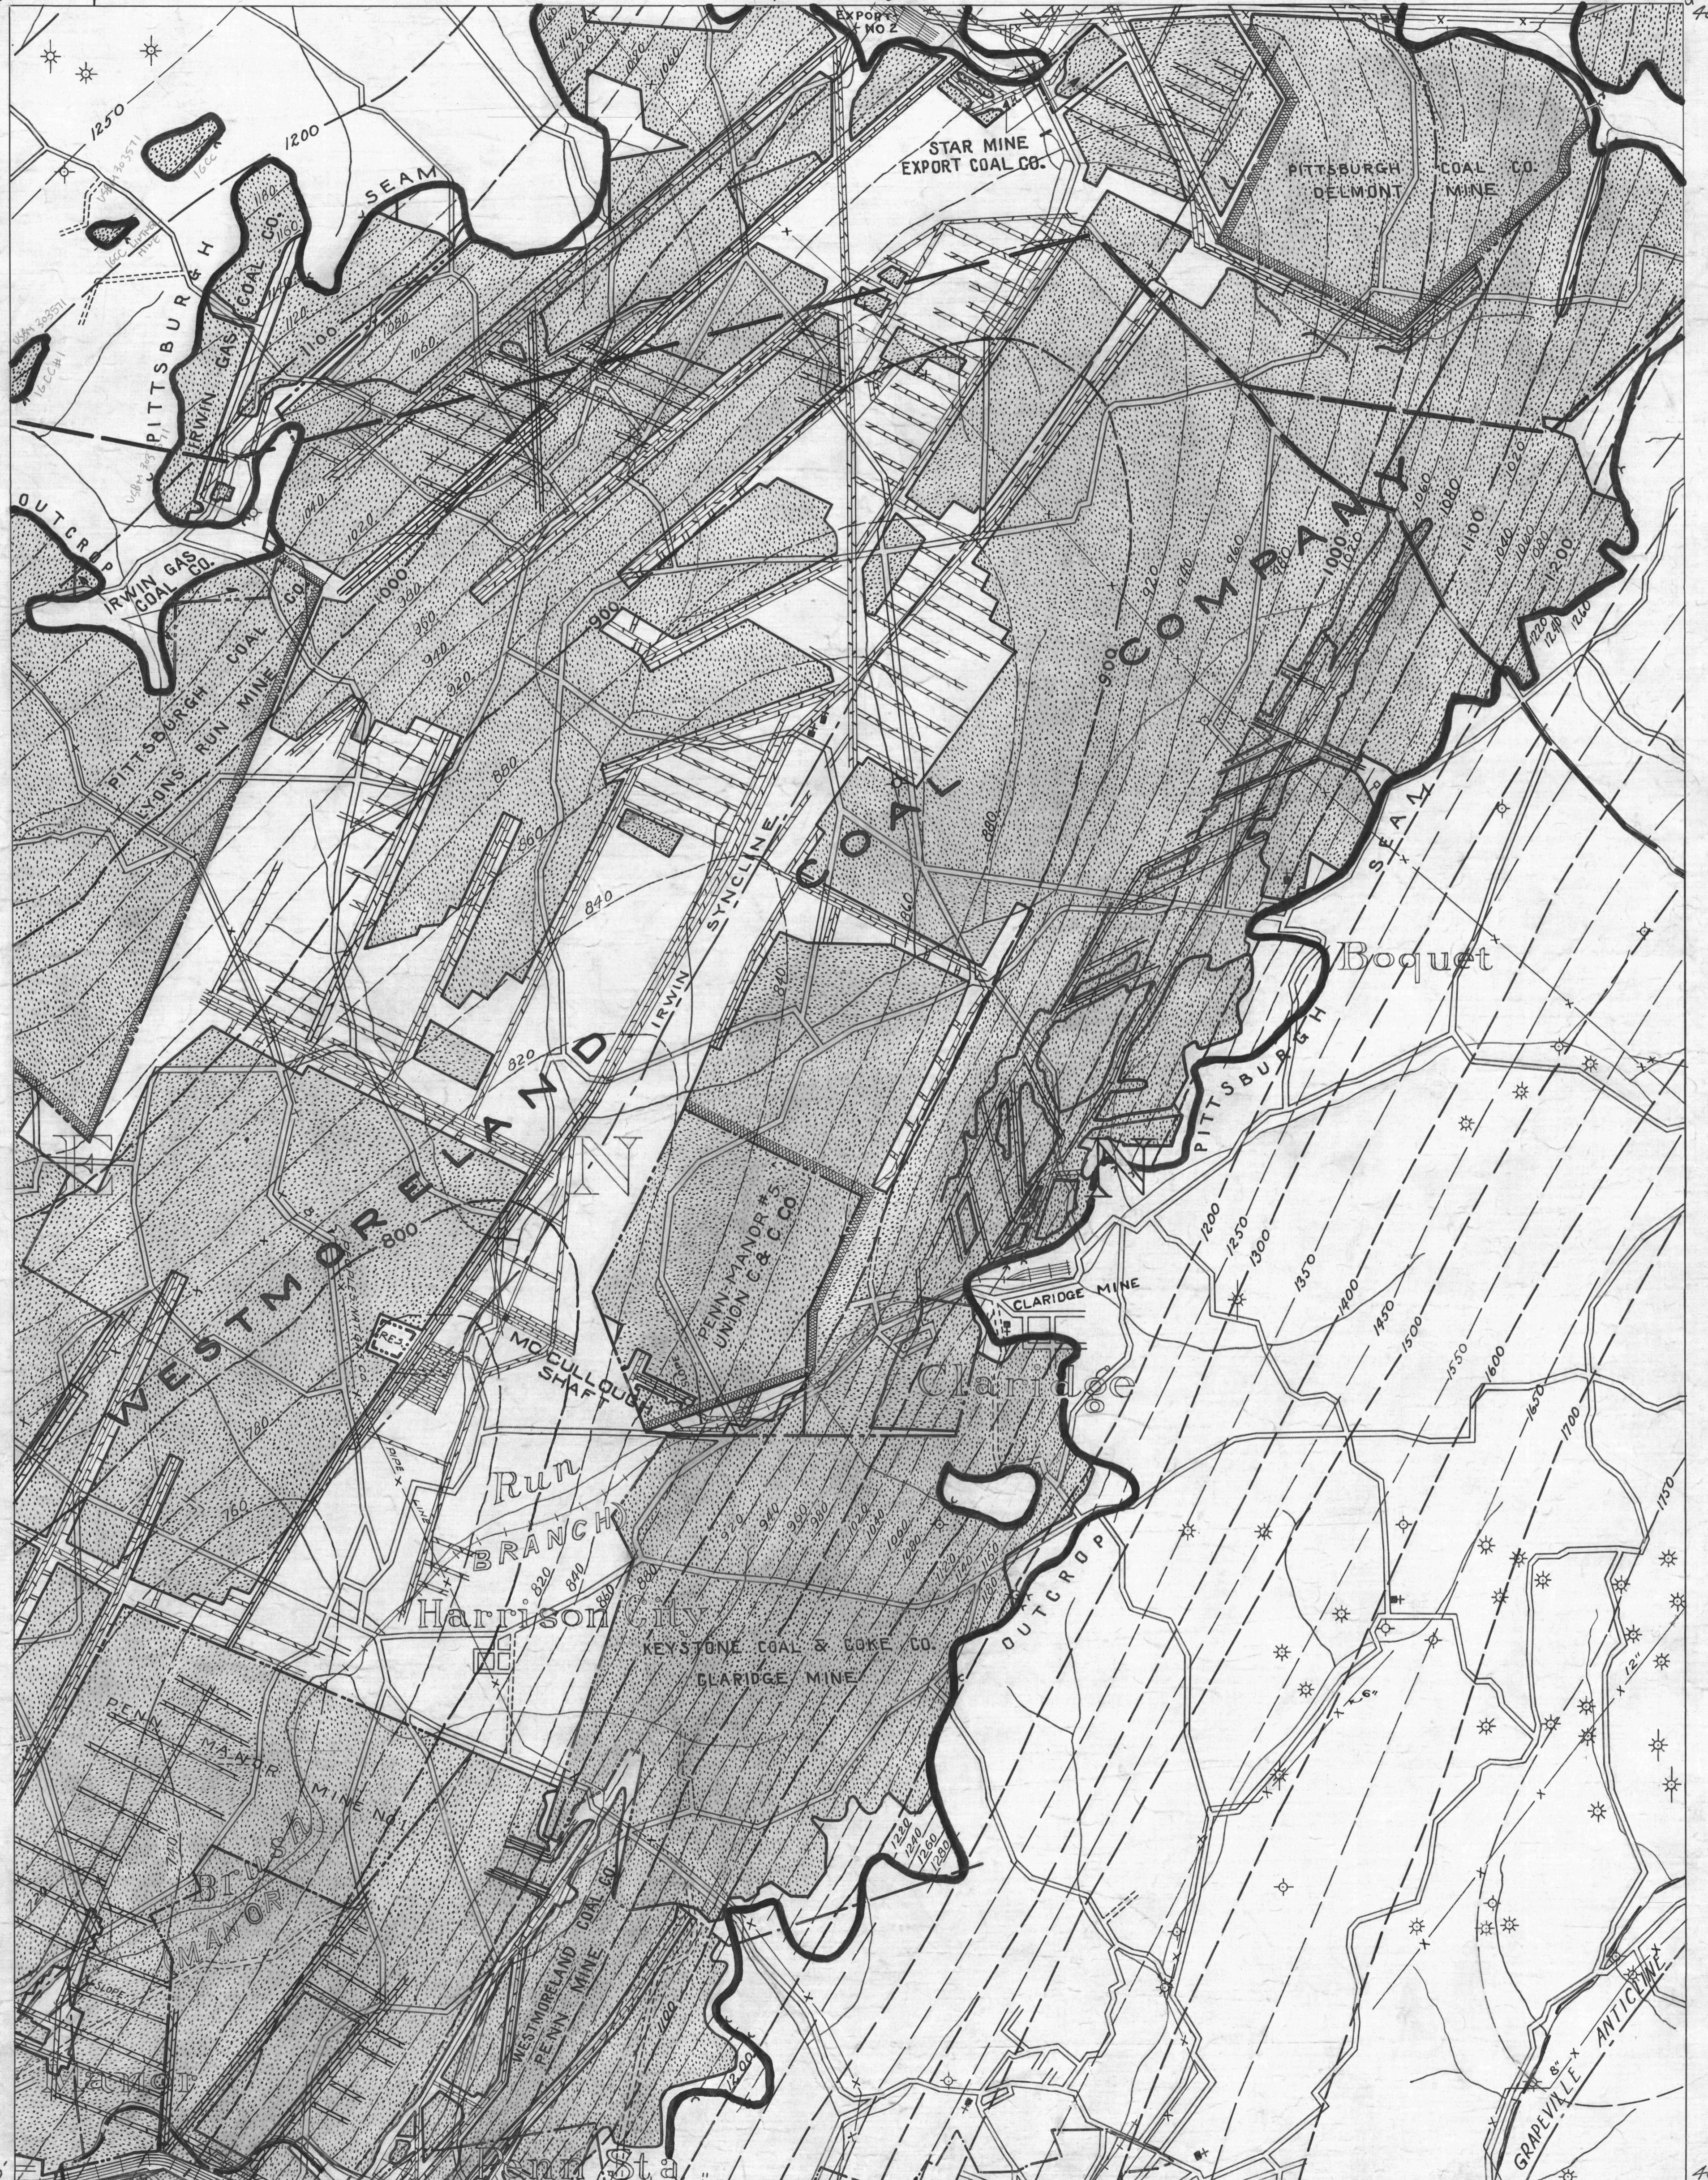

Greensburg 7
40° 20'

Greensburg 8
40° 20'

- DRIFT OPENING
- SLOPE OPENING
- SHAFTS
- ▨ BARRIER PILLAR

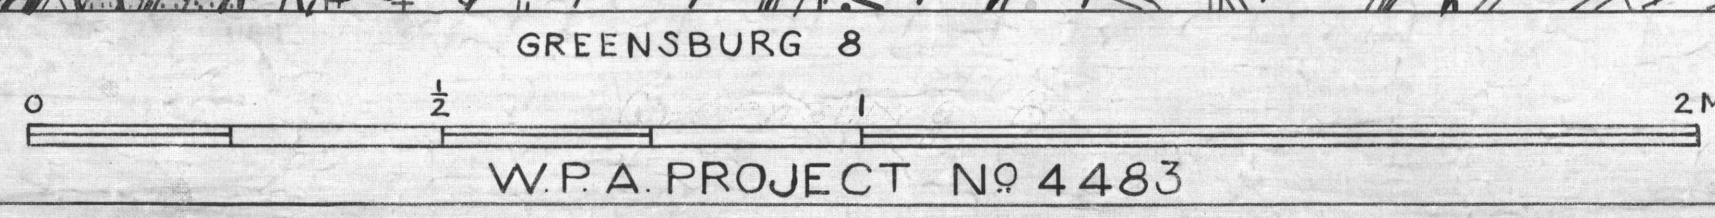

2 MILES GREENSBURG SHEET No. 5. PITTSBURGH SEAM.