

INDIANA 4

40° 35'



- ACTIVE OIL WELL
- ABANDONED OIL WELL
- ✱ ACTIVE GAS WELL
- ✱ ABANDONED GAS WELL
- ✱ ACTIVE OIL & GAS WELL
- ✱ ABANDONED OIL & GAS WELL
- DRY HOLE
- NO RECORD

- COUNTY LINES
- TOWNSHIP LINES
- BOROUGH LINES

- COAL CONTOURS
- CROP LINES - SEAM BEING MINED
- CROP LINES - SEAMS NOT BEING MINED

INDIANA 6

40° 35'


INDIANA 7

INDIANA 9

40° 30'

NEW FLORENCE 1

- DRIFT OPENING
- SLOPE OPENING
- SHAFTS
- ▨ BARRIER PILLAR

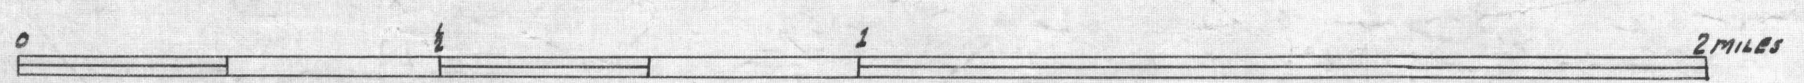

W.P.A. PROJECT NO 4483

INDIANA SHEET No. 8  
UPPER FREEPORT SEAM - U.F.

40° 30'

NEW FLORENCE 3