


Johnstown 3
COUNTY LINES
TOWNSHIP LINES
BOROUGH LINES
COAL CONTOURS
CROP LINES - SEAM BEING MINED
CROPLINES - SEAM NOT BEING MINED

Johnstown 2
78° 50'

78° 45'

40° 25'

40° 25'

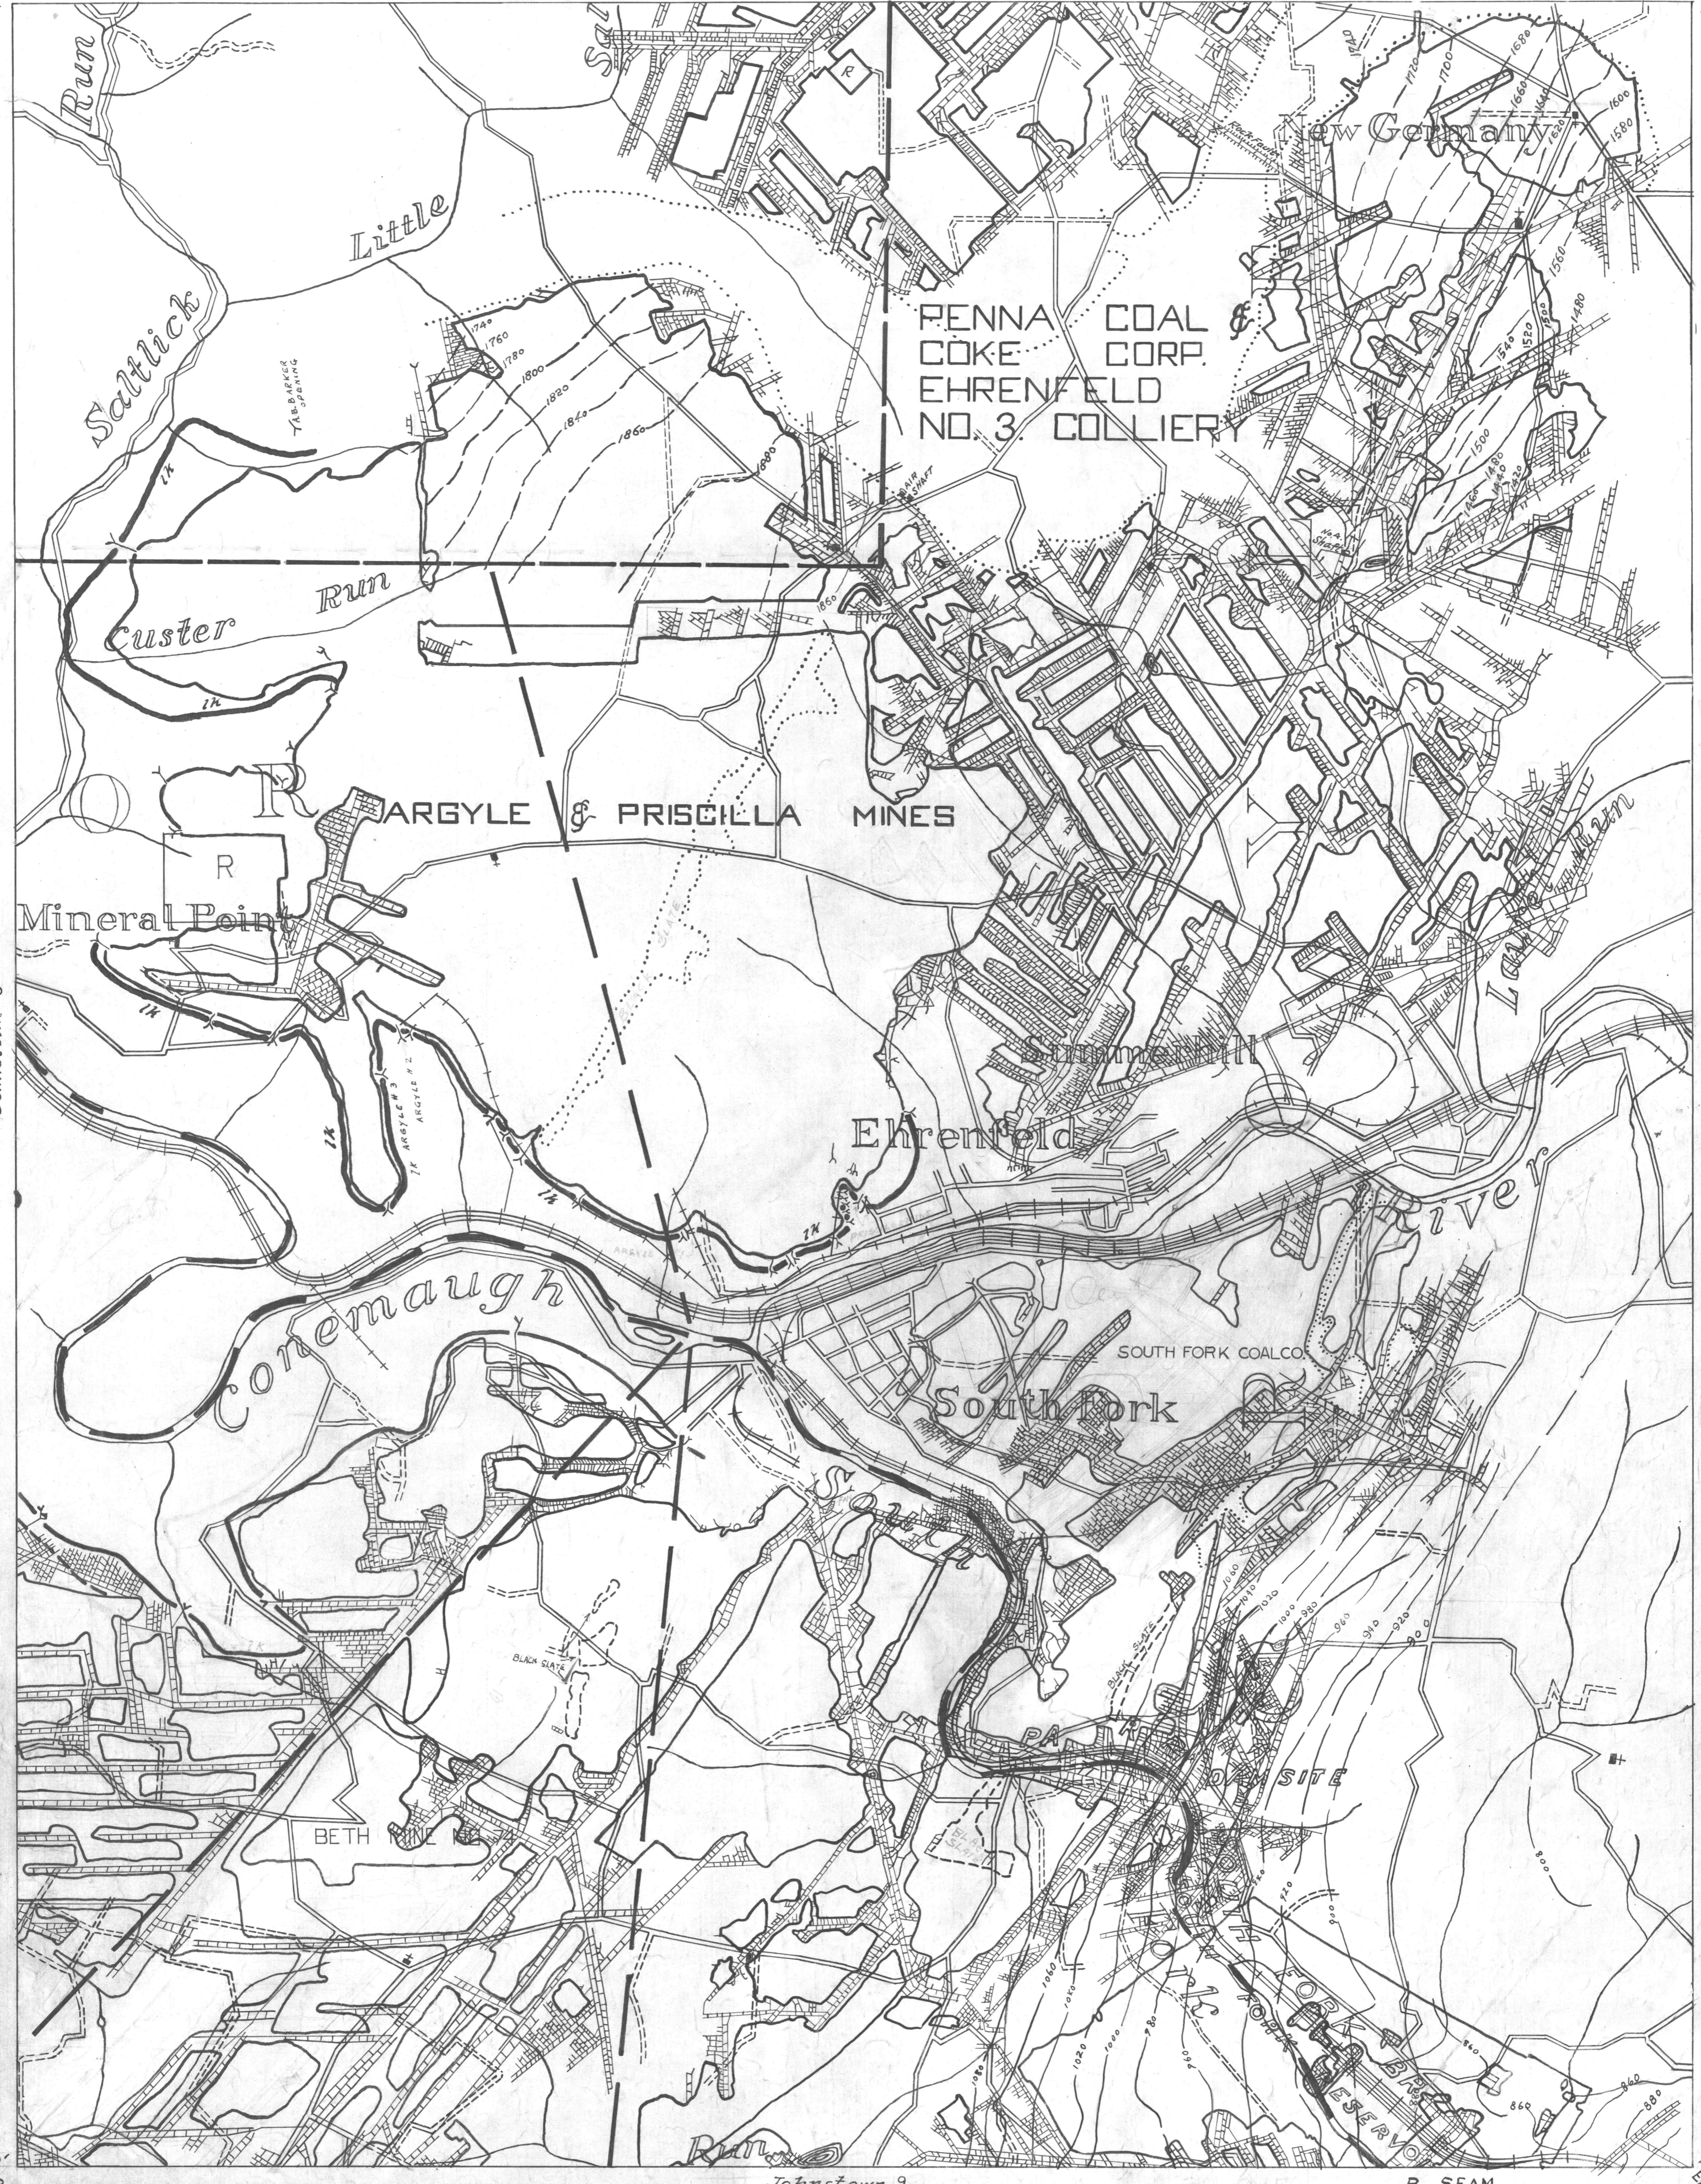

Johnstown 5
78° 50'

78° 45'

Johnstown 8
78° 50'

78° 45'

40° 20'

40° 20'