

NEW FLORENCE 9  
40° 20'

Johnstown 4

COUNTY LINES  
TOWNSHIP LINES  
BOROUGH LINES

7240  
COAL CONTOURS  
CROP LINES-SEAM BEING MINED  
CROP LINES SEAM NOT BEING MINED


78° 55'  
Johnstown 5  
40° 20'

New Florence 9

Johnstown 8

40° 15'  
Somerset 3  
79° 00'

40° 15'  
Windber 2  
78° 55'

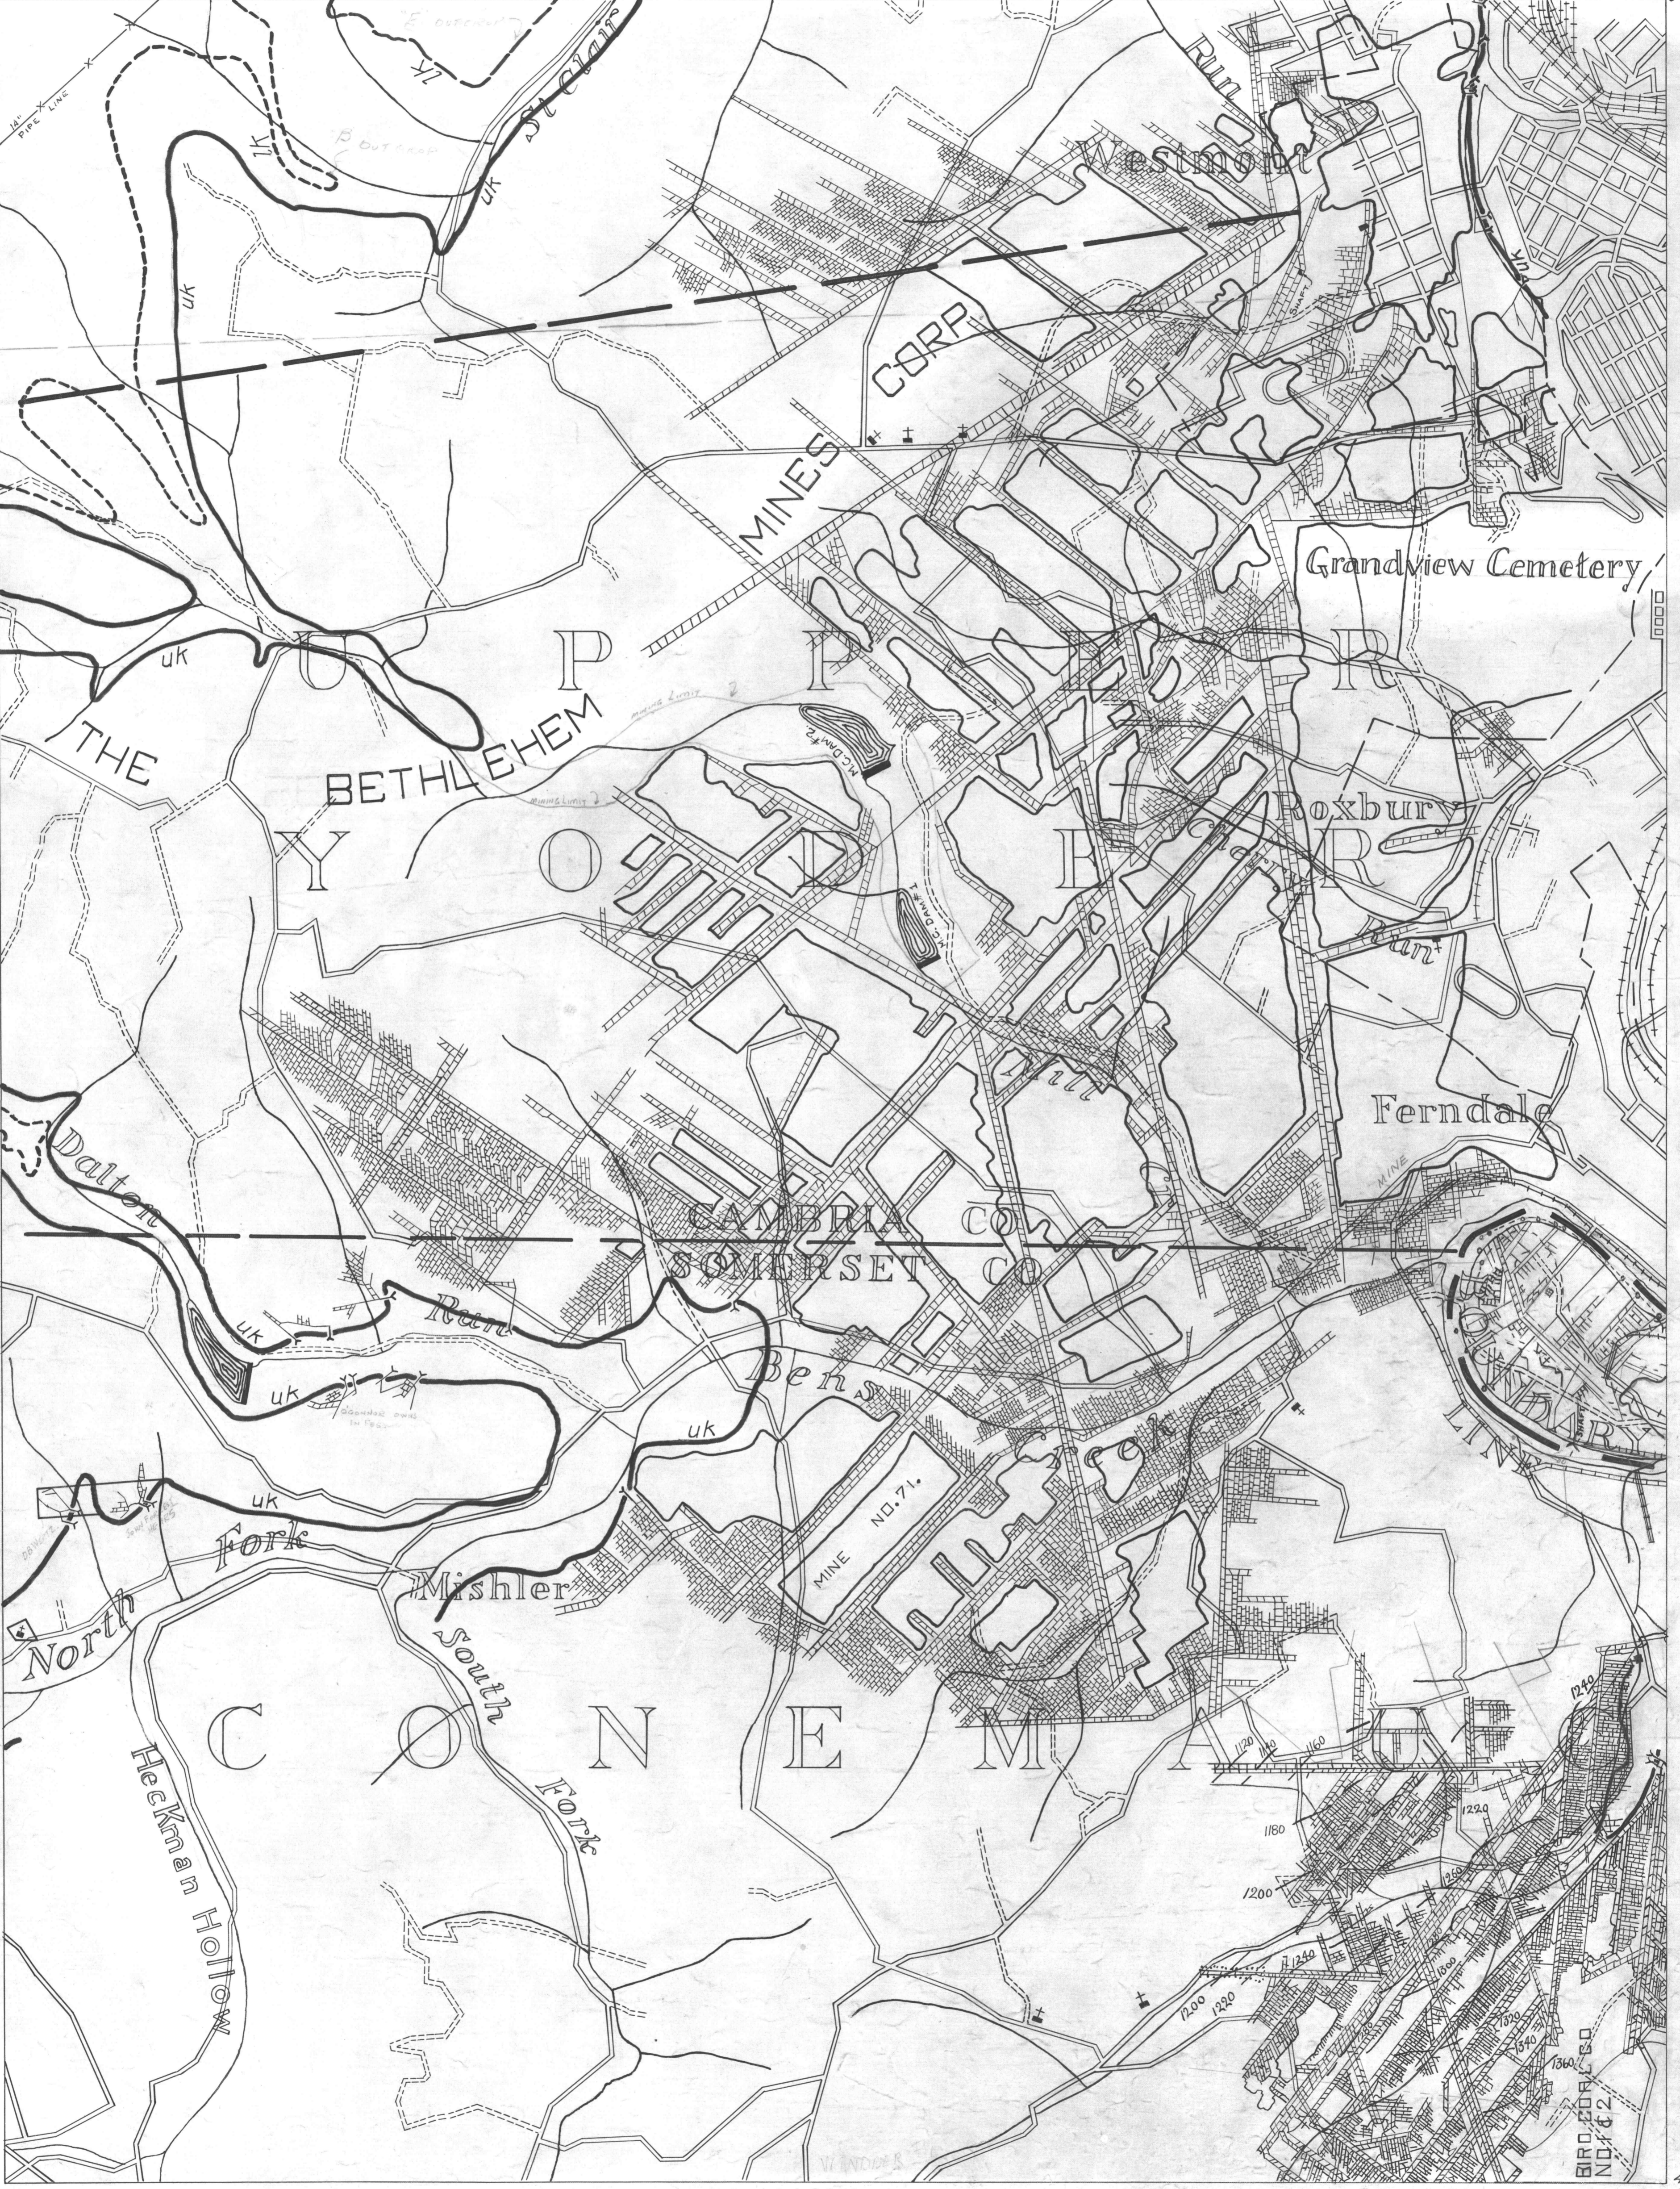

MINE MAP DEPARTMENT 1936

WPA FPROJECT No 65-23-5001-8 & No 465-23-3 192

2 Miles  
C-SEAM  
JOHNSTOWN SHEET NO. 7  
UPPER KITTANNING UK