


matched - v Karthaus 2


- ACTIVE OIL WELL
- ◆ ABANDONED OIL WELL
- * ACTIVE GAS WELL
- * ABANDONED GAS WELL
- * ACTIVE OIL & GAS WELL
- * ABANDONED OIL & GAS WELL
- ◇ DRY HOLE
- NO RECORD

- COUNTY LINES
- TOWNSHIP LINES
- BOROUGH LINES
- SURFACE CONTOURS
- COAL CONTOURS
- CROP LINES - SEAM BEING MINED
- CROP LINES - SEAMS NOT BEING MINED

KARTHAUS 2

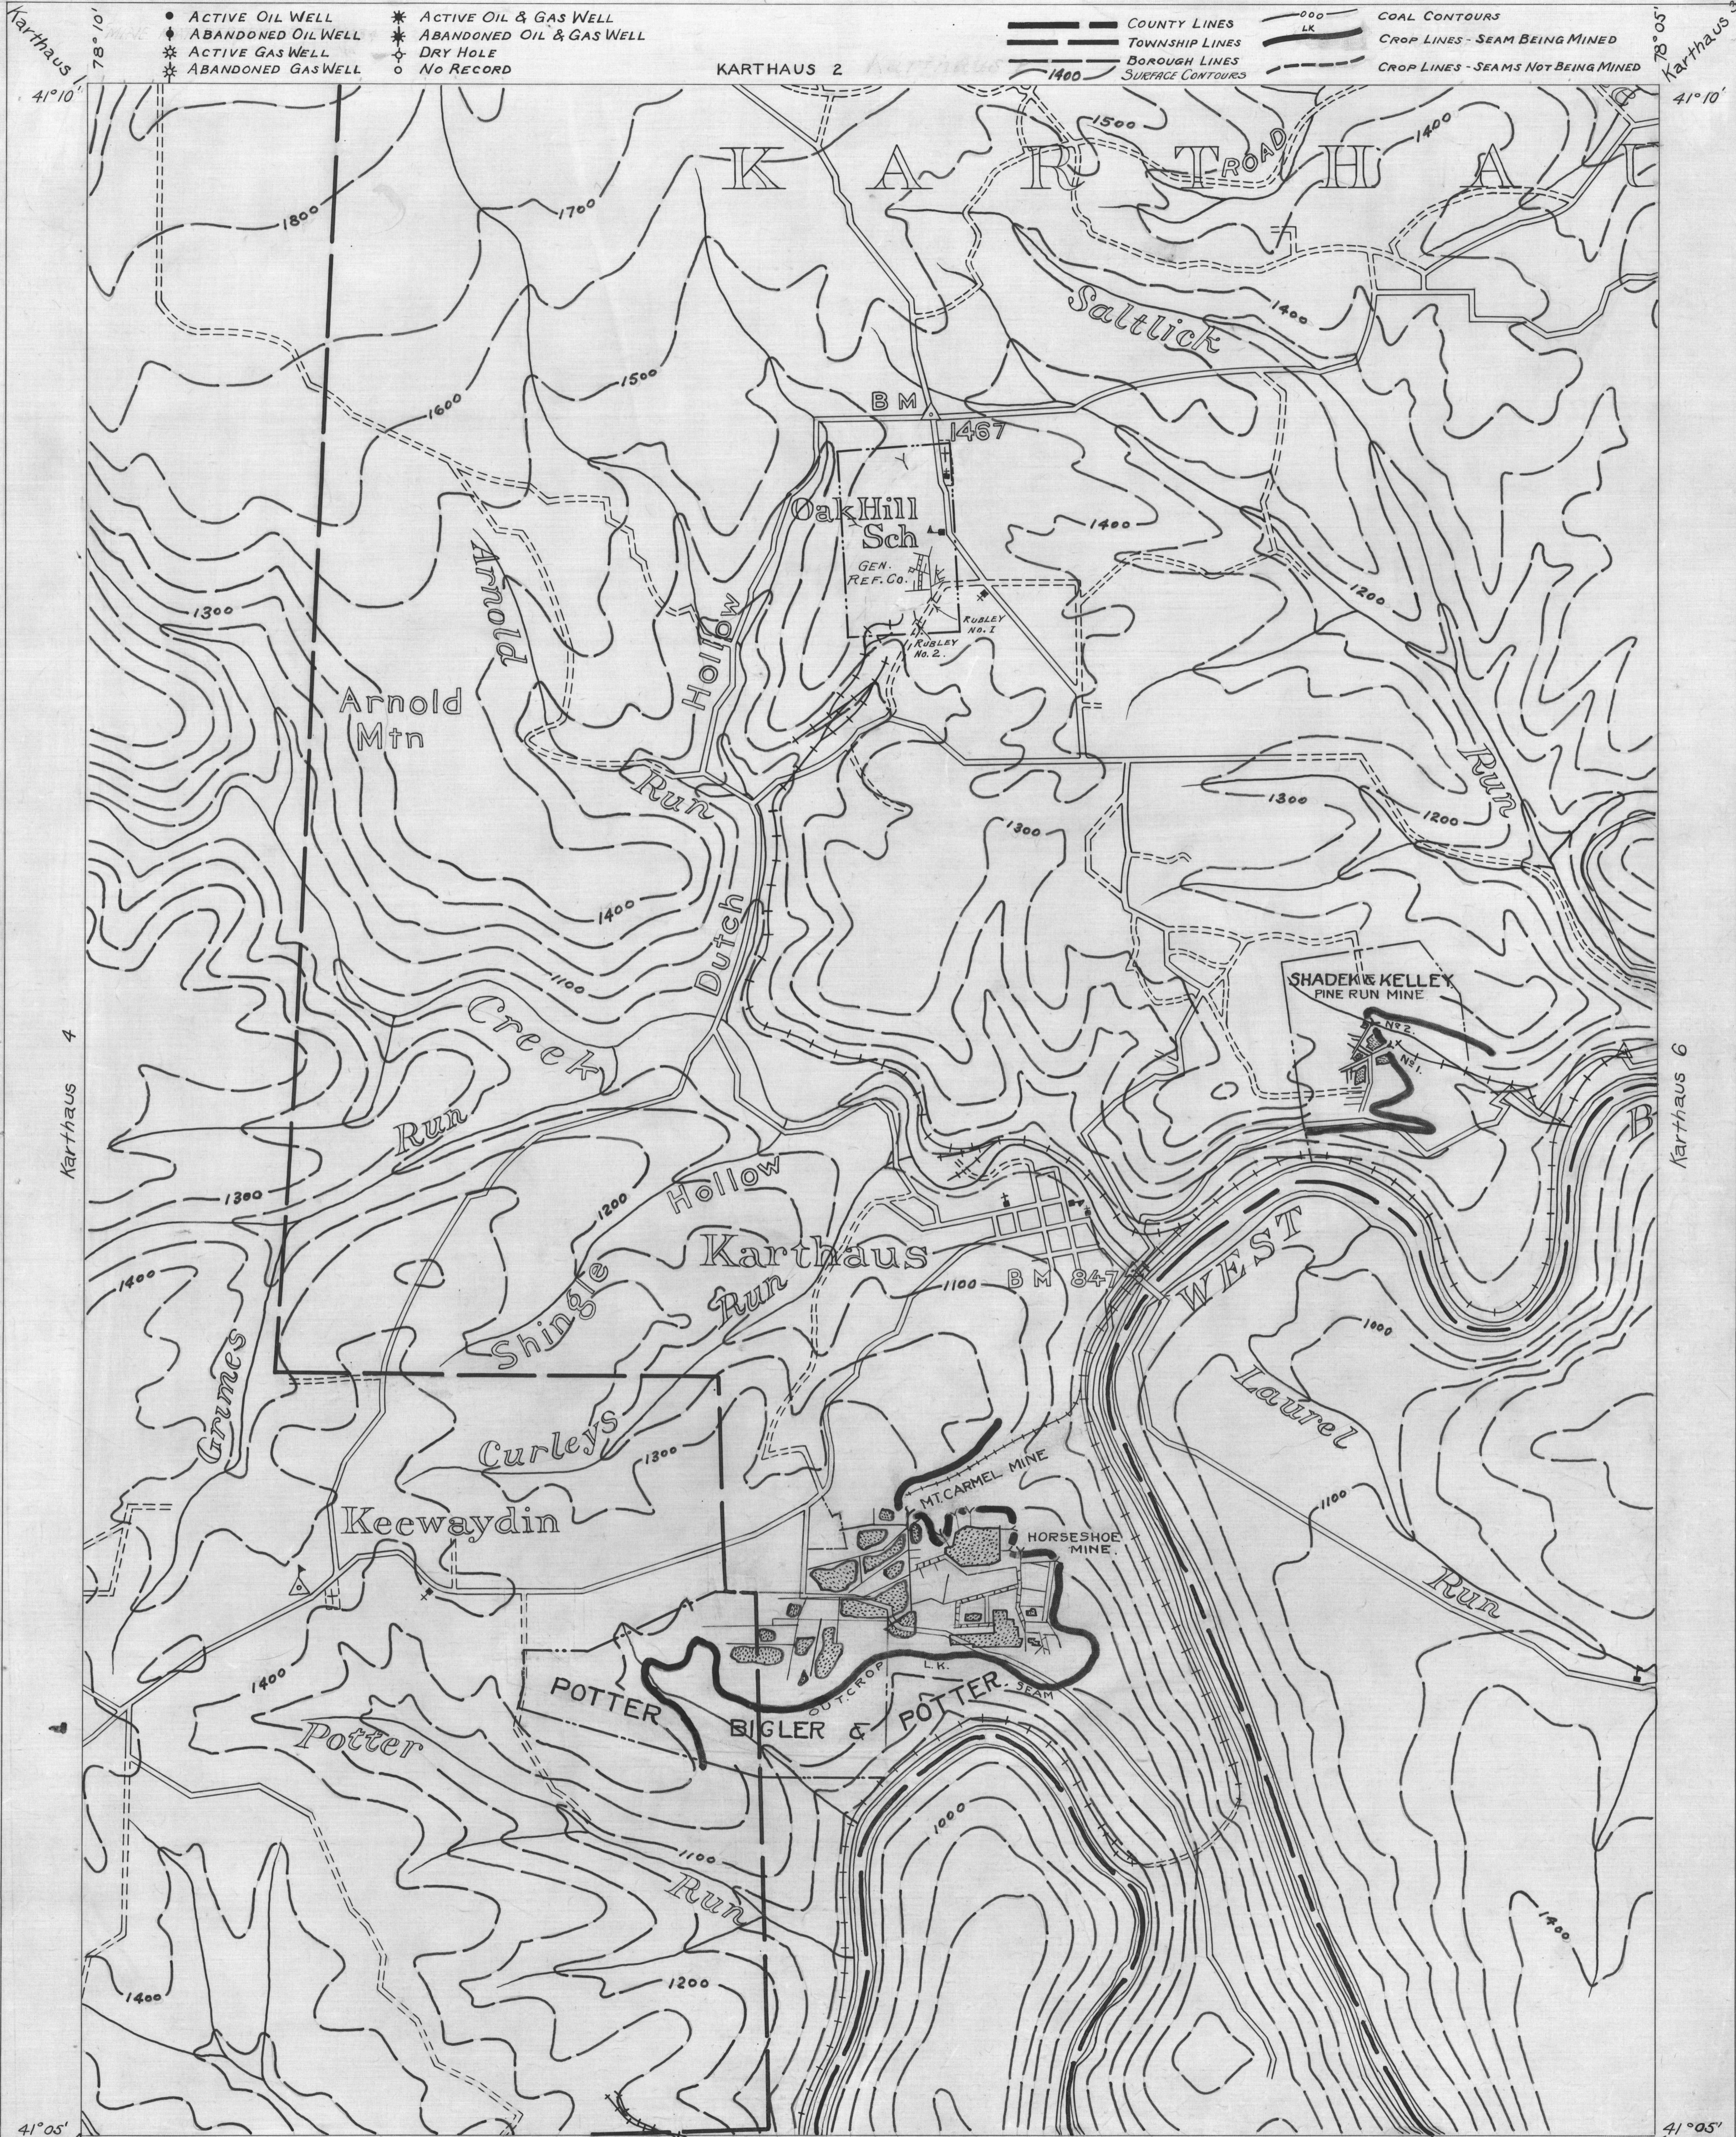

- DRIFT OPENING
- SLOPE OPENING
- SHAFTS
- ▨ BARRIER PILLAR

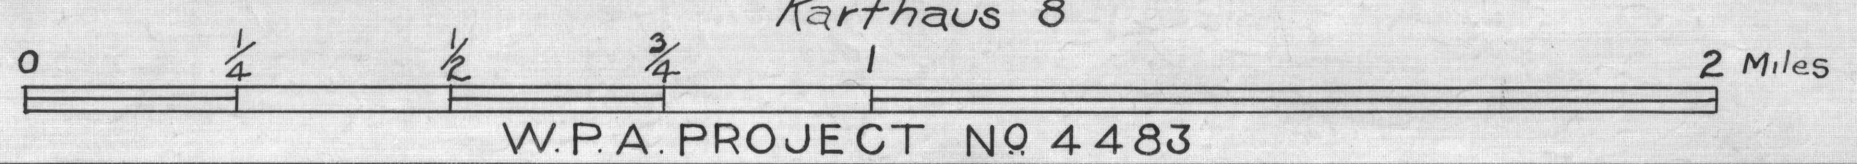

KARTHAUS SHEET No. 5.
(B)-L. K. SEAM.

matched - v