


● ACTIVE OIL WELL      \* ACTIVE OIL & GAS WELL  
 ○ ABANDONED OIL WELL      \* ABANDONED OIL & GAS WELL  
 \* ACTIVE GAS WELL      ◇ DRY HOLE  
 \* ABANDONED GAS WELL      ○ NO RECORD

COUNTY LINES      980 COAL CONTOURS      900  
 TOWNSHIP LINES      CROP LINES - SEAMS BEING MINED  
 BOROUGH LINES      CROP LINES - SEAMS NOT BEING MINED

Brownsville 7.

79° 55'  
 Brownsville-8  
 40° 00'

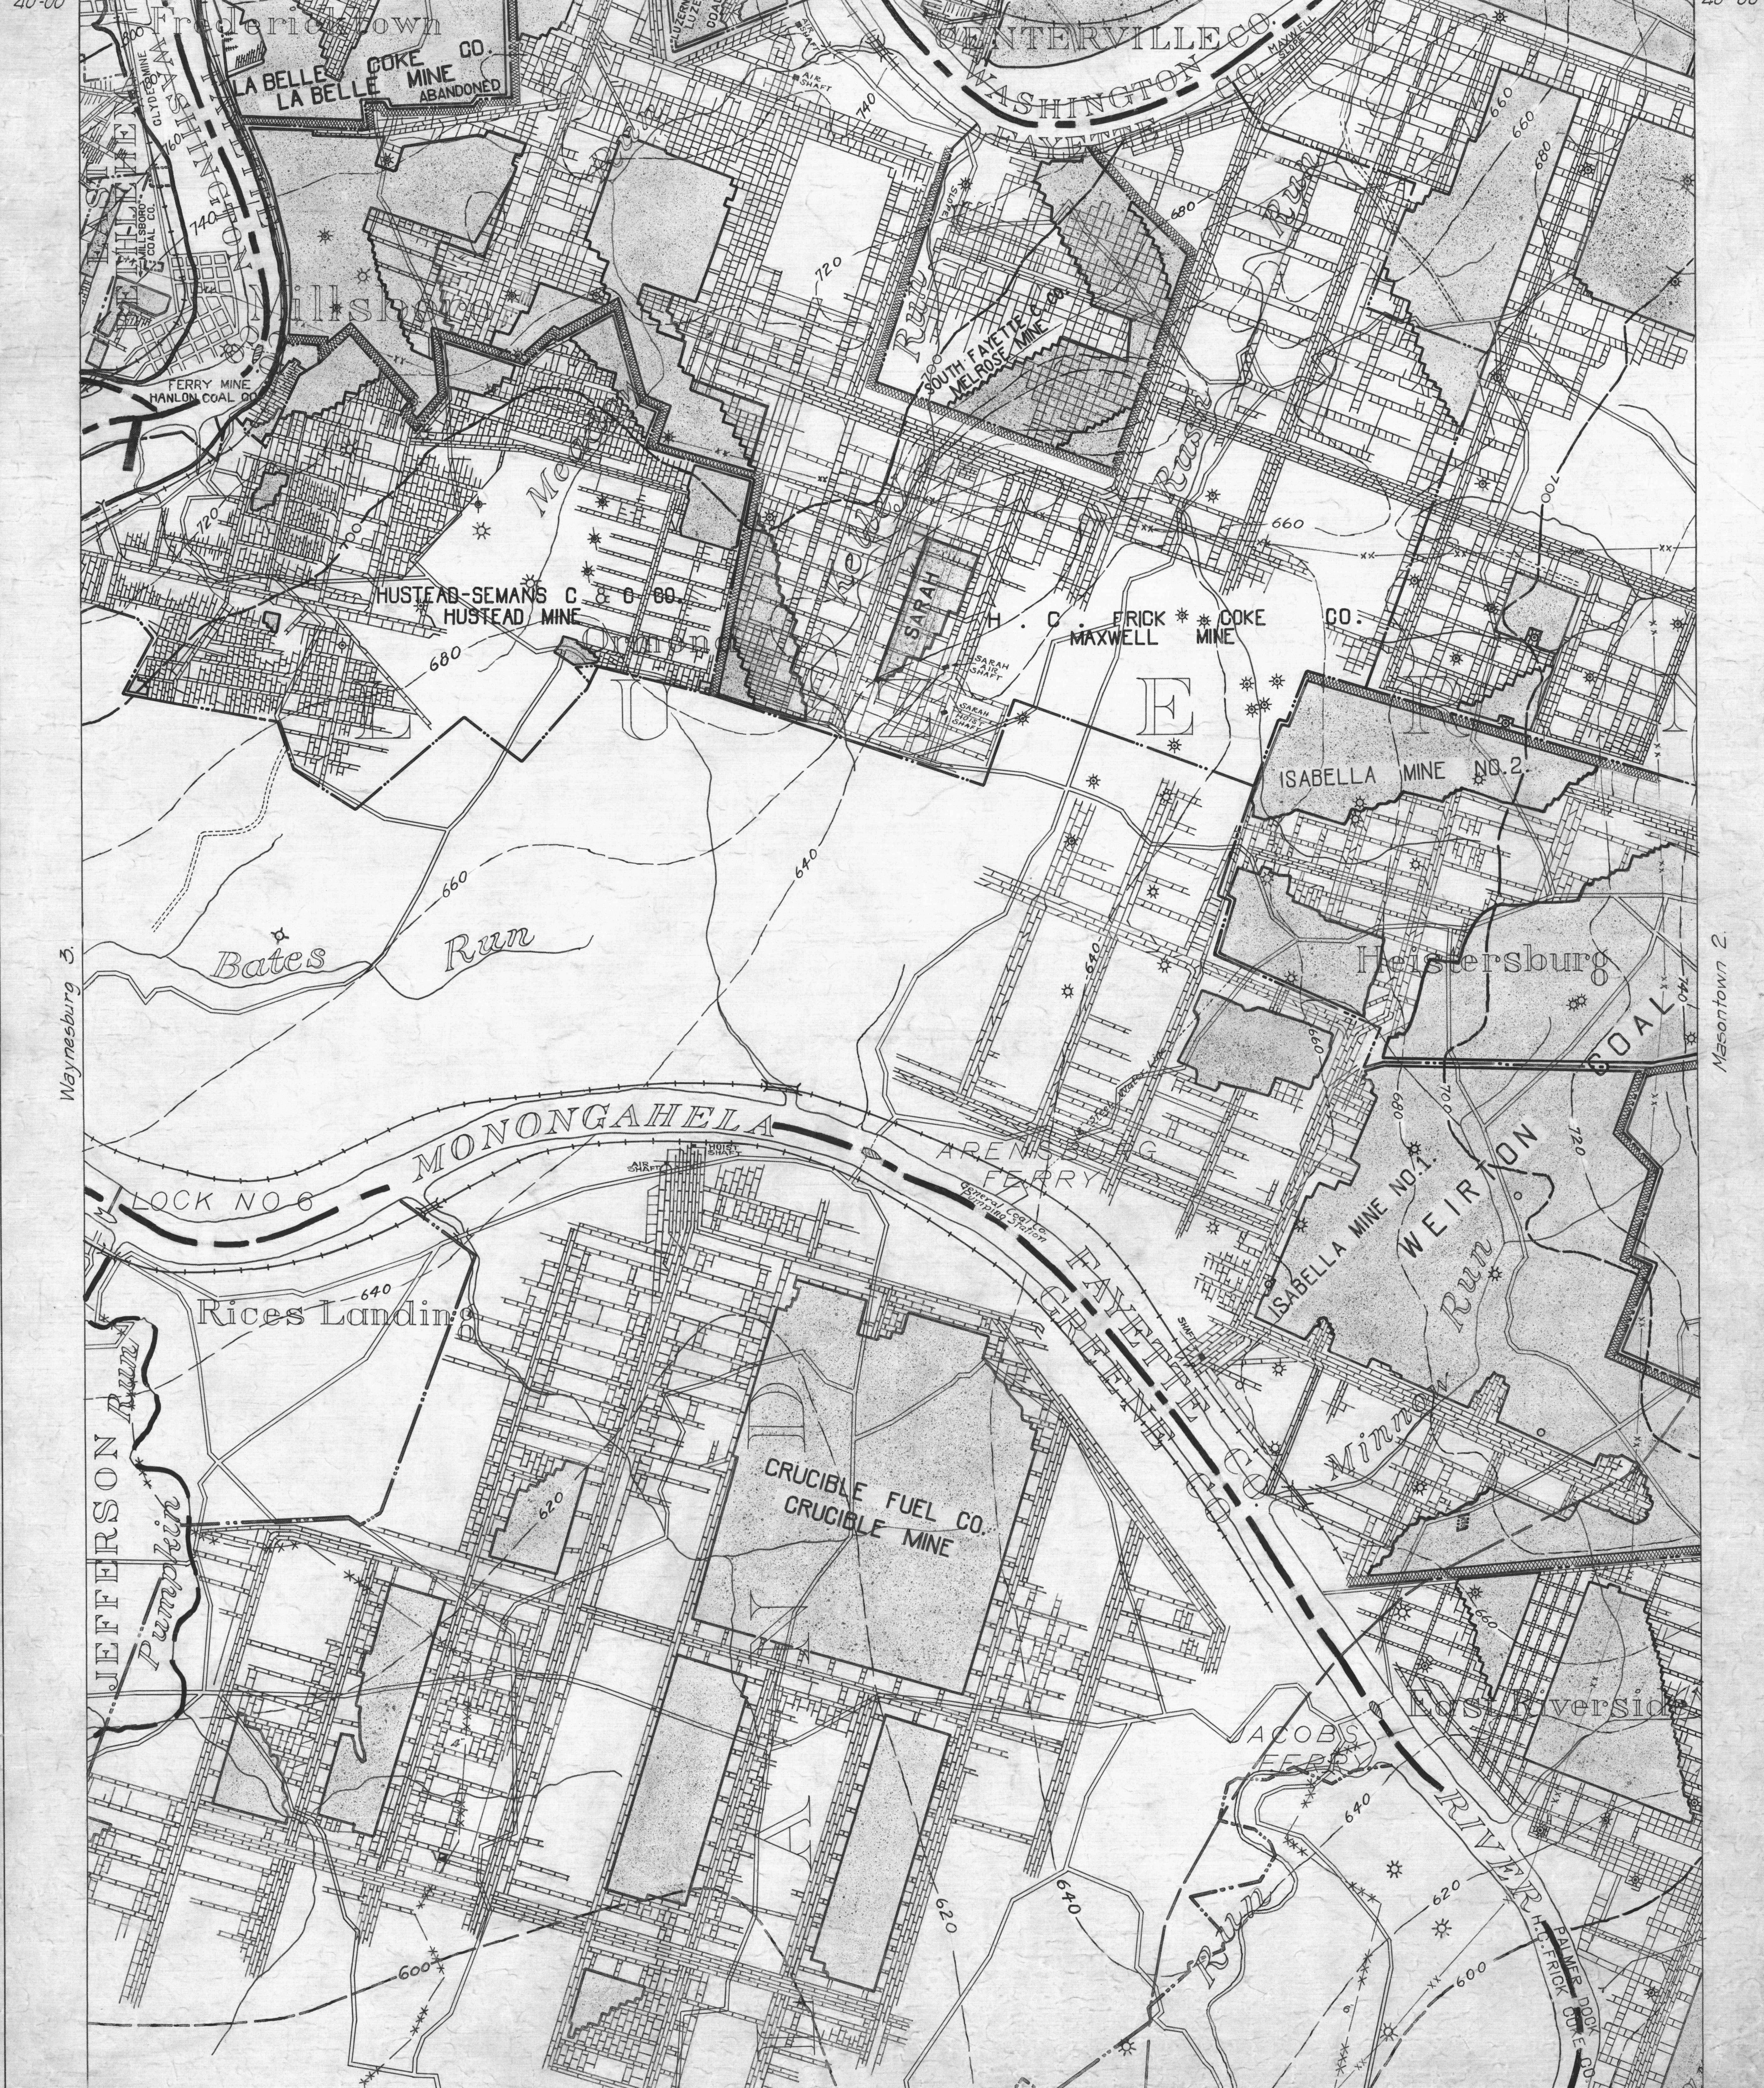

39° 55'  
 Masontown 4  
 2 MILES  
 W.P.A. PROJECT NO 4483  
 PITTSBURGH SEAM.  
 MASONTOWN SHEET NO 1  
 79° 55'