
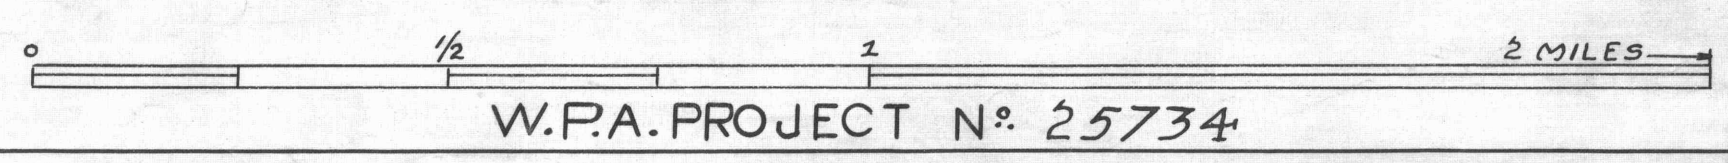


- ACTIVE OIL WELL
- ABANDONED OIL WELL
- ★ ACTIVE GAS WELL
- ★ ABANDONED GAS WELL
- ★ ACTIVE OIL & GAS WELL
- ★ ABANDONED OIL & GAS WELL
- ◇ DRY HOLE
- NO RECORD

- ▬ COUNTY LINES
- ▬ TOWNSHIP LINES
- ▬ BOROUGH LINES
- ▬ SURFACE CONTOURS

- COAL CONTOURS
- CROP LINES - SEAM BEING MINED
- CROP LINES - SEAMS NOT BEING MINED

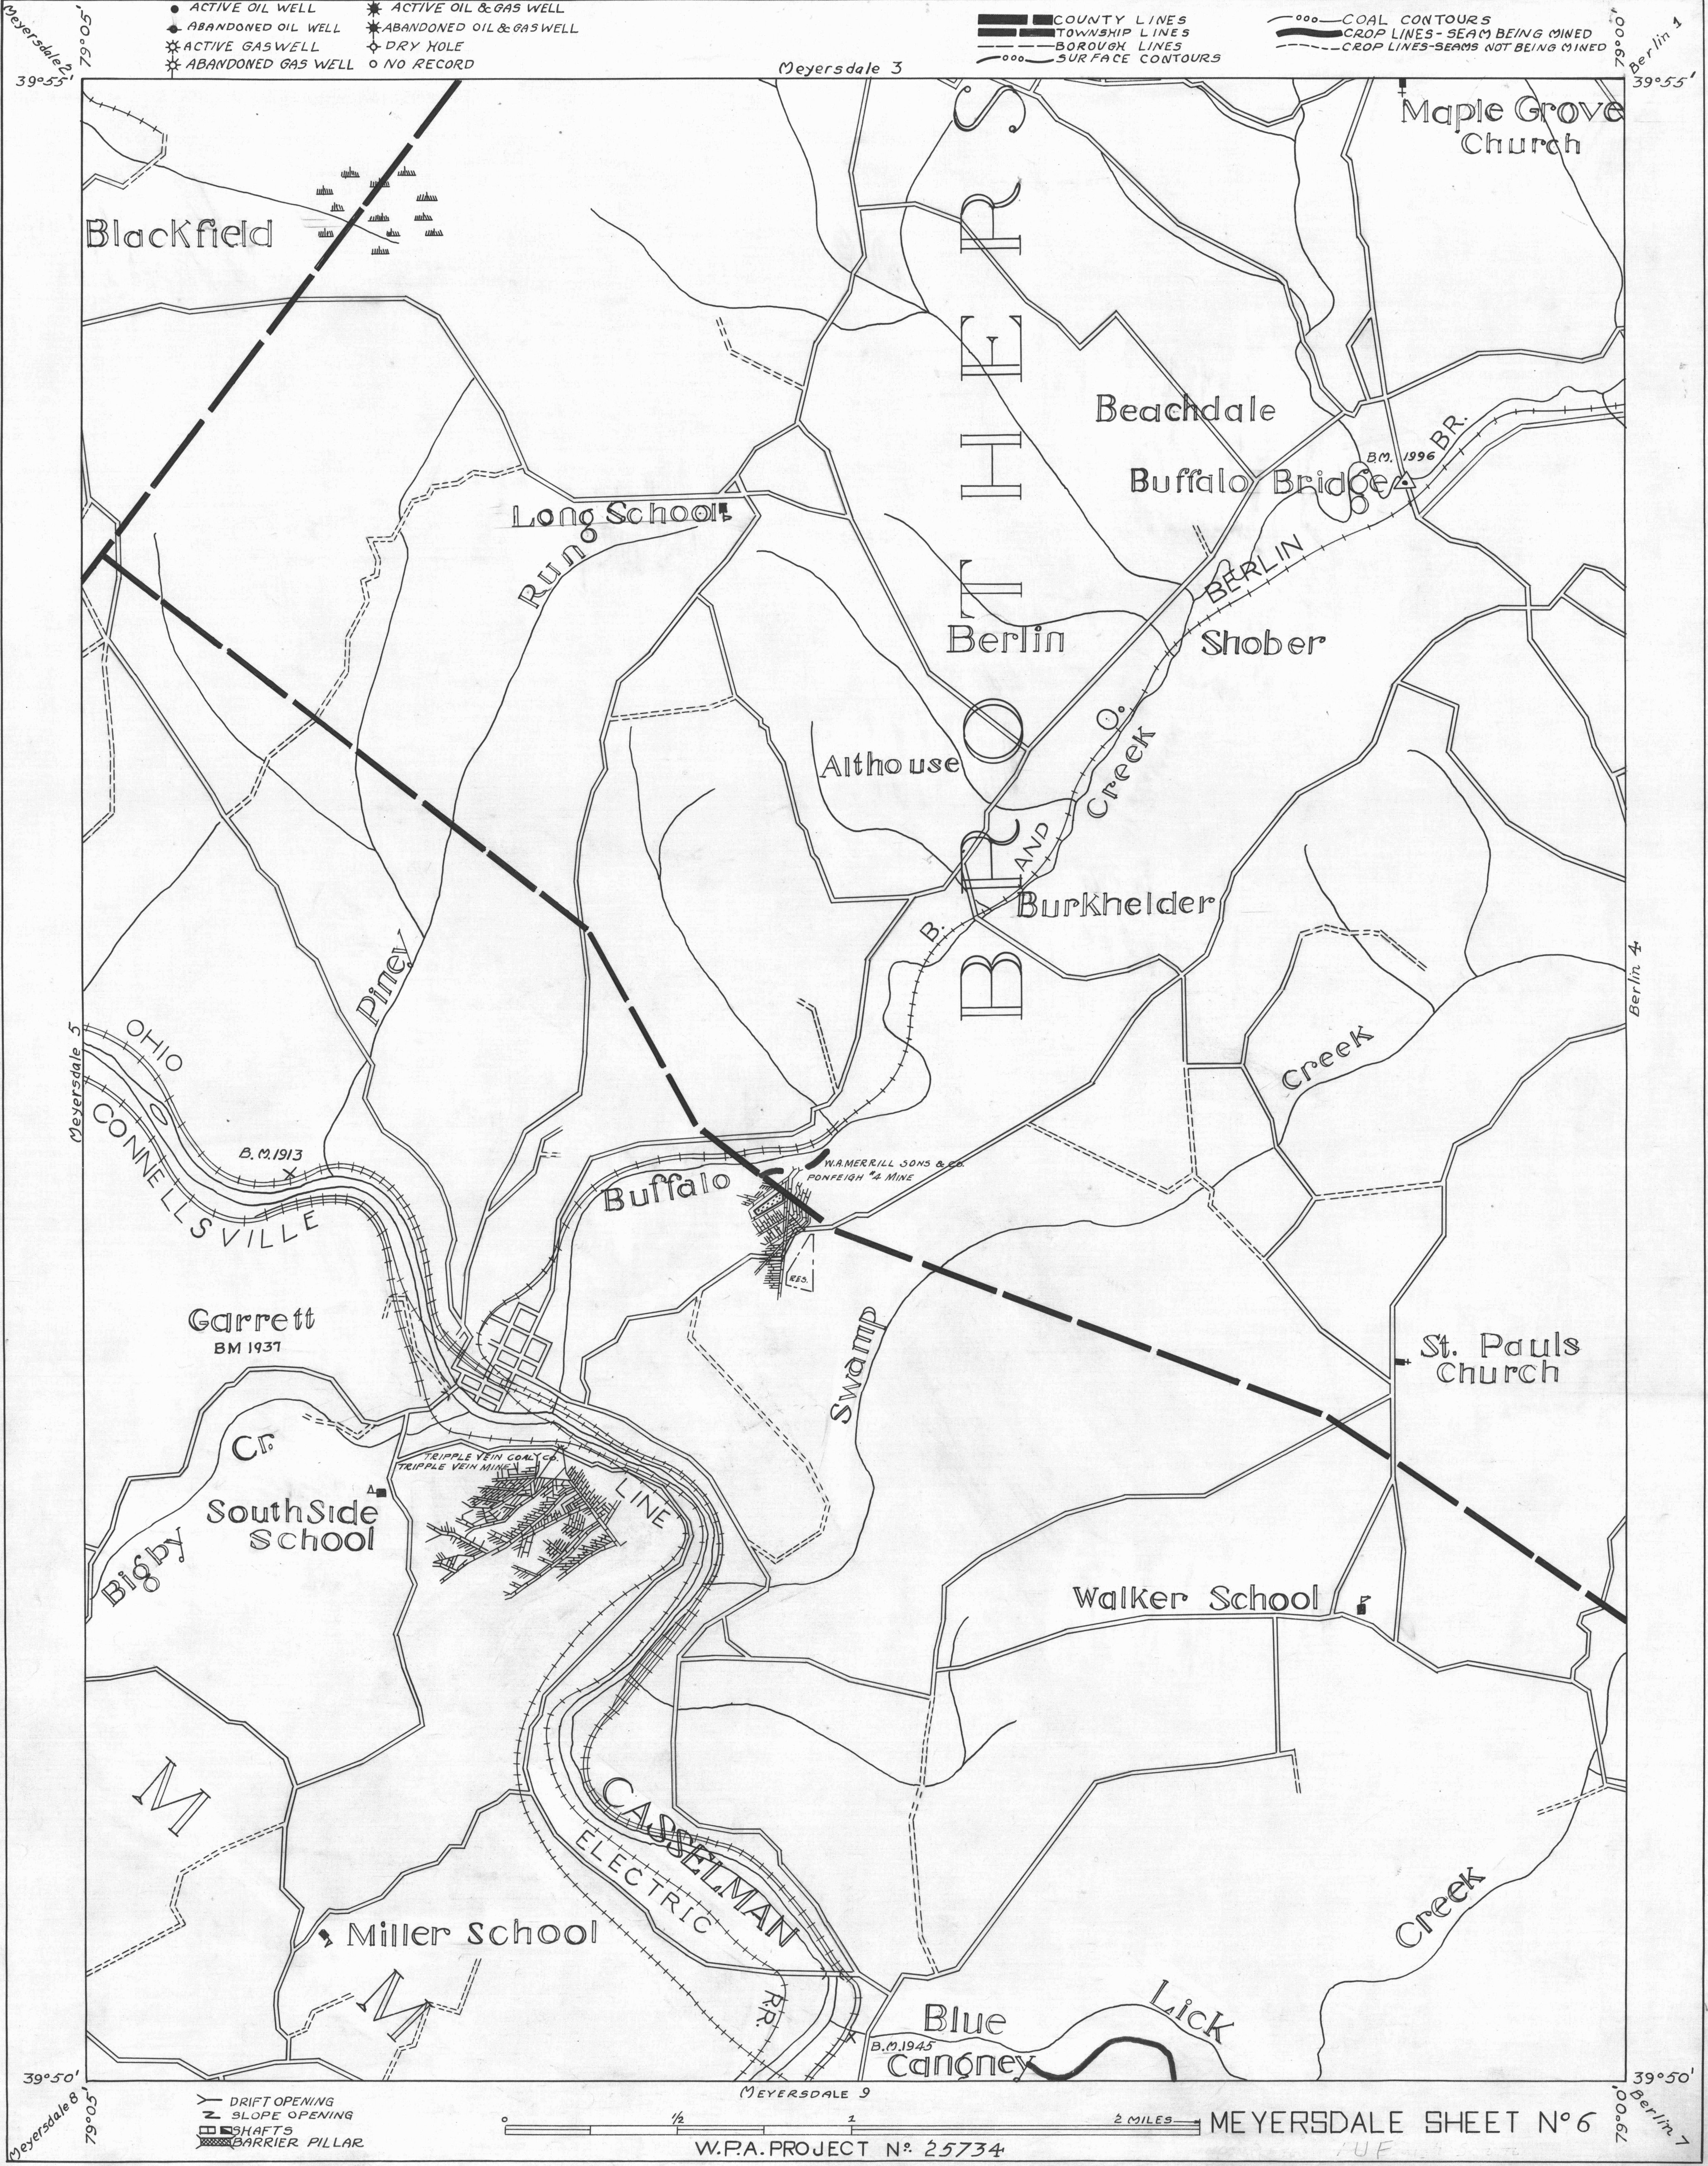

W.P.A. PROJECT N° 25734

MEYERSDALE SHEET N° 6

- Y DRIFT OPENING
- Z SLOPE OPENING
- SHAFTS
- ▣ BARRIER PILLAR