


Morgantown 7 39° 45' 79° 50' Morgantown 9

- ACTIVE OIL WELL
- ABANDONED OIL WELL
- ⊛ ACTIVE GAS WELL
- ⊙ ABANDONED GAS WELL
- ★ ACTIVE OIL & GAS WELL
- ⊛ ABANDONED OIL & GAS WELL
- ◇ DRY HOLE
- NO RECORD

Morgantown 8

— COUNTY LINES
 - - - TOWNSHIP LINES
 - - - BOROUGH LINES

980 — COAL CONTOURS — 900
 - - - CROP LINES—SEAMS BEING MINED
 - - - CROP LINES—SEAMS NOT BEING MINED

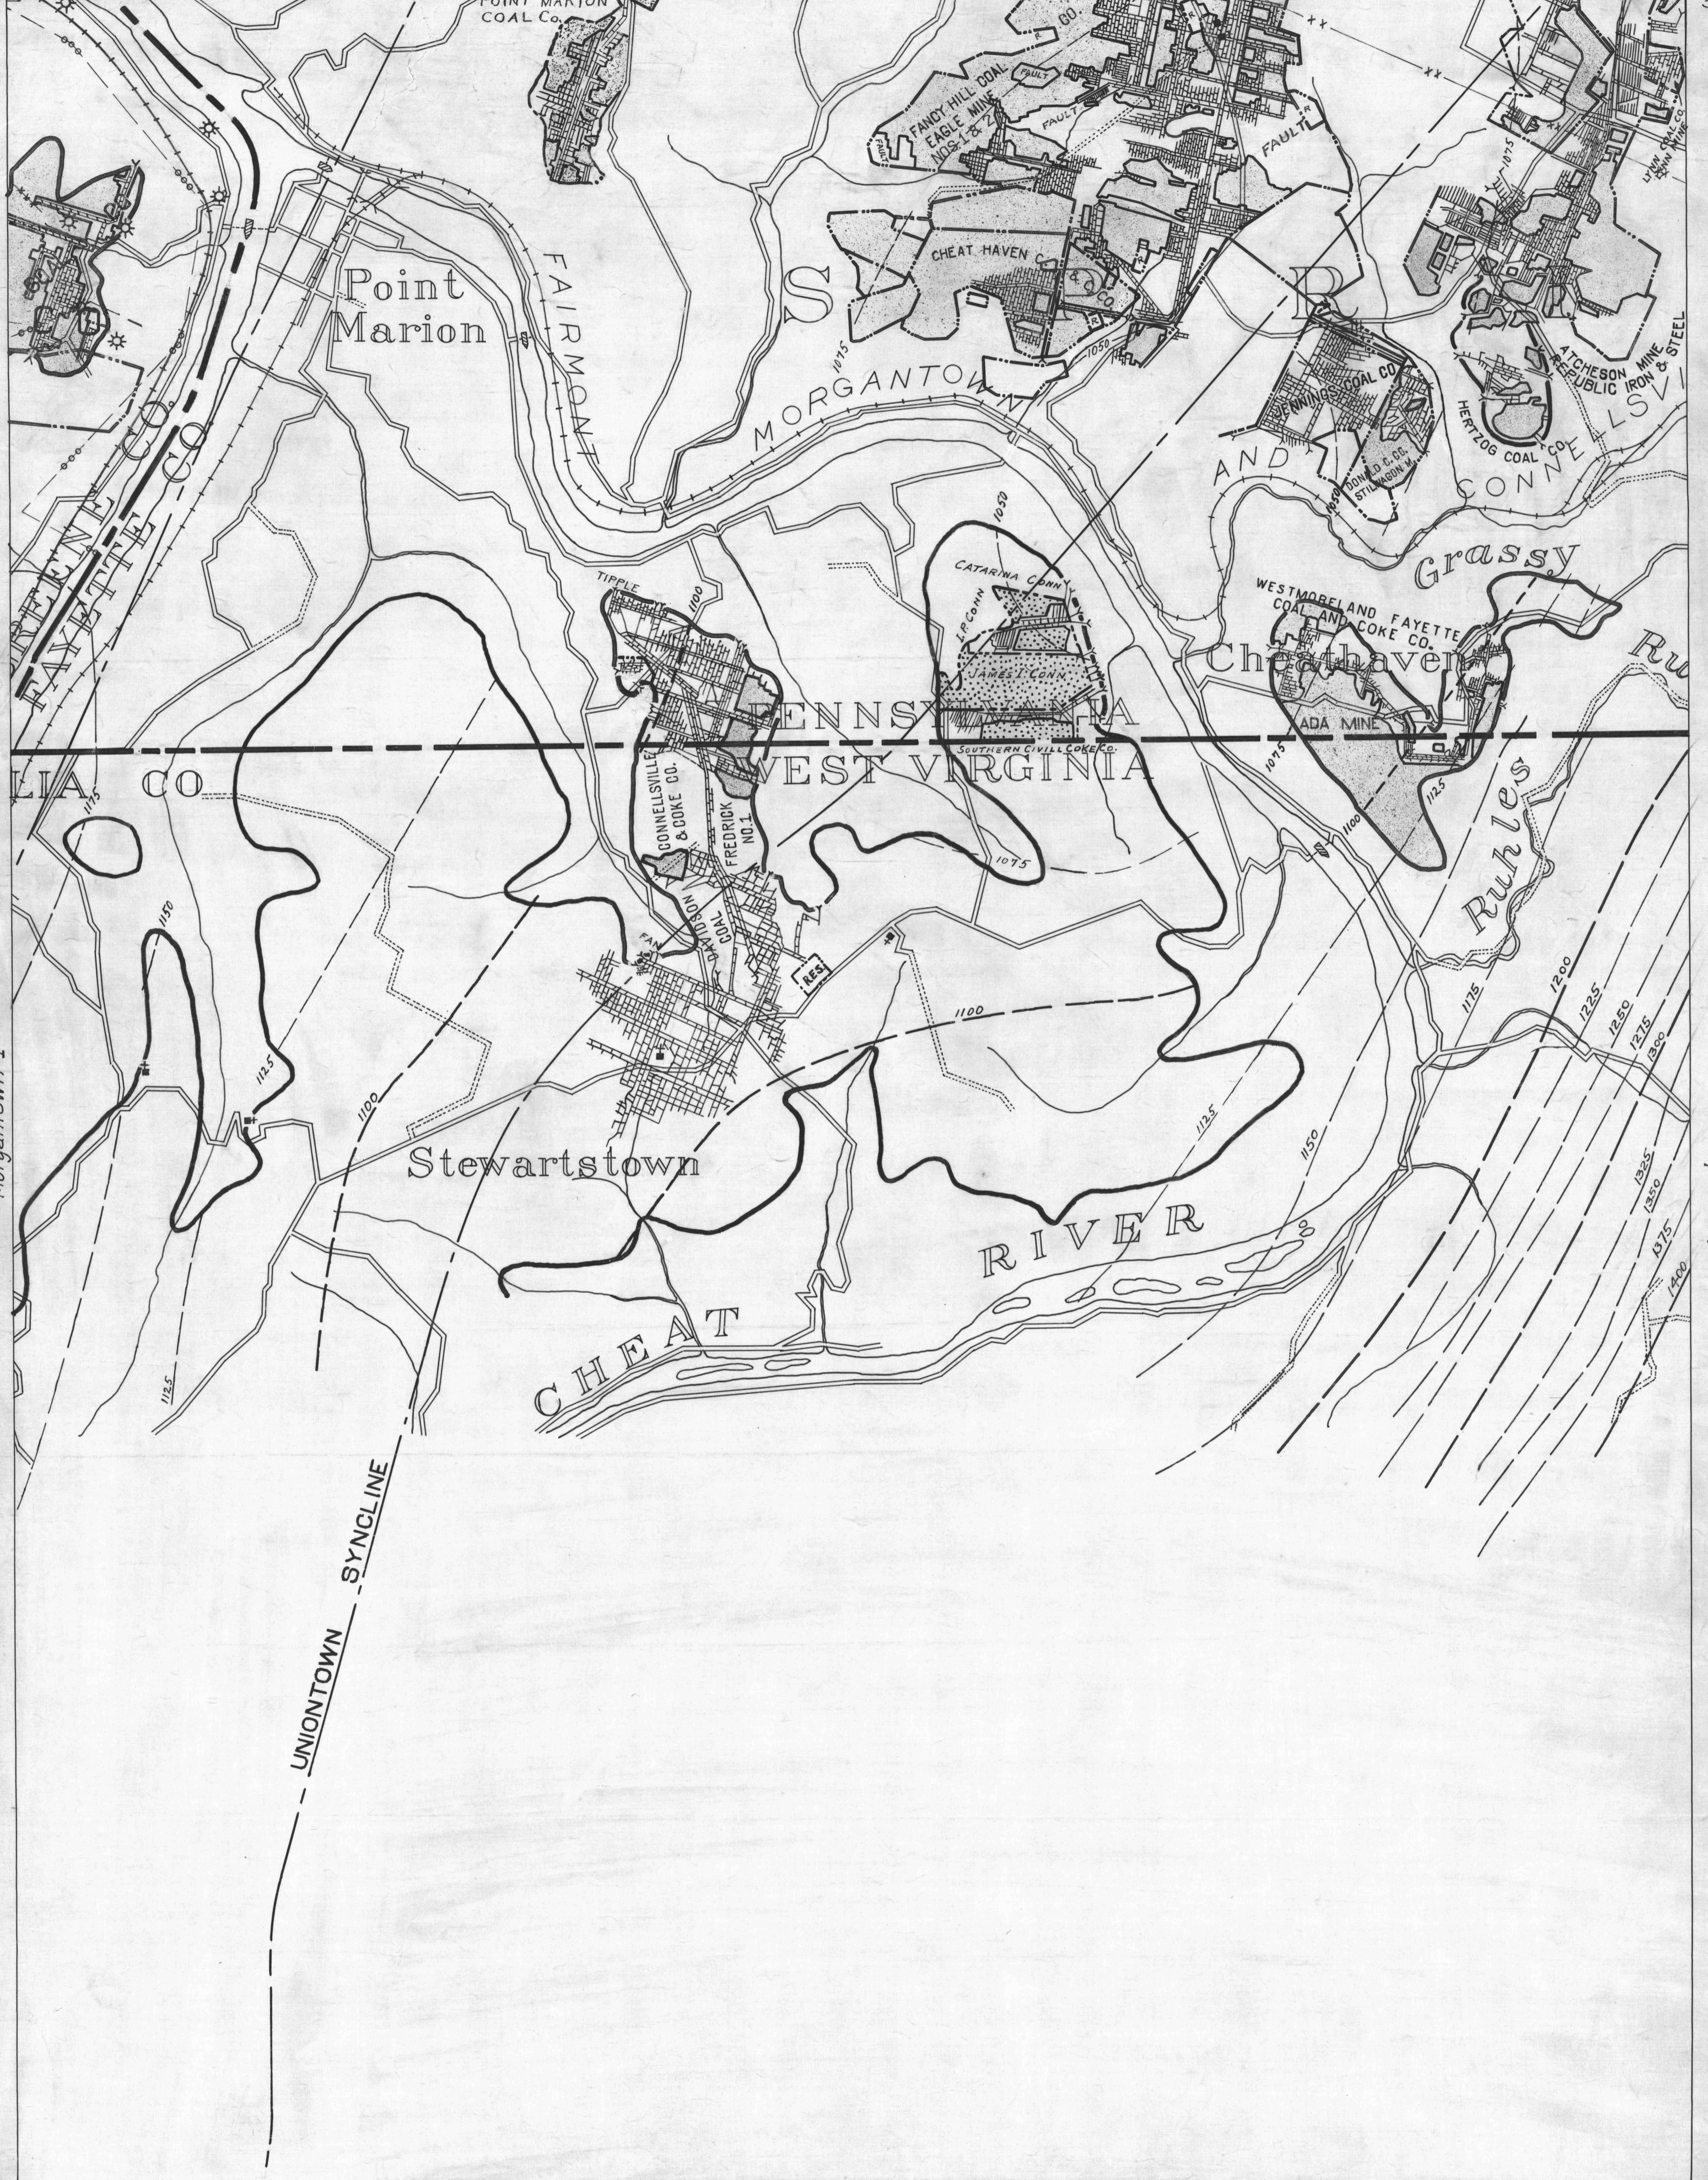

Morgantown 1 39° 40' 79° 55' Morgantown 3 39° 40' 79° 50' Morgantown 5 39° 40' 79° 50' Morgantown 6

0 1 2 MILES

PITTSBURGH SEAM.
 MORGANTOWN SHEET NO. 2

W.P.A. PROJECT NO 4483

MINE MAP DEPARTMENT 1934

Legend:
 — DRIFT OPENING
 - - - SLOPE OPENING
 □ SHAFTS
 ⊞ BARRIER PILLAR

Note: Add bridge over Monongahella River near junction of Cheat River.