



- ACTIVE OIL WELL
- ABANDONED OIL WELL
- ⊛ ACTIVE GAS WELL
- ⊛ ABANDONED GAS WELL
- ⊛ ACTIVE OIL & GAS WELL
- ⊛ ABANDONED OIL & GAS WELL
- DRY HOLE
- NO RECORD

- COUNTY LINES
- TOWNSHIP LINES
- BOROUGH LINES
- 980' OF COAL CONTOURS
- CROP LINES - SEAM BEING MINED
- CROP LINES - SEAMS NOT BEING MINED

New Kensington 5

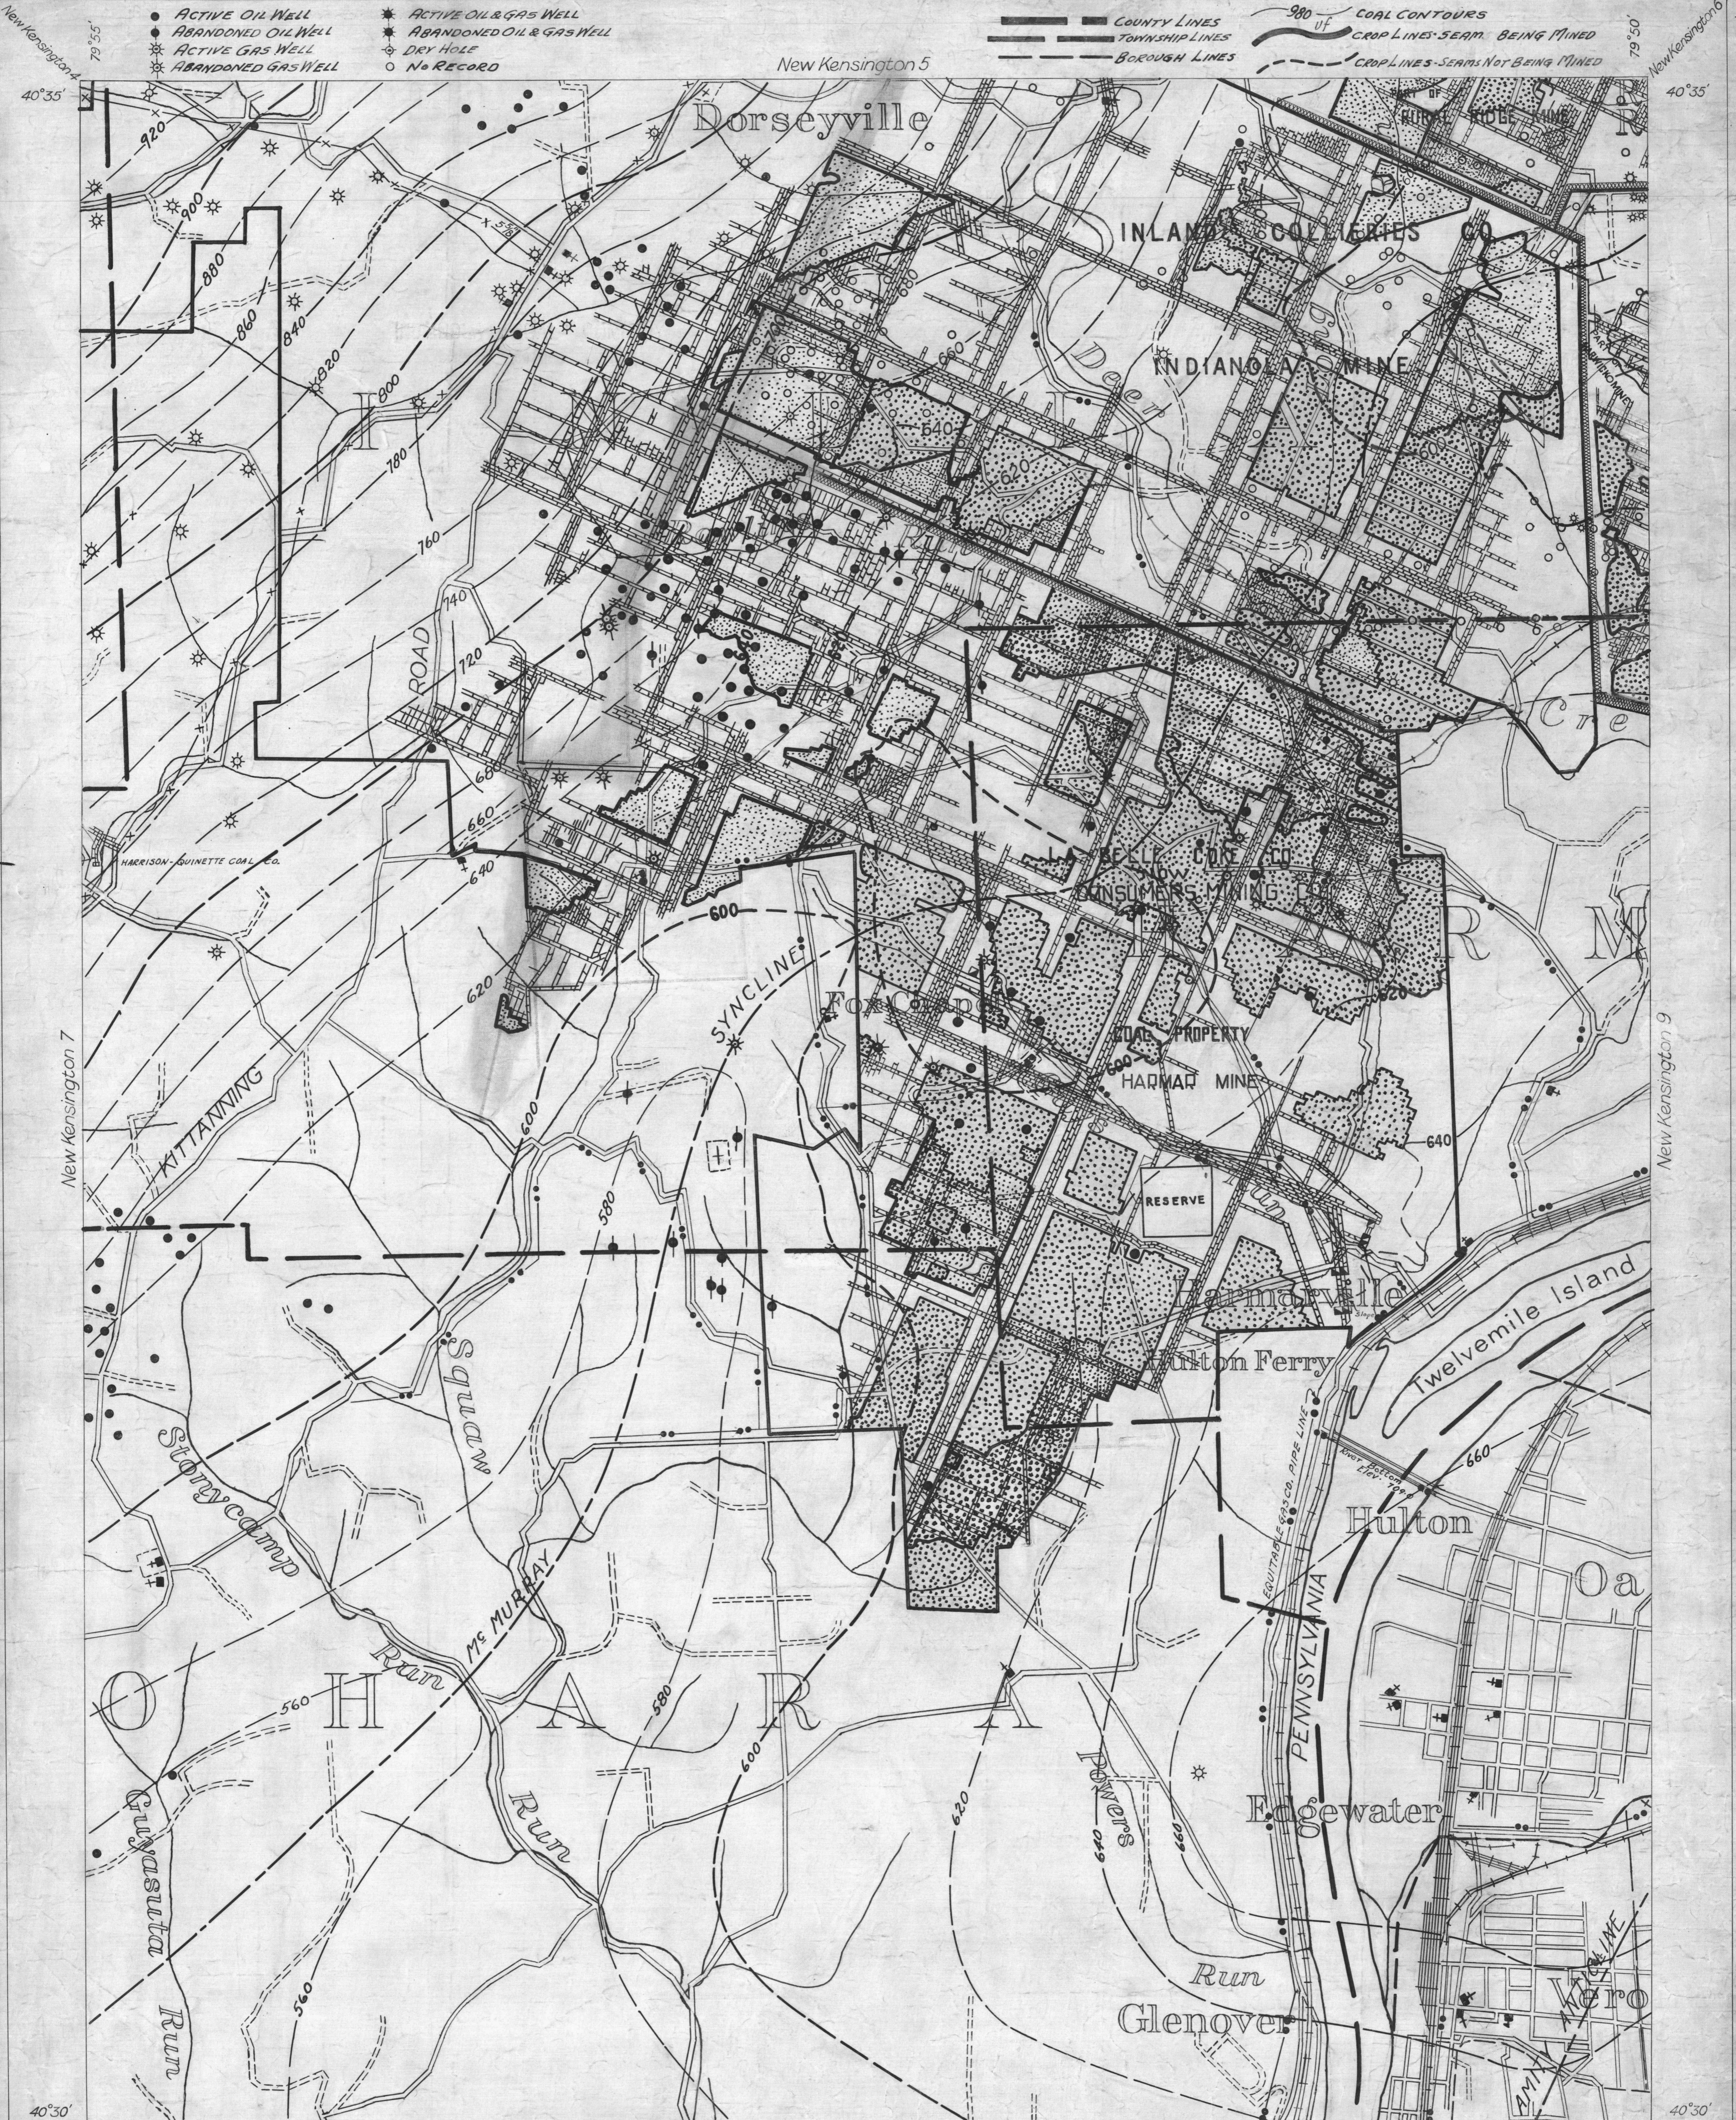

- DRIFT OPENING
- SLOPE OPENING
- SHAFTS
- ▨ BARRIERS FILLED

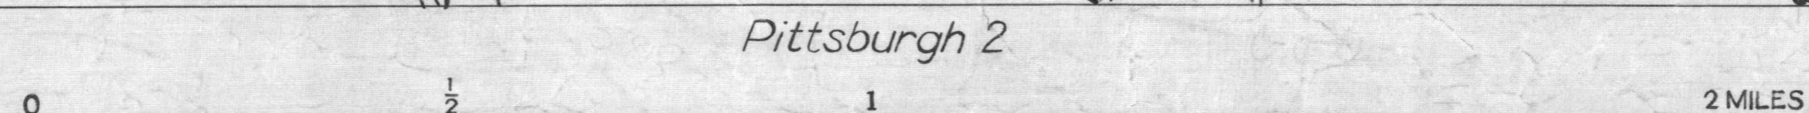

W.P.A. PROJECT NO. 4483

NEW KENSINGTON SHEET No. 8  
Upper Freeport seam - U.F.

Traced by J.R. FINNEY 2-26-34  
 Lettered D.M. Fadden 2-27-34  
 Checked T. CARMODY 2-28-34