



- ACTIVE OIL WELL
- ◆ ABANDONED OIL WELL
- * ACTIVE GAS WELL
- * ABANDONED GAS WELL
- DRY HOLE
- NO RECORD
- * ACTIVE OIL & GAS WELL
- * ABANDONED OIL & GAS WELL
- DRY HOLE
- NO RECORD

- COUNTY LINES
- TOWNSHIP LINES
- BOROUGH LINES
- COAL CONTOURS
- CROP LINES—SEAM BEING MINED
- CROP LINES—SEAMS NOT BEING MINED

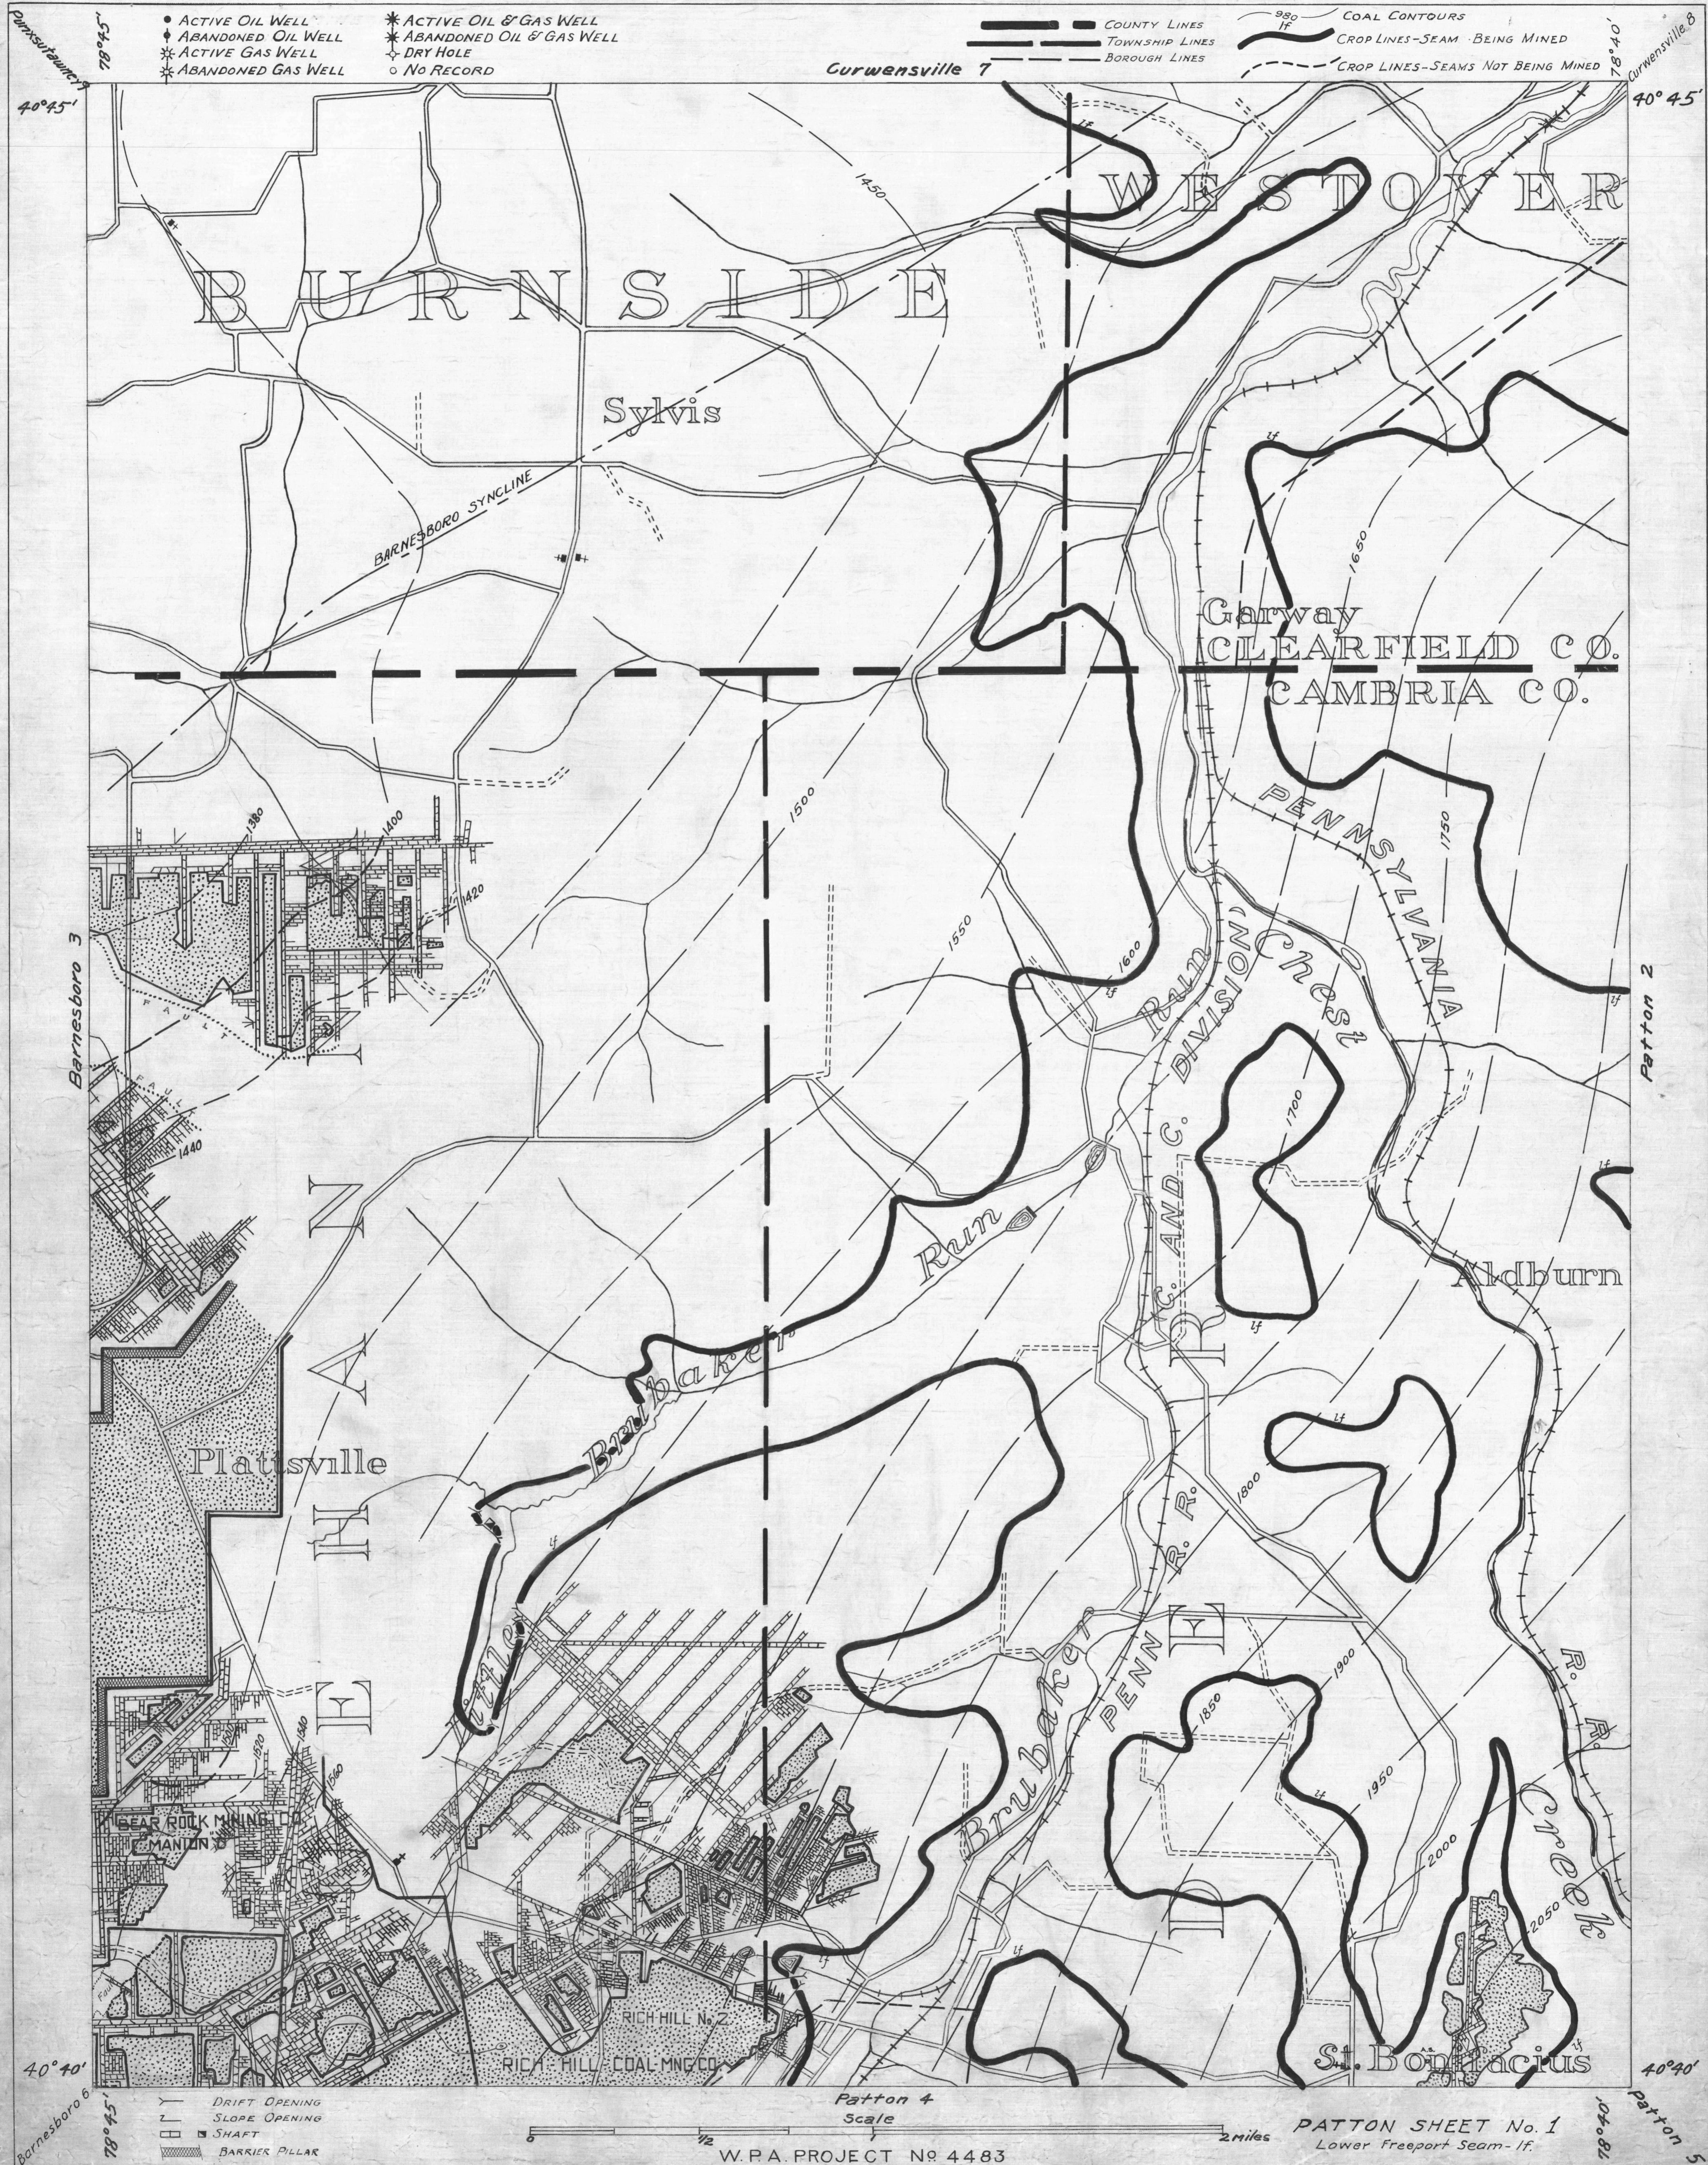

- DRIFT OPENING
- SLOPE OPENING
- SHAFT
- ▣ BARRIER PILLAR

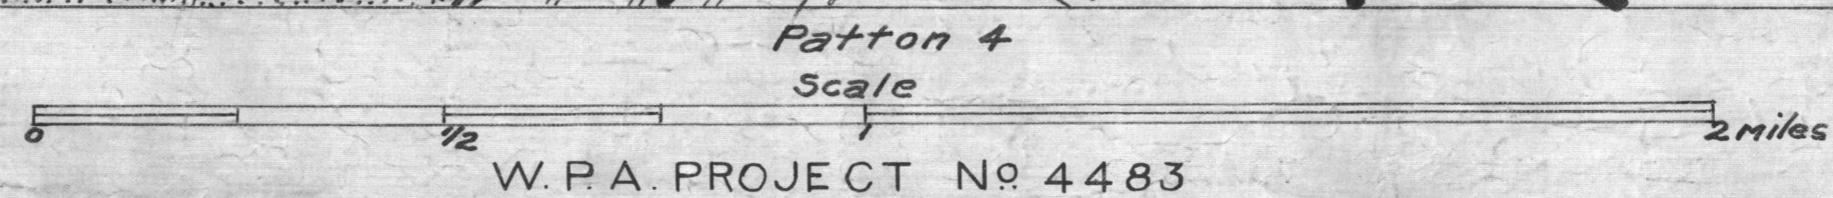

PATTON SHEET No. 1
Lower Freeport Seam - 1f.

PAT 1