


- ACTIVE OIL WELL
- ABANDONED OIL WELL
- ⊛ ACTIVE GAS WELL
- ⊛ ABANDONED GAS WELL
- * ACTIVE OIL & GAS WELL
- * ABANDONED OIL & GAS WELL
- ◇ DRY HOLE
- NO RECORD.

- COUNTY LINE
- TOWNSHIP LINE
- BOROUGH LINE
- 980 COAL CONTOURS
- CROP LINES-SEAM BEING MINED
- CROP LINES-SEAMS NOT BEING MINED

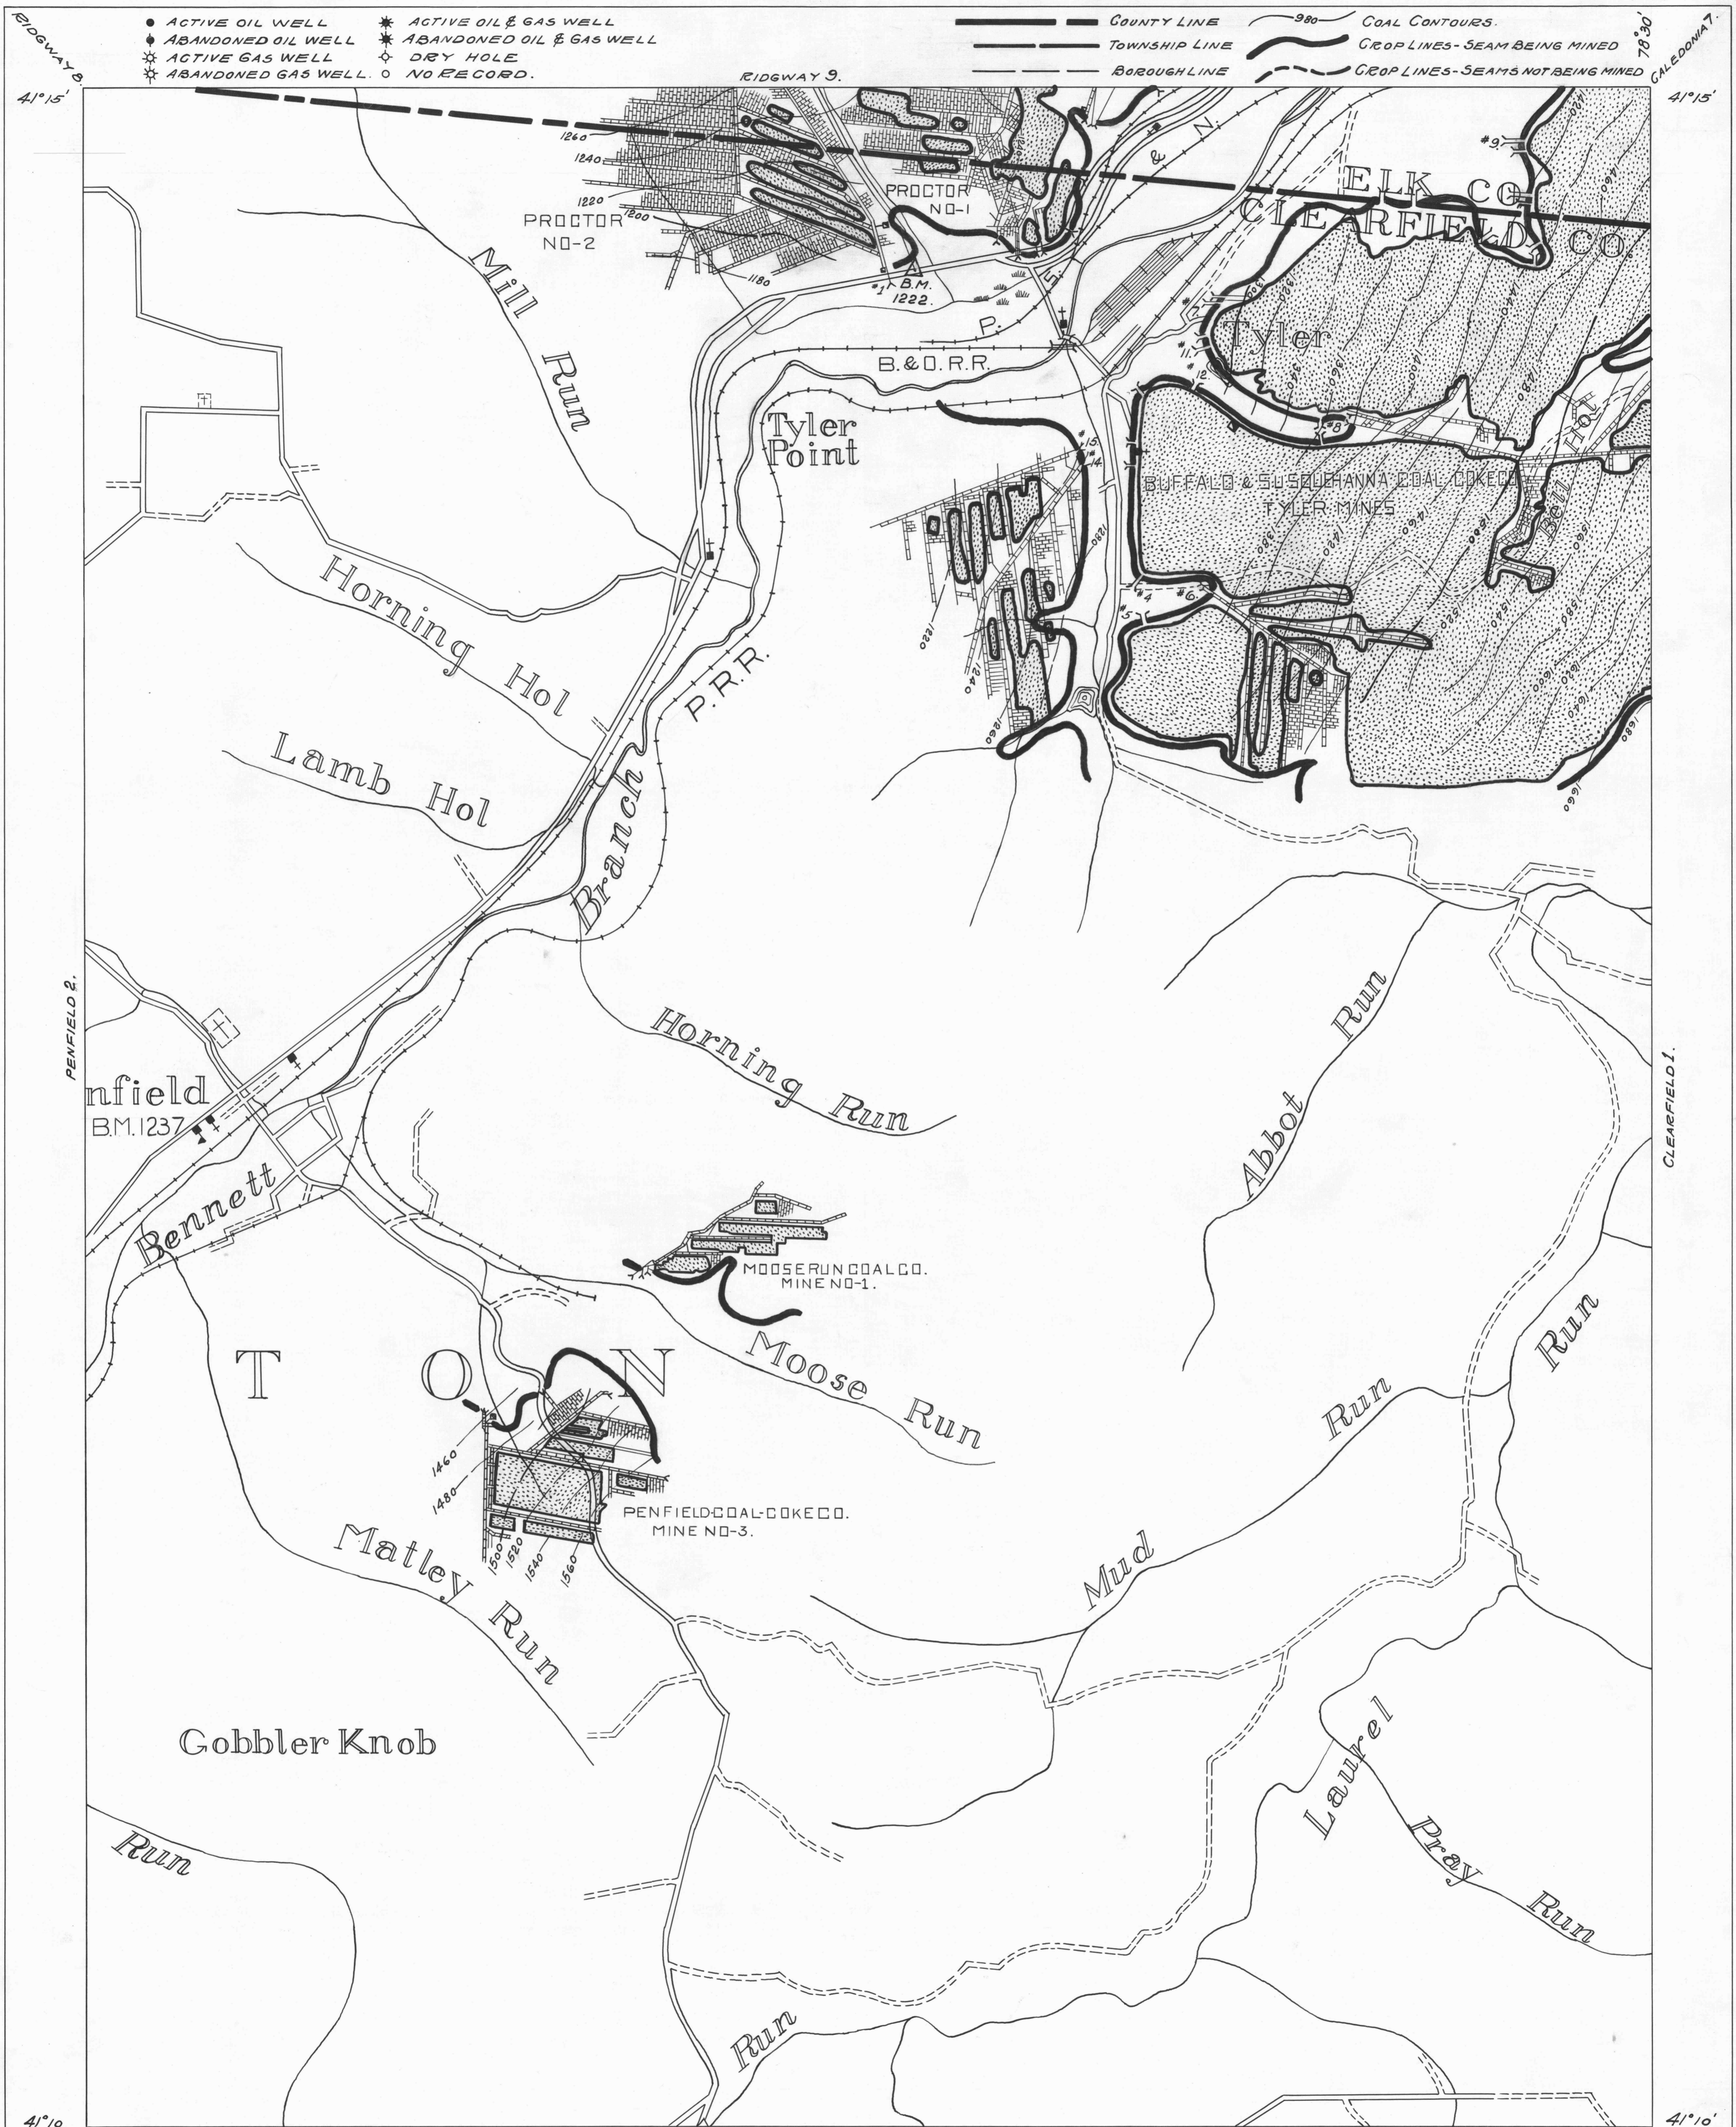

- DRIFT OPENING
- SLOPE OPENING
- SHAFTS
- ▨ BARRIER PILLAR.



W.P.A. PROJECT-19666.

PENFIELD SHEET-3

LOWER KITTANNING SEAM-1K.

RIDGEWAY 8.
 41°15'
 PENFIELD 2.
 41°10'
 PENFIELD 5.
 78°35'

RIDGEWAY 7.
 41°15'
 CLEARFIELD 1.
 41°10'
 CLEARFIELD 2.