



- ACTIVE OIL WELL
- ACTIVE OIL & GAS WELL
- ABANDONED OIL WELL
- ABANDONED OIL & GAS WELL
- ACTIVE GAS WELL
- DRY HOLE
- ABANDONED GAS WELL
- NO RECORD

- COUNTY LINES
- TOWNSHIP LINES
- BOROUGH LINES
- COAL CONTOURS
- CROP LINES-SEAM BEING MINED
- CROP LINES-SEAMS NOT BEING MINED

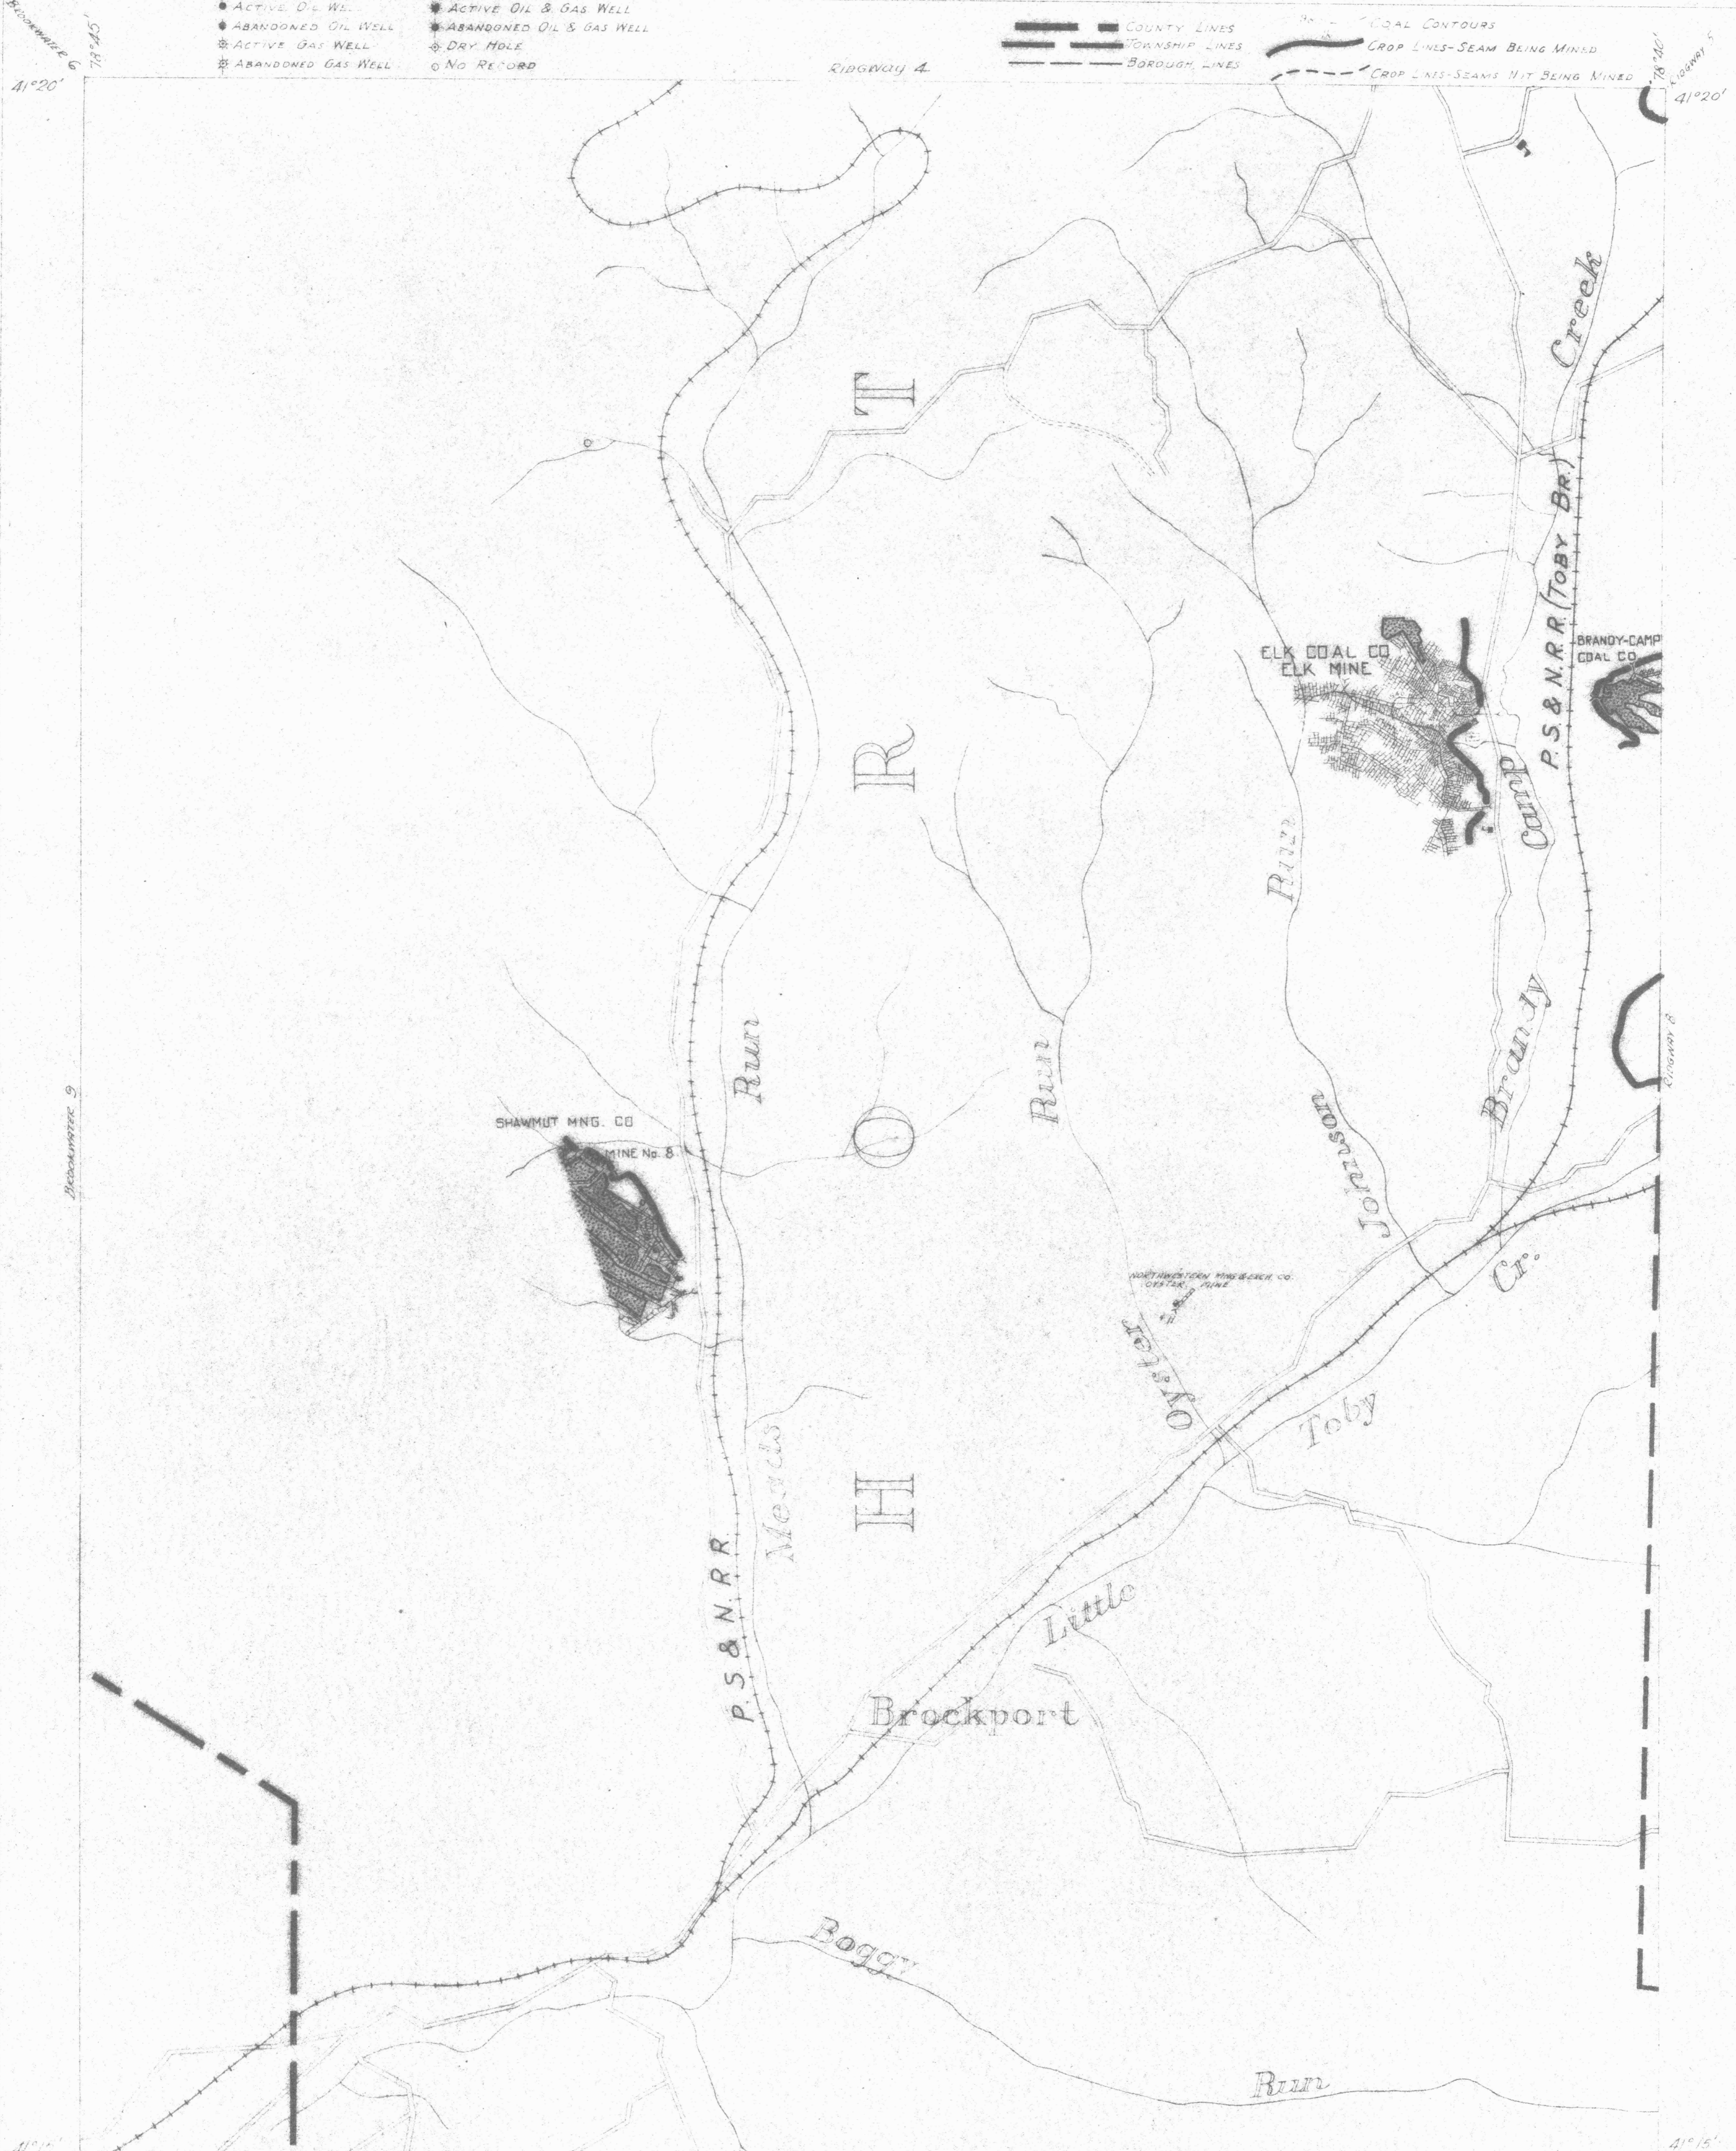

- Y DRIFT OPENING
- Z SLOPE OPENING
- SHALTS
- ▨ BRIDGE PILE

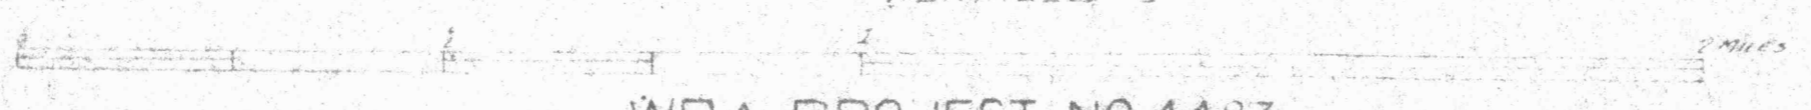

W.P.A. PROJECT NO. 4483

RIDGWAY SHEET No. 7  
LOWER KISTANNING SEAM - 1K

210911