


SHENANGO #1

- ACTIVE OIL WELL
- ◆ ABANDONED OIL WELL
- ⊛ ACTIVE GAS WELL
- ⊛ ABANDONED GAS WELL
- ⊛ ACTIVE OIL & GAS WELL
- ⊛ ABANDONED OIL & GAS WELL
- DRY HOLE
- NO RECORD

- COUNTY LINES
- TOWNSHIP LINES
- BOROUGH LINES
- SURFACE CONTOURS
- 980 COAL CONTOURS
- CRAP LINES - SEAM BEING MINED
- CRAP LINES - SEAMS NOT BEING MINED

Linesville Pa. 7


Linesville Pa. 8

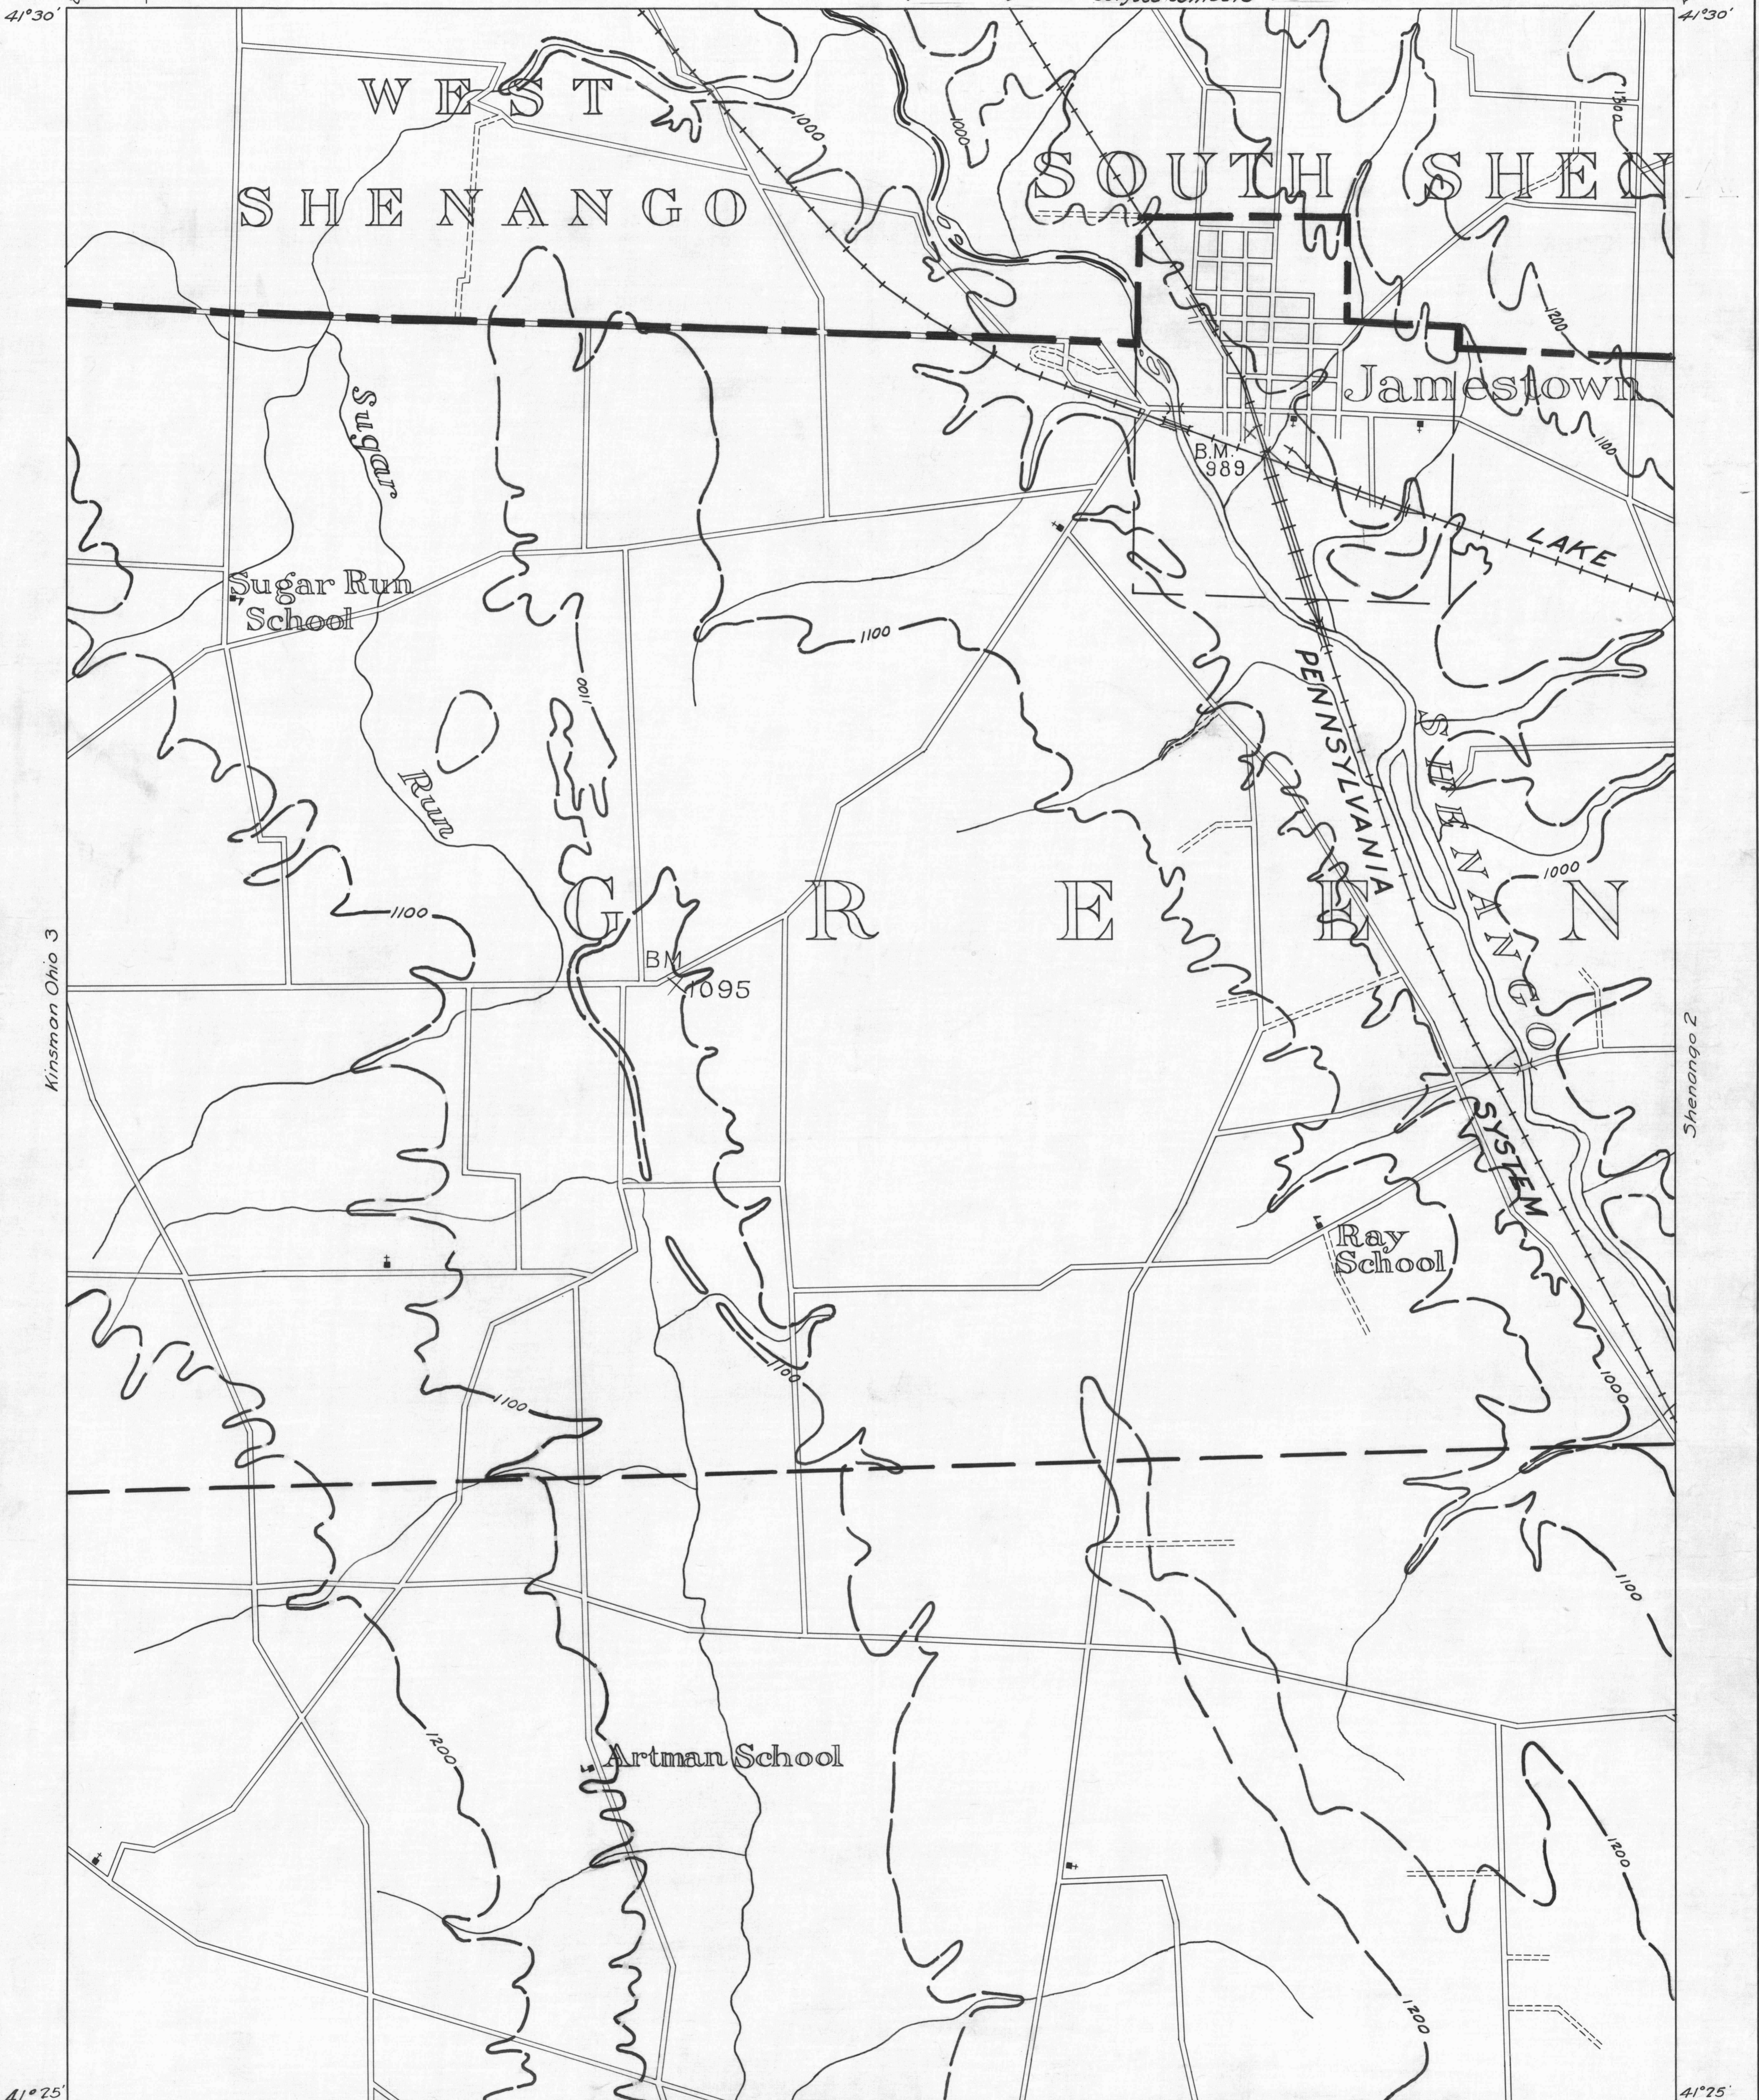

Kinsman Ohio 3

Shenango 2

- Y DRIFT OPENING
- Z SLOPE OPENING
- SHAFTS
- ▨ BARRIER PILLAR

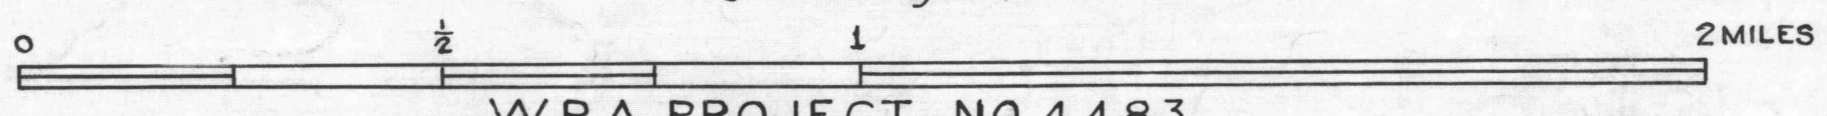

W.P.A. PROJECT NO 4483

SHENANGO SHEET No.1

TRACED BY - P.F. FOX 4/23/34
 LETTERED BY - T.W.M. 4/24/34
 CHECKED BY

SHE-1