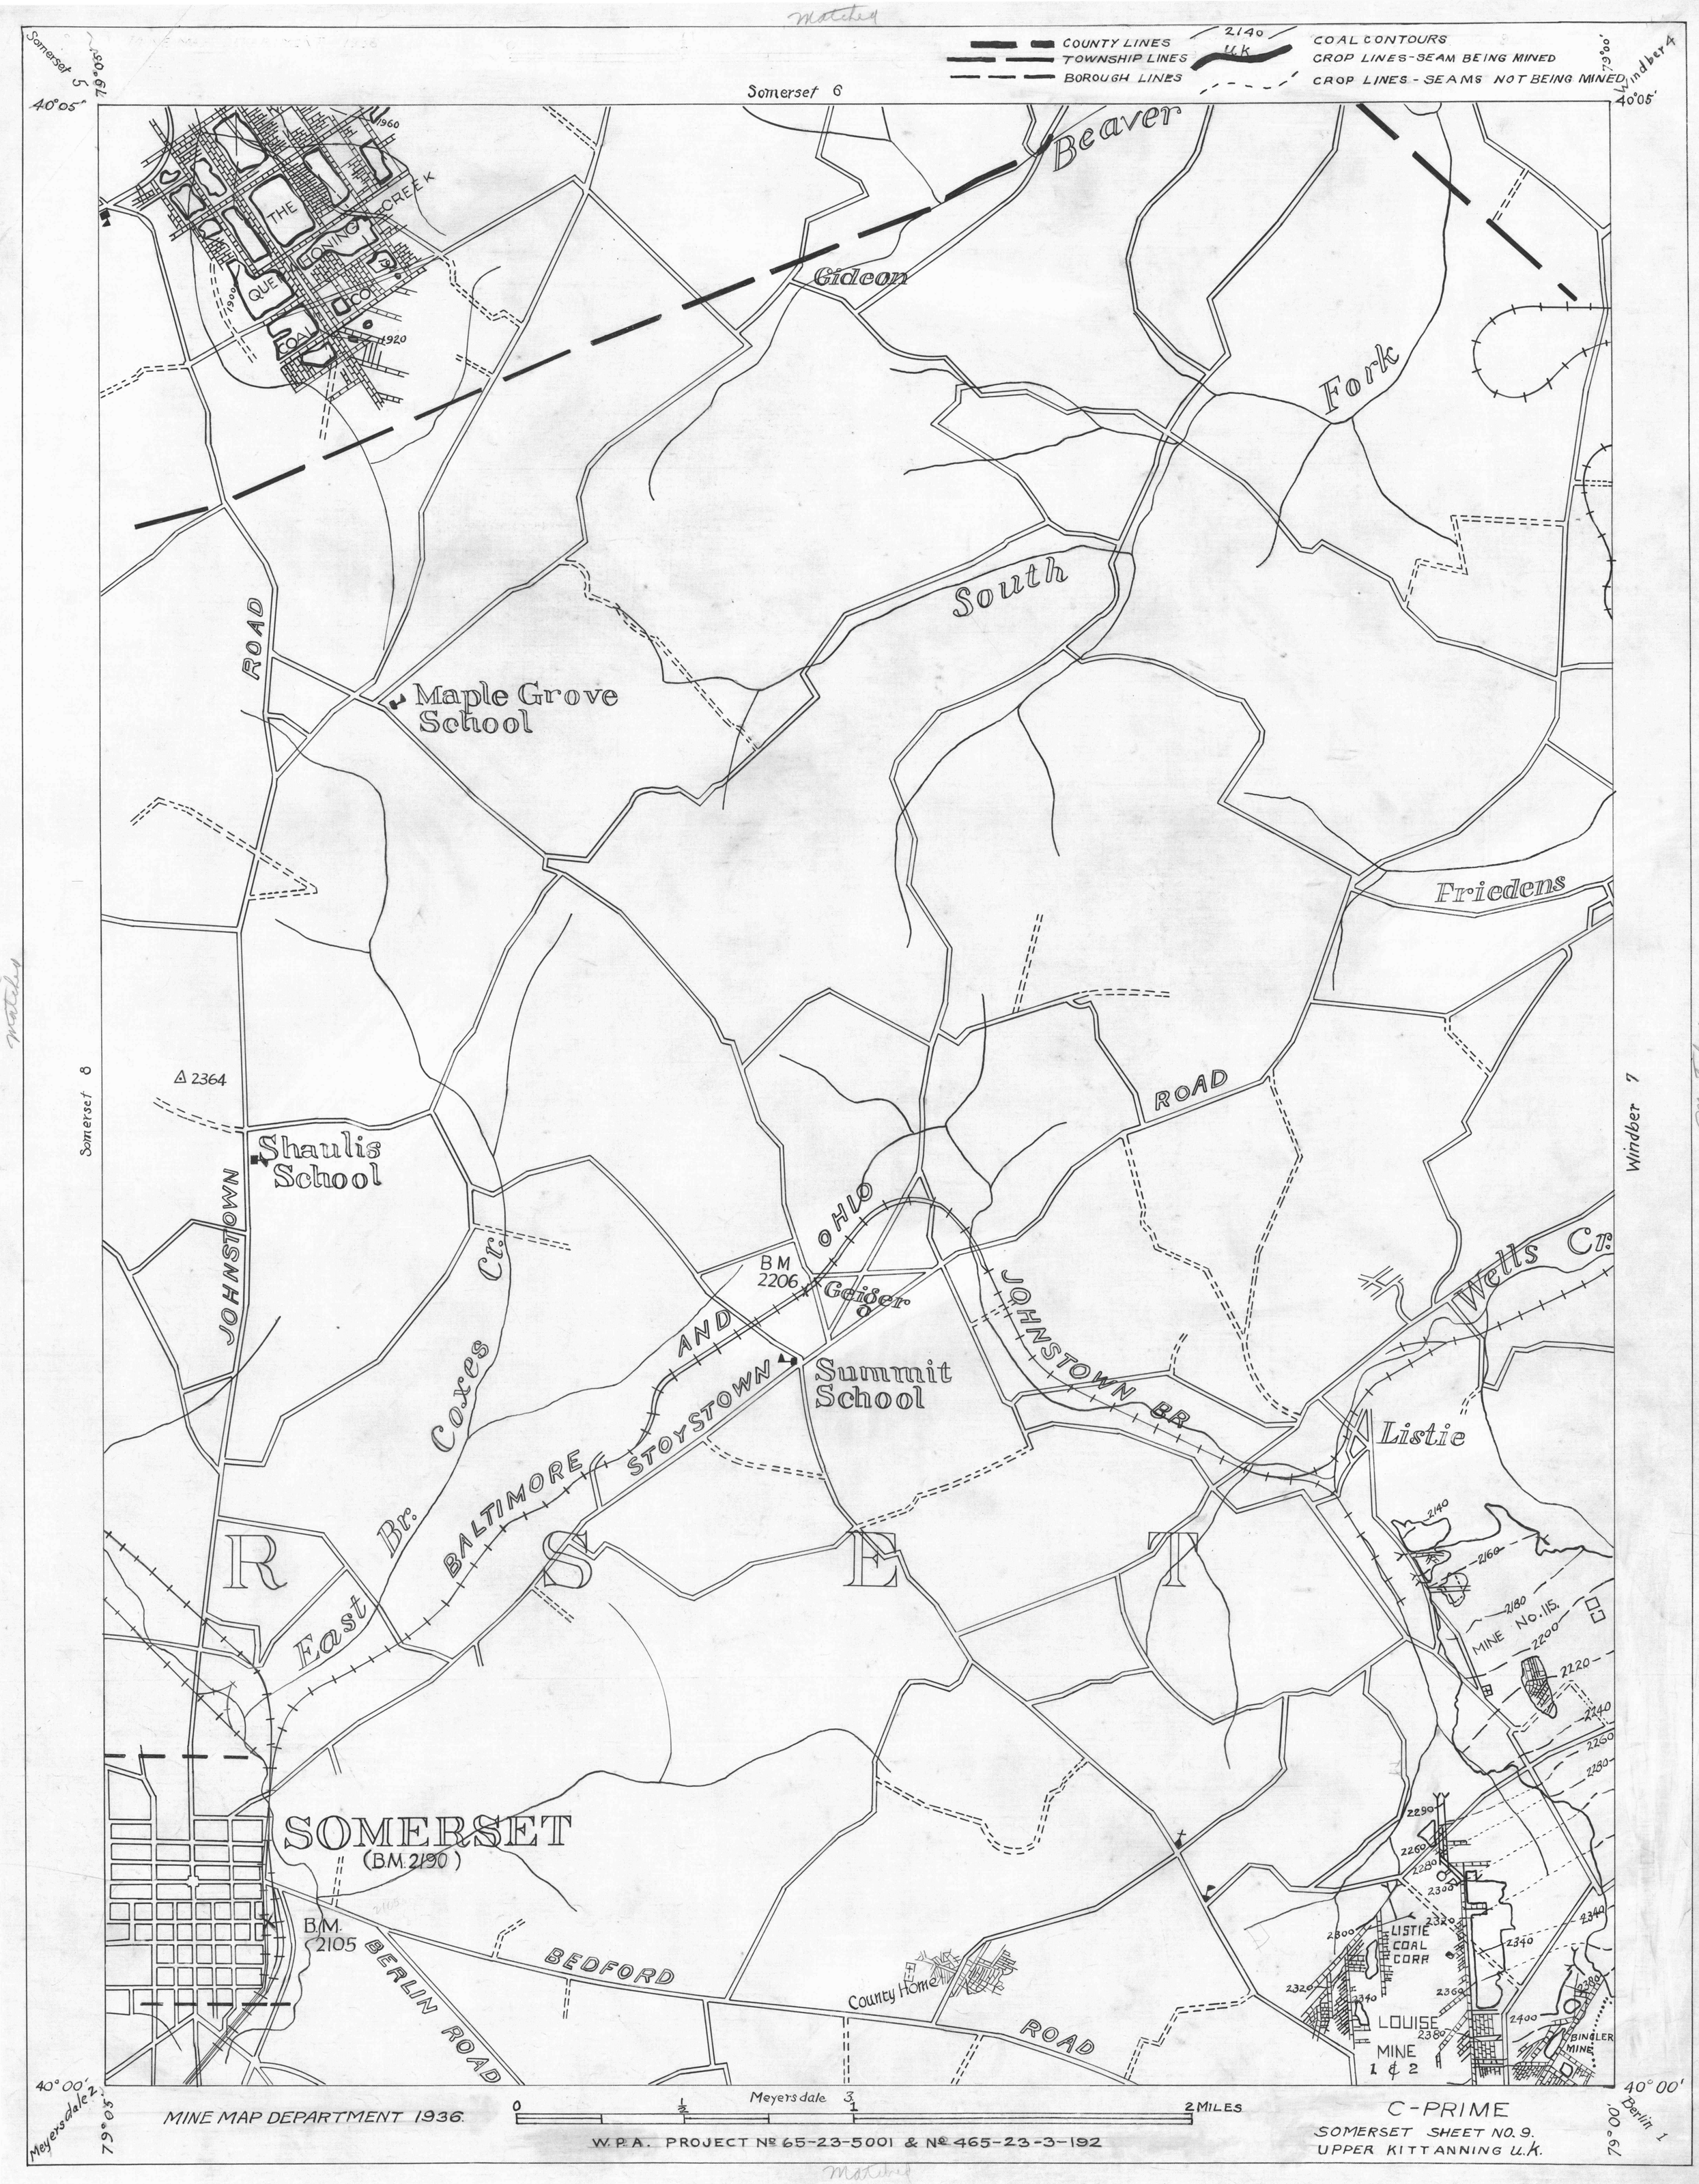
COUNTY LINES
TOWNSHIP LINES
BOROUGH LINES
COAL CONTOURS
CROP LINES-SEAM BEING MINED
CROP LINES - SEAMS NOT BEING MINED
Somerset 5
Somerset 6
Somerset 8
Windber 4
Windber 7
Meyersdale 2
Berlin 1
40°05'
40°00'
79°00'
79°05'
THE QUEMONING COAL CO.
QUEMONING CREEK
Beaver
Gideon
Fork
South
ROAD
Maple Grove School
Friedens
Shaulis School
JOHNSTOWN
Coxes Cr.
BM 2206
Geiger
OHIO AND
STOYSTOWN
Summit School
JOHNSTOWN BR
Wells Cr.
Listie
BALTIMORE
East Br.
R S E T
MINE No. 115.
SOMERSET
(B.M. 2190)
B.M. 2105
BERLIN ROAD
BEDFORD
County Home
ROAD
LISTIE COAL CORP
LOUISE MINE 1 & 2
BINGLER MINE
Meyersdale 3
0
1/2
1
2 MILES
MINE MAP DEPARTMENT 1936.
W.P.A. PROJECT № 65-23-5001 & № 465-23-3-192
C-PRIME
SOMERSET SHEET NO. 9.
UPPER KITTANNING U.K.