


- ACTIVE OIL WELL
- ABANDONED OIL WELL
- ★ ACTIVE GAS WELL
- ★ ABANDONED GAS WELL

- ★ ACTIVE OIL & GAS WELL
- ★ ABANDONED OIL & GAS WELL
- ◇ DRY HOLE
- NO RECORD

- COUNTY LINES
- TOWNSHIP LINES
- BOROUGH LINES
- 980 COAL CONTOURS
- CROP LINES—SEAM BEING MINED
- CROP LINES—SEAMS NOT BEING MINED

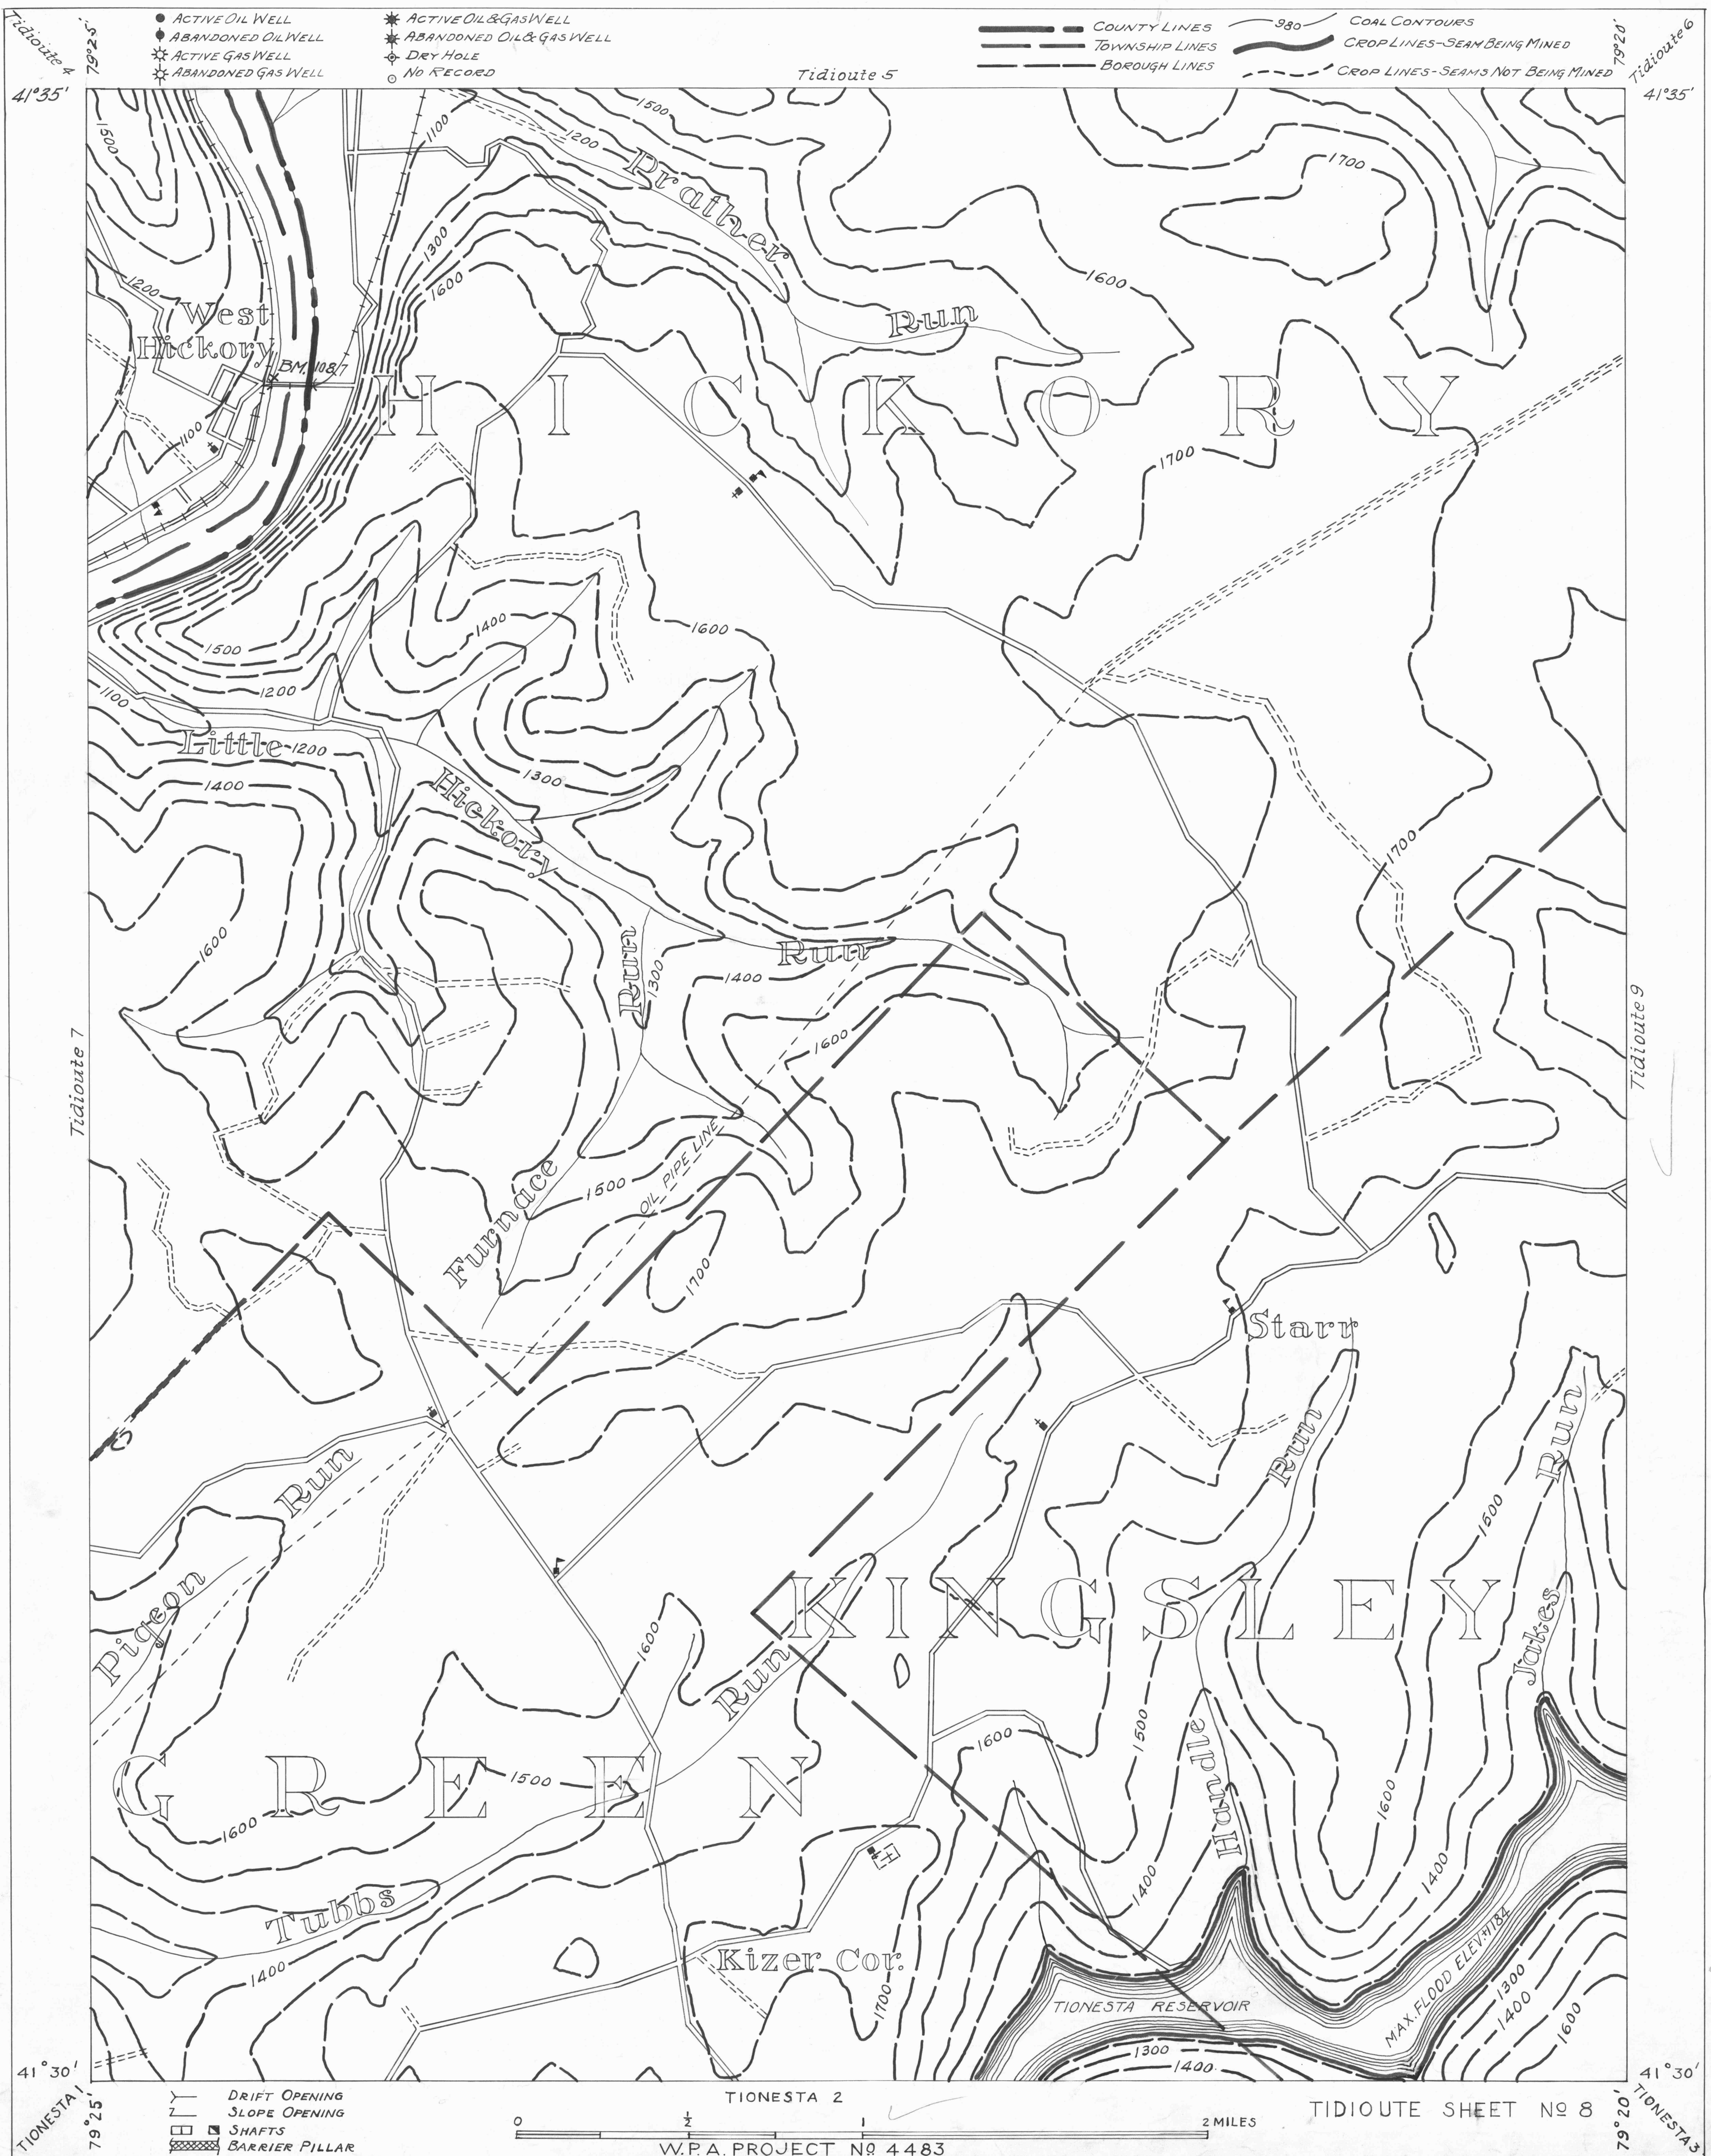

- DRIFT OPENING
- SLOPE OPENING
- SHAFTS
- ▨ BARRIER PILLAR

TIONESTA 2
 0 1/2 1 2 MILES
 W.P.A. PROJECT NO 4483

TIDIOUTE SHEET NO 8

TIONESTA 1
 79° 25'
 41° 35'
 Tidioute 4
 Tidioute 5
 Tidioute 6
 Tidioute 7
 Tidioute 8
 Tidioute 9
 TIONESTA 2
 79° 20'
 41° 30'