

- ACTIVE OIL WELL
- ABANDONED OIL WELL
- ⊙ ACTIVE GAS WELL
- ⊙ ABANDONED GAS WELL

- ★ ACTIVE OIL & GAS WELL
- ★ ABANDONED OIL & GAS WELL
- DRY HOLE
- NO RECORD

- COUNTY LINES
- TOWNSHIP LINES
- BOROUGH LINES


- 380 GOAL CONTOURS
- CROP LINES - SEAM BEING MINED
- - - CROP LINES - SEAMS NOT BEING MINED

SOMERSET 4
40°15'


WINDBER 5
40°15'

SOMERSET

WINDBER 8

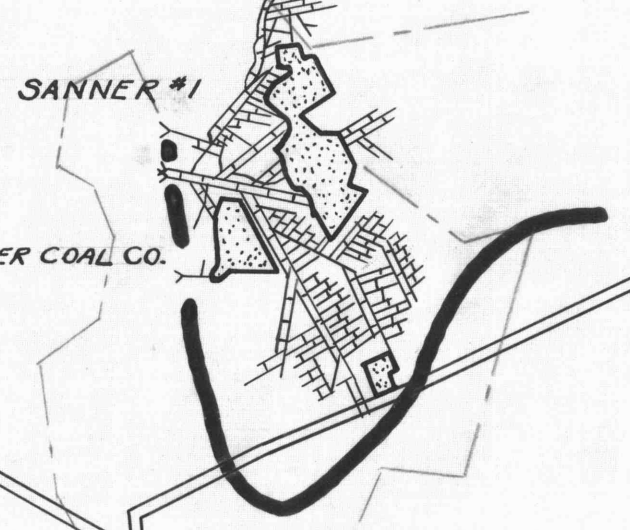

- DRIFT OPENING
- SLOPE OPENING
- SHAFTS
- ▨ BARRIER PILLAR

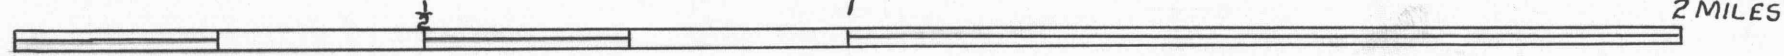

W. P. A. PROJECT NO 25734

WINDBER - SHEET NO 7

UPPER KITTANNING SEAM - UK.

WINDBER - 7 UK

FINISH LETTERING

MEYERSDALE
79°00'

BERLIN 2
40°00'